




**SOUTH ELEVATION**  
1 : 200

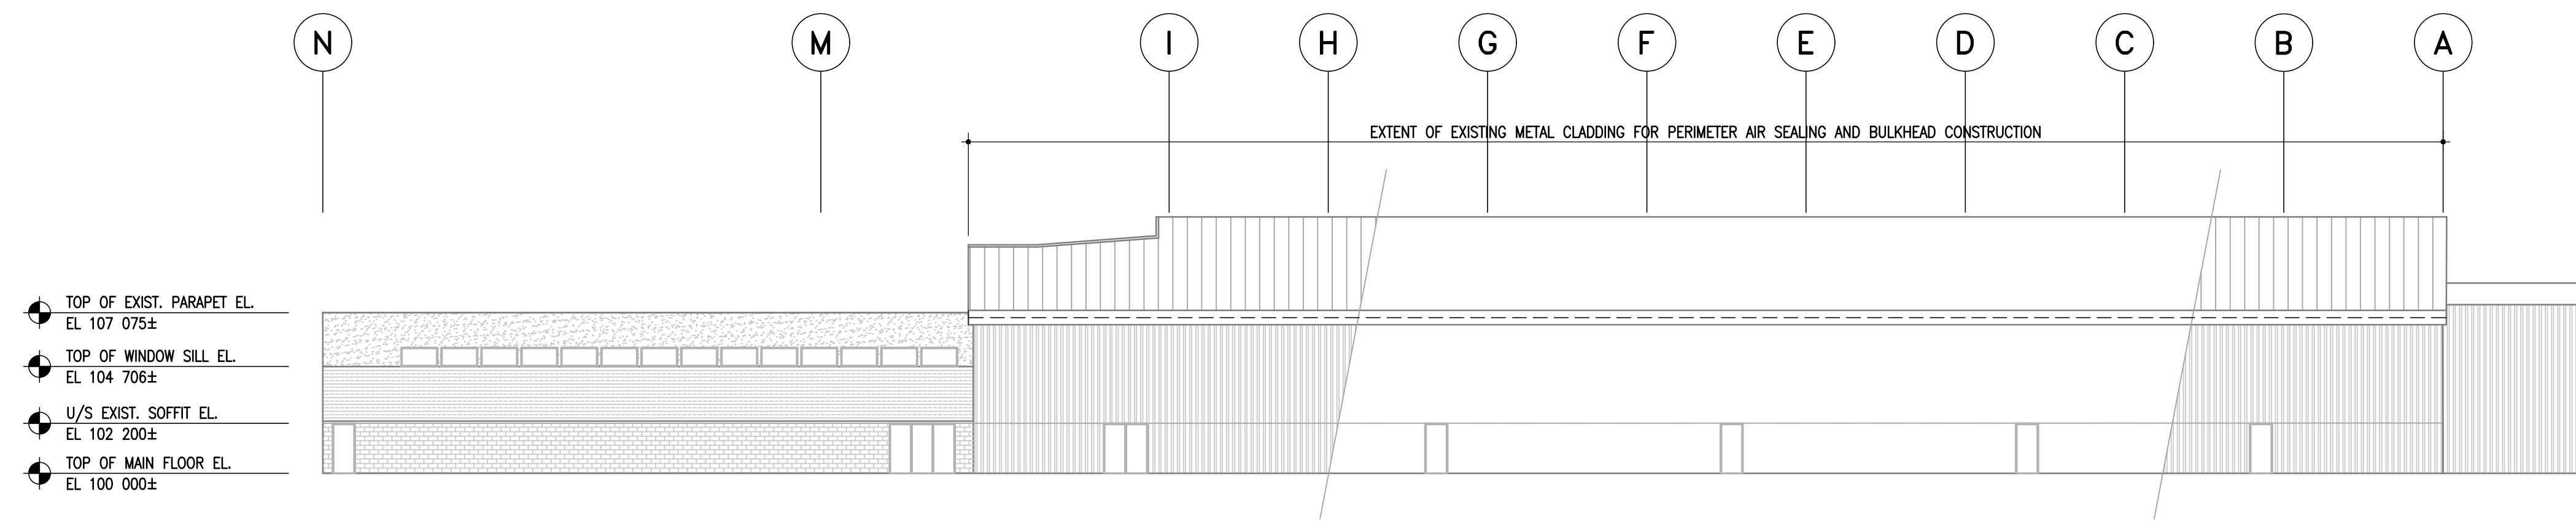

**NORTH ELEVATION**  
1 : 200

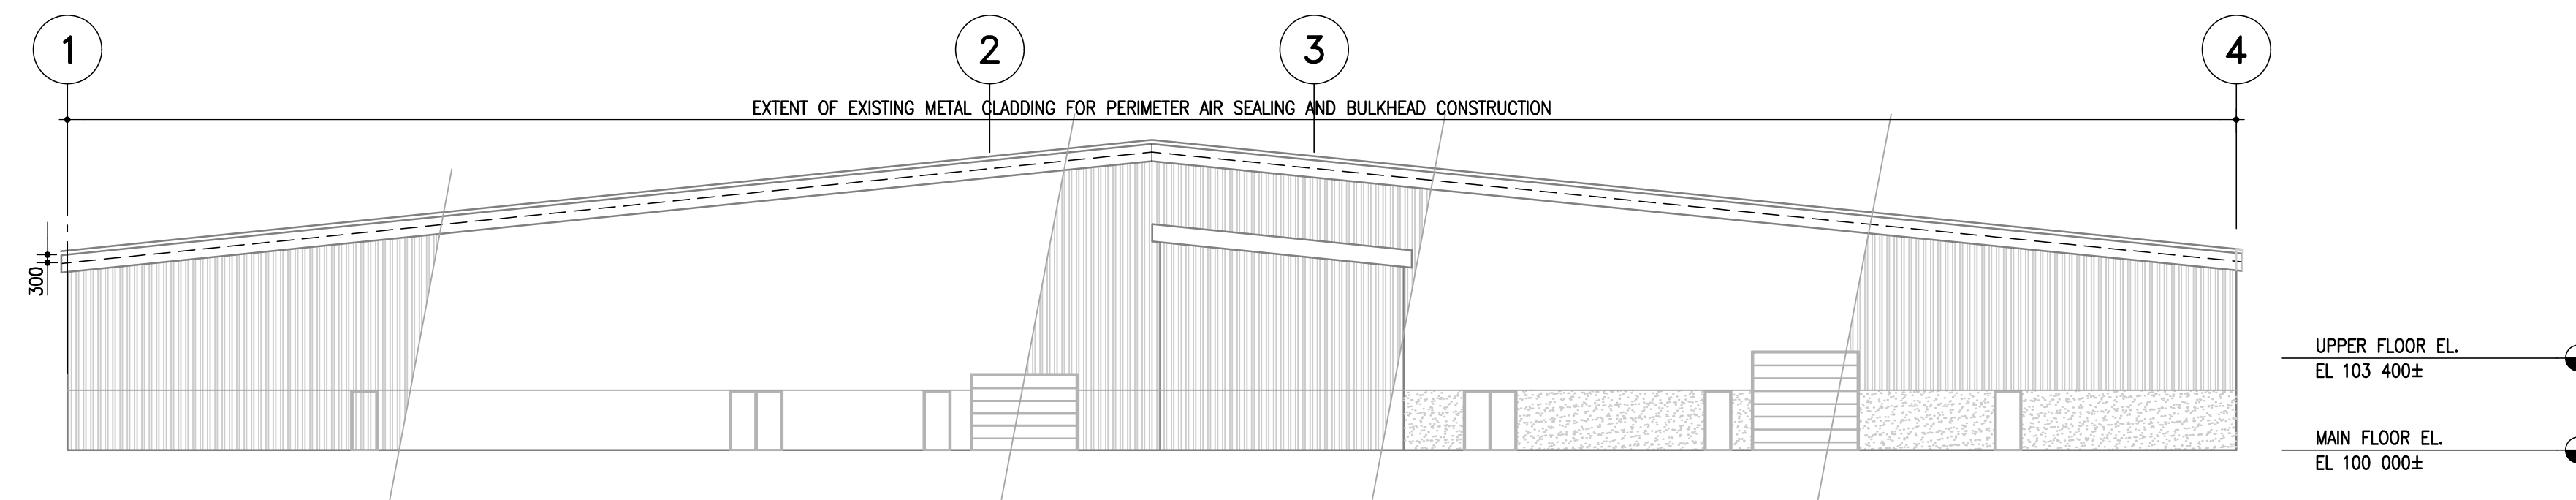

**WEST ELEVATION**  
1 : 200

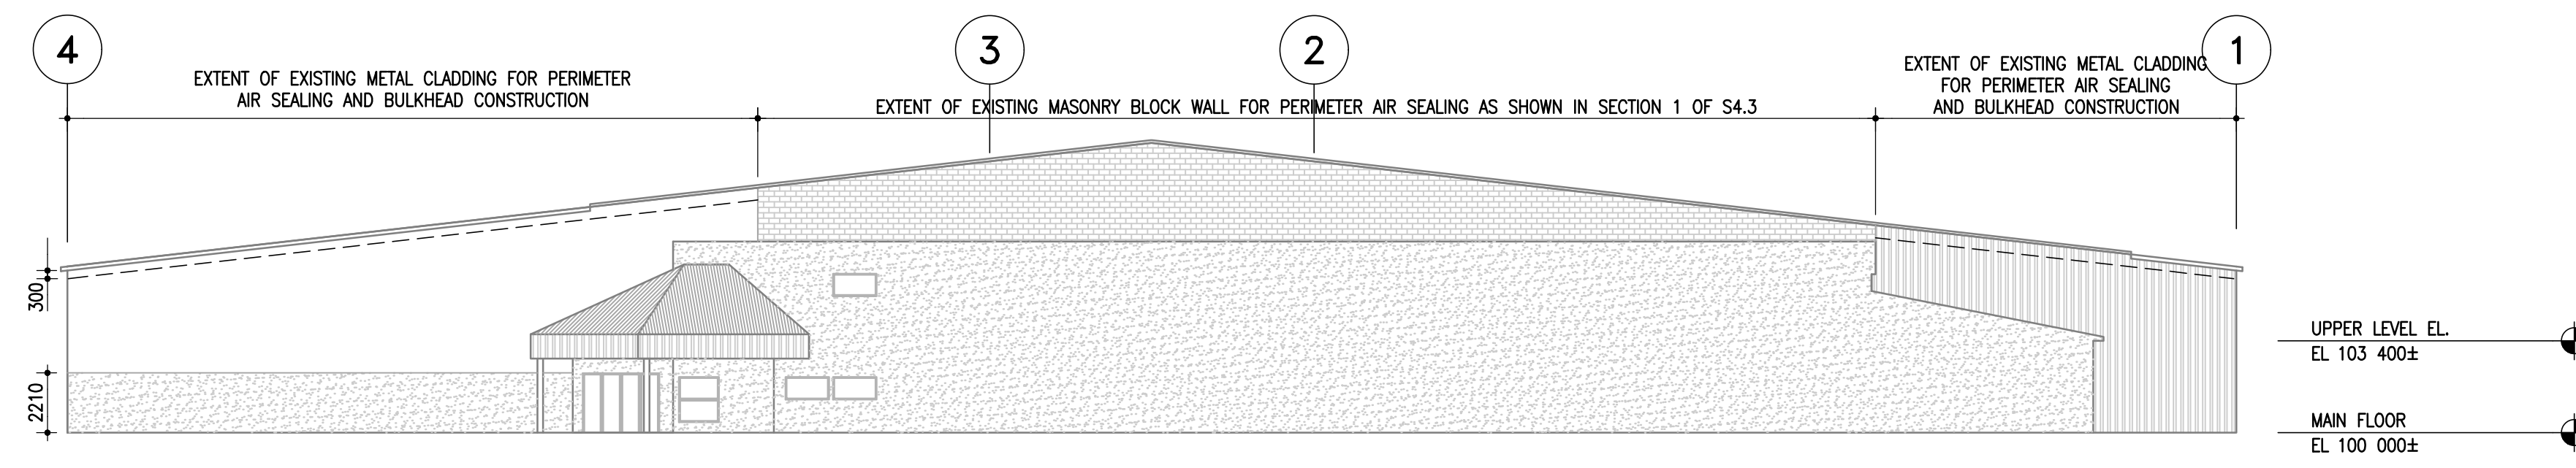

**EAST ELEVATION**  
1 : 200

The General Contractor shall check & verify all dimensions and report any errors or omissions to the designers.

No.	Date	Issue/Revision	By
1	2017-04-04	ADDENDUM #4	CMR
0	2017-03-03	ISSUED FOR CONSTRUCTION	CMR

**APEGM**  
Certificate of Authorization  
Crosier Kilgour & Partners Ltd.  
No. 235 Date: 2017-03-03



Consultant

300-275 Carlton Street  
Winnipeg, Manitoba R3C 5R6  
T 204. 943. 7501  
F 204. 943. 7507

**Crosier Kilgour & Partners Ltd.**  
CONSULTING STRUCTURAL ENGINEERS

Project  
**DAKOTA COMMUNITY CENTRE**  
BUILDING ENVELOPE UPGRADES  
  
1188 DAKOTA STREET  
WINNIPEG, MB

Sheet Title  
**ELEVATIONS**

File	2016-0794	Date	2017-01-26
Design	CMR	Drawn	RJM

Revision	Sheet No.
1	S3.1