


QUANTITIES FOR SURFACE WORKS

1 - CIP CONCRETE STANDARD	117.00 sq m
2 - ENDICOTT PAVERS DARK IRONSPOT	90.70 sq m
3 - ENDICOTT PAVERS DARK IRONSPOT INDICATOR STRIP	26.90 sq m
4 - CONCRETE UNDER PAVERS	117.60 sq m
5 - COLOR CONCRETE ARTEVIA STANDARD SLATE	16.00 sq m

1 Site Plan
Scale: 1/16" = 1'-0"

Note: This drawing includes contextual information provided by HTFC Planning & Design: Landscaped Design of Lily st., including existing curb, existing building and lights.
(5515038-Base Plan (Lily Street).dwg
5515038-Existing Utilities.dwg)

INTERP. PANEL ADJUSTMENT
CHANGES IN FLOORING SURFACES
SURFACE QUANTITIES 2017/01/27
ISSUED FOR CONSTRUCTION 2016/11/28
ISSUED FOR PRICING 2016/10/20

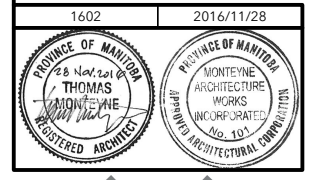

1919 MARQUEE
Winnipeg, Manitoba
Intersection Lily St & Market Ave
SITE PLAN

A1.0