


A B01 **PARTIAL PLAN**
SCALE: 1:30

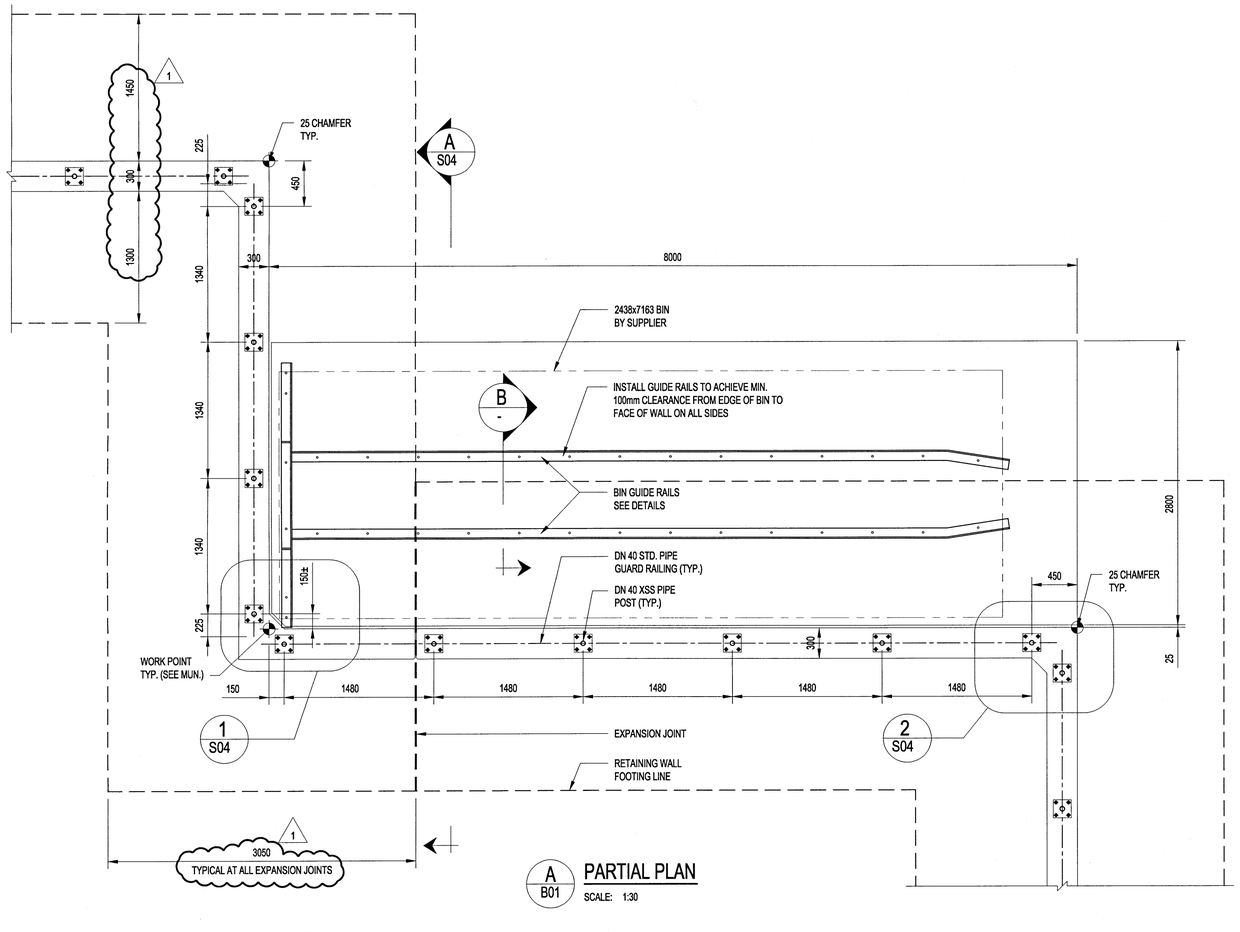


1 - **BIN GUIDE RAILS**
SCALE: 1:20




4 S02 **DETAIL**
SCALE: 1:10

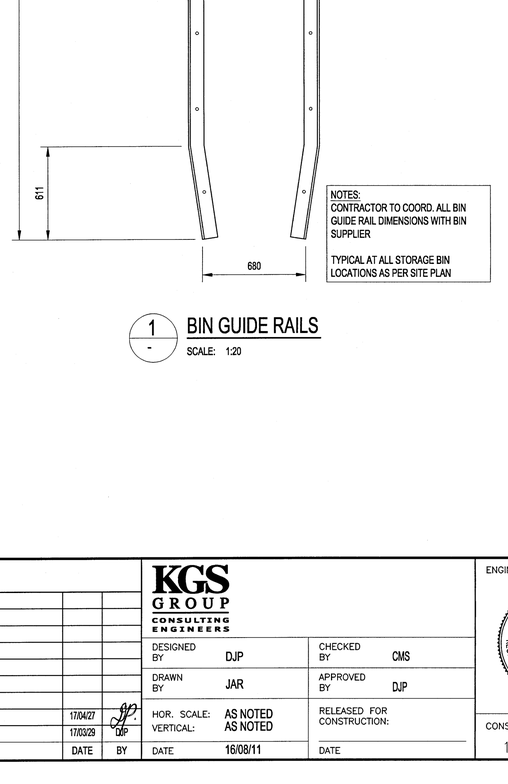


2 - **TYPICAL PILE DETAIL**
SCALE: N.T.S.

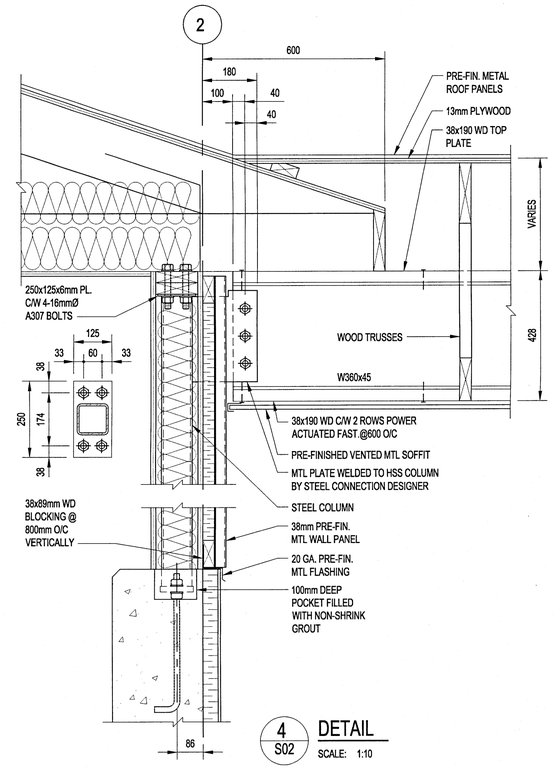


3 - **DETAIL - BOLLARD**
SCALE: 1:25

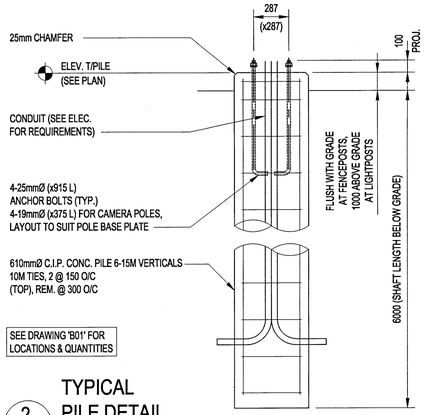


B - **SECTION**
SCALE: 1:10

LOCATION APPROVED
UNDERGROUND STRUCTURES

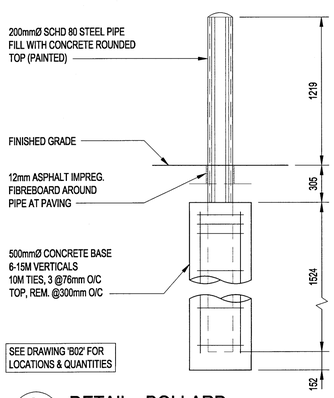SUPV. U/G STRUCTURES COMMITTEE — DATE

NOTE:
LOCATION OF UNDERGROUND STRUCTURES AS SHOWN ARE BASED ON THE BEST INFORMATION AVAILABLE BUT NO GUARANTEE IS GIVEN THAT ALL EXISTING UTILITIES ARE SHOWN OR THAT THE GIVEN LOCATIONS ARE EXACT. CONFIRMATION OF EXISTENCE AND EXACT LOCATION OF ALL SERVICES MUST BE OBTAINED FROM THE INDIVIDUAL UTILITIES BEFORE PROCEEDING WITH CONSTRUCTION.

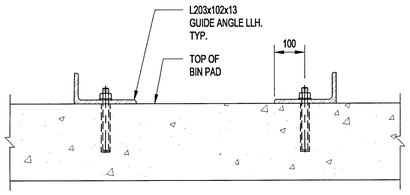B.M. ELEV.

| NO. | REVISIONS | DATE | BY |
|---|---|---|---|
| 1 | RE-ISSUED FOR TENDER | 17/04/27 | DJP |
| 0 | ISSUED FOR TENDER | 17/03/29 | DJP |

KGS GROUP CONSULTING ENGINEERS

| | | | |
|---|---|---|---|
| DESIGNED BY | DJP | CHECKED BY | CMS |
| DRAWN BY | JAR | APPROVED BY | DJP |
| HOR. SCALE: | AS NOTED | RELEASED FOR CONSTRUCTION: | |
| VERTICAL: | AS NOTED | | |
| DATE | 16/08/11 | DATE | |

ENGINEER'S SEAL
PROVINCE OF MANITOBA — D.J. PETRAK — 27 April 2017 — REGISTERED PROFESSIONAL ENGINEER

CONSULTANT DRAWING NO.
16-0107-010

Winnipeg
THE CITY OF WINNIPEG
WATER AND WASTE DEPARTMENT

PROJECT TITLE
4R WINNIPEG DEPOT
EAST WINNIPEG COMMUNITY RESOURCE RECOVERY CENTRE

SECTIONS AND DETAILS

| SHEET | OF |
|---|---|
| 19 | 41 |

COMPUTER FILE NAME
16-0107-010

CONSULTANT DRAWING NUMBER
S03

16-0107-010\16-0107-010_S03.dwg