

ROOF FRAMING PLAN

1:100

ROOF DESIGN LOADING

DESIGN SNOW LOAD 1.72kPa + SNOW BUILD UP NOTED ON PLAN
 DESIGN DEAD LOAD 1.30kPa

FLOOR NOTES:

- GRIDS ARE CENTER LINE STEEL AND PILES OR FACE OF MASONRY WALL & CONCRETE BEAMS UNLESS NOTED OTHERWISE
- ALL DIMENSIONS ARE TO CENTRE LINE OF STEEL, FACE OF CONCRETE, CENTRE LINE OF PILE, OR FACE OF MASONRY WALL UNLESS NOTED OTHERWISE
- 38x0.76 STEEL ROOF DECK TYPICAL UNLESS NOTED ON PLAN
- TOP OF STEEL BEAMS TO BE AT EL. 103.550 TYPICAL UNLESS NOTED ON PLAN
- STEEL JOIST NOTED 'S.J.' TO BE TRUTTED TO COLUMN OR BEAM AT EACH END

1 2017-08-25 ADDENDUM 1
 0 2017-06-30 ISSUED FOR CONSTRUCTION
 No. DATE REVISION/ISSUANCE


Seal

x | architecture inc.
 100 Fort Street, Suite 103 Winnipeg, MB R2C 1C7 204 943 2010

Architect

Engineer

300-275 Carlton Street
 Winnipeg, Manitoba R3C 5R6
 T 204. 943. 7501
 F 204. 943. 7507
 2016-04-30

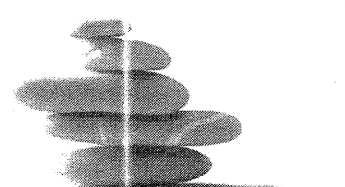

Crosier Kilgour & Partners Ltd.
 CONSULTING STRUCTURAL ENGINEERS

Project BID OPPORTUNITY 450-2017

**KILDONAN PARK
 MAINTENANCE BUILDING**

Sheet Title

ROOF FRAMING PLAN

Project No.

1559

Date

2017-08-25

Sheet

S2.3