



**PHASE 2 STAGE 1**  
DATES AS PER C701

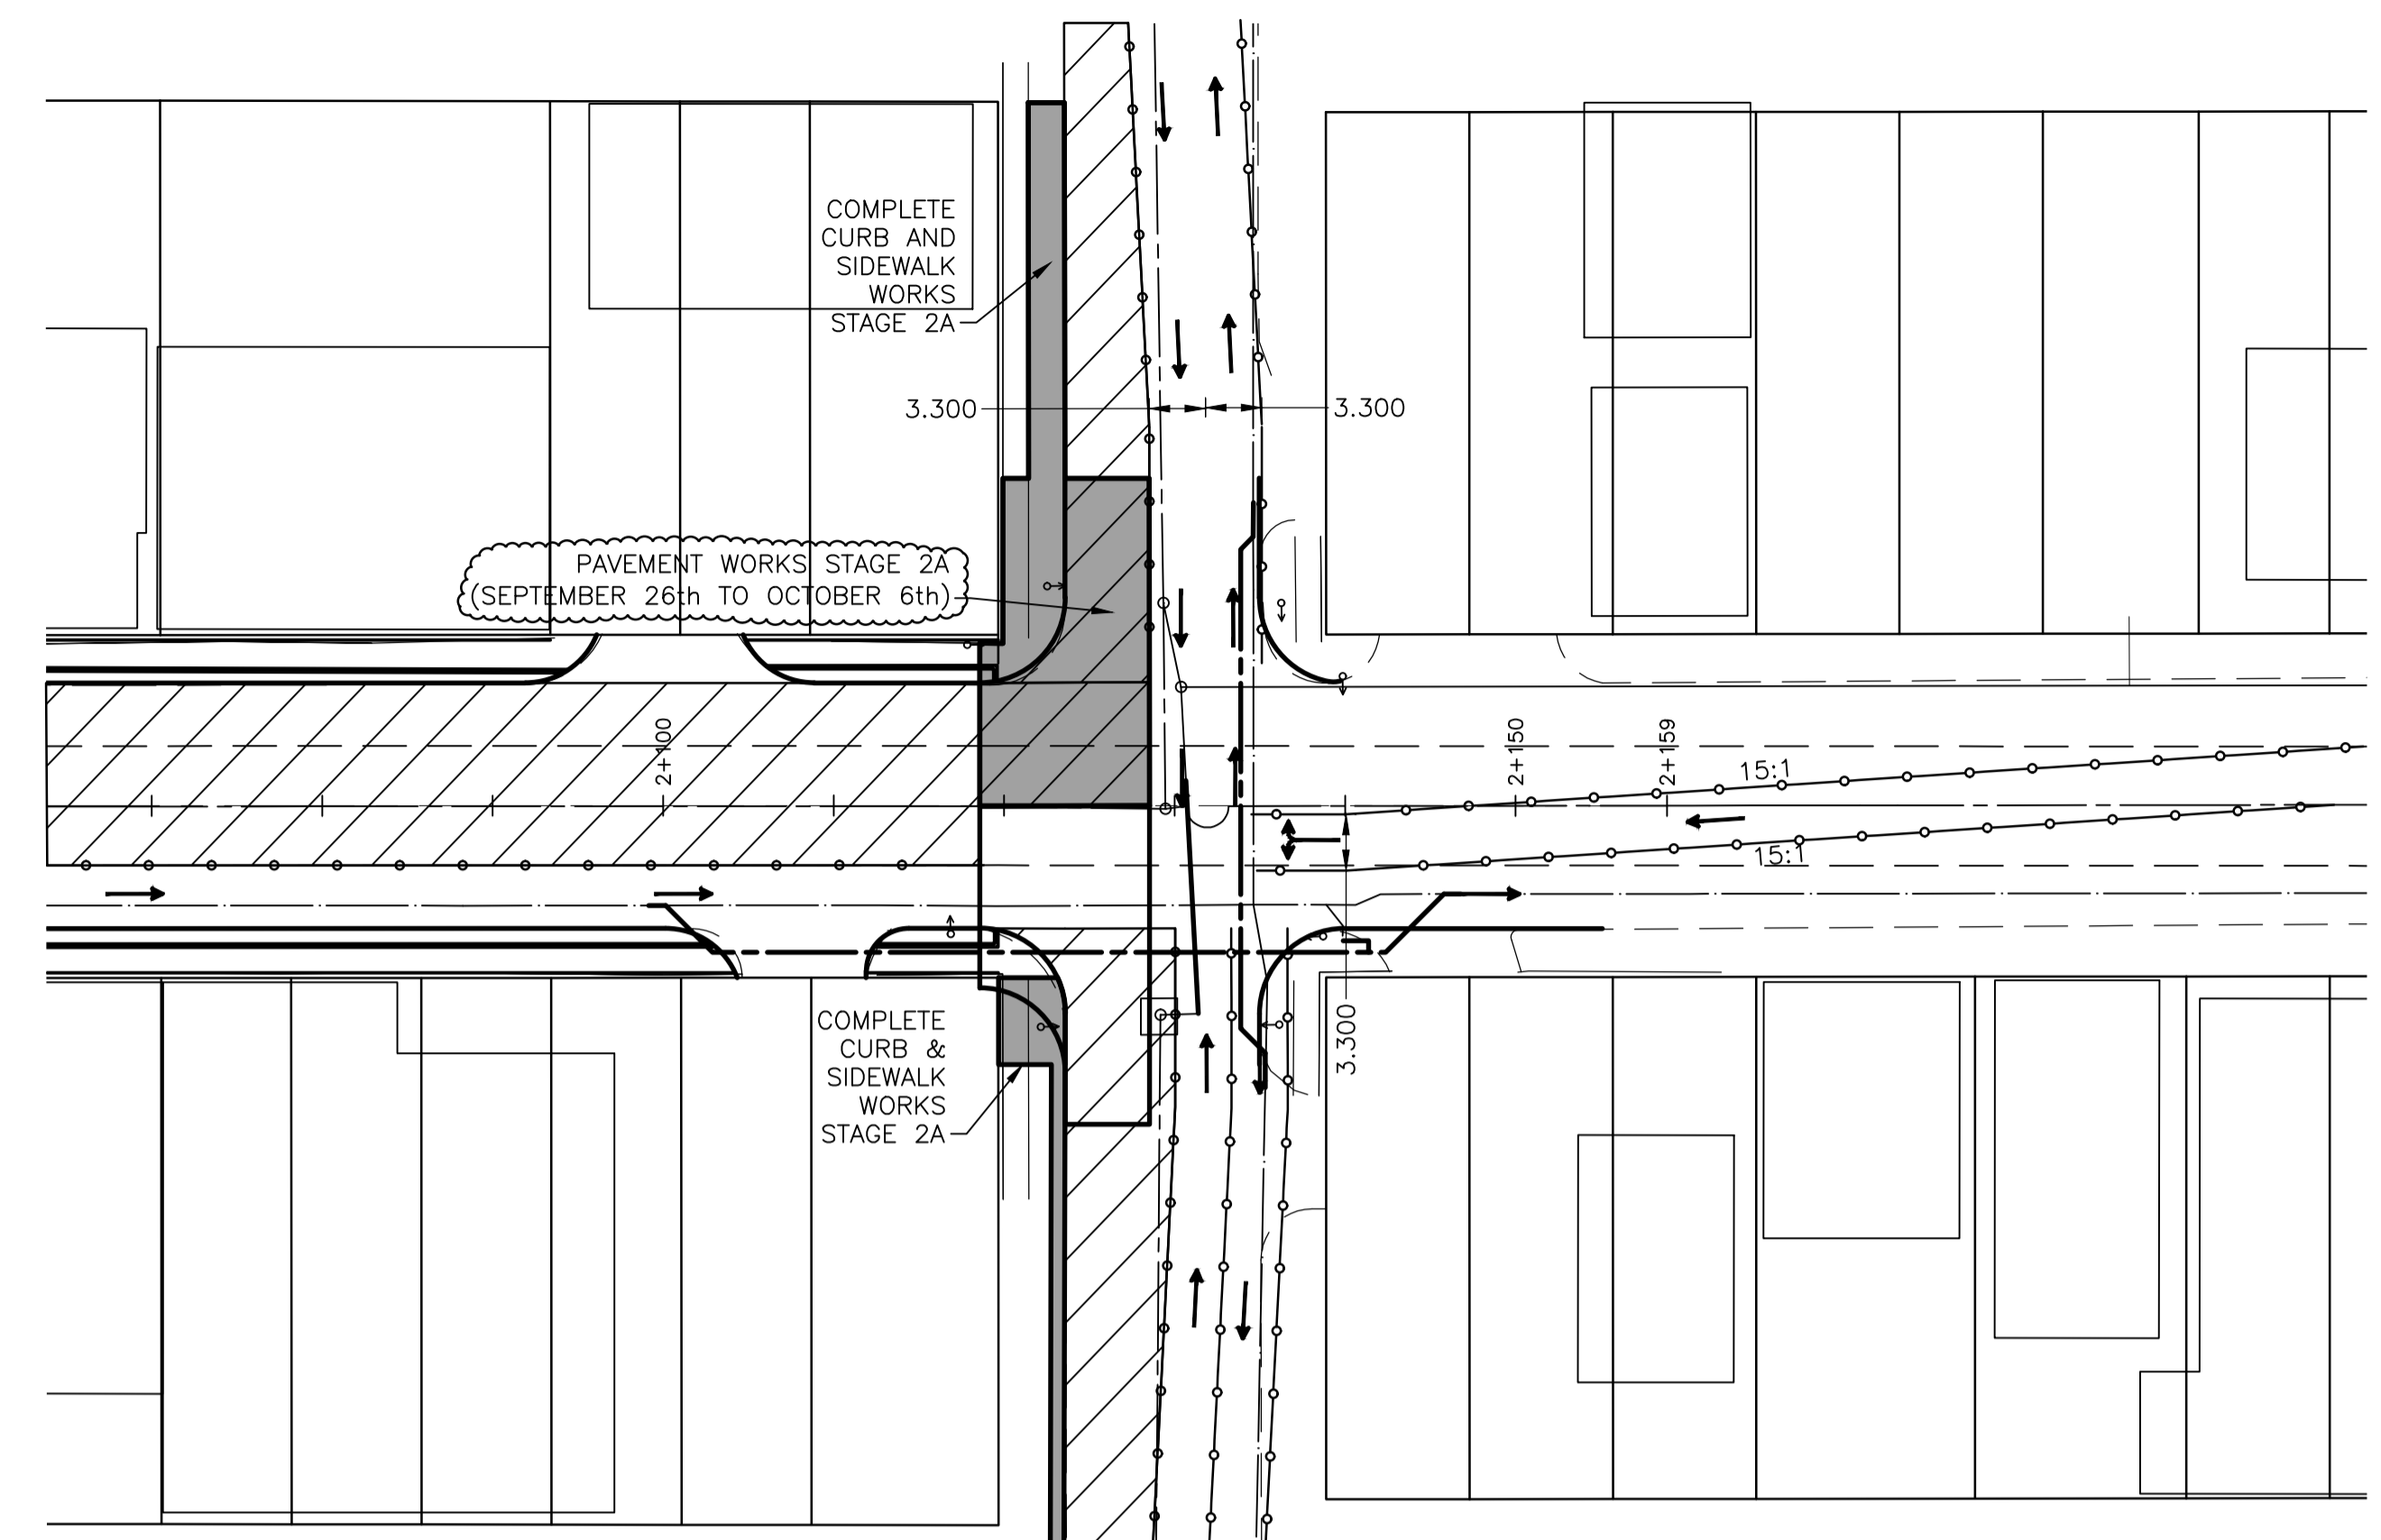

**PHASE 2 STAGE 2A**  
DATES AS PER C702

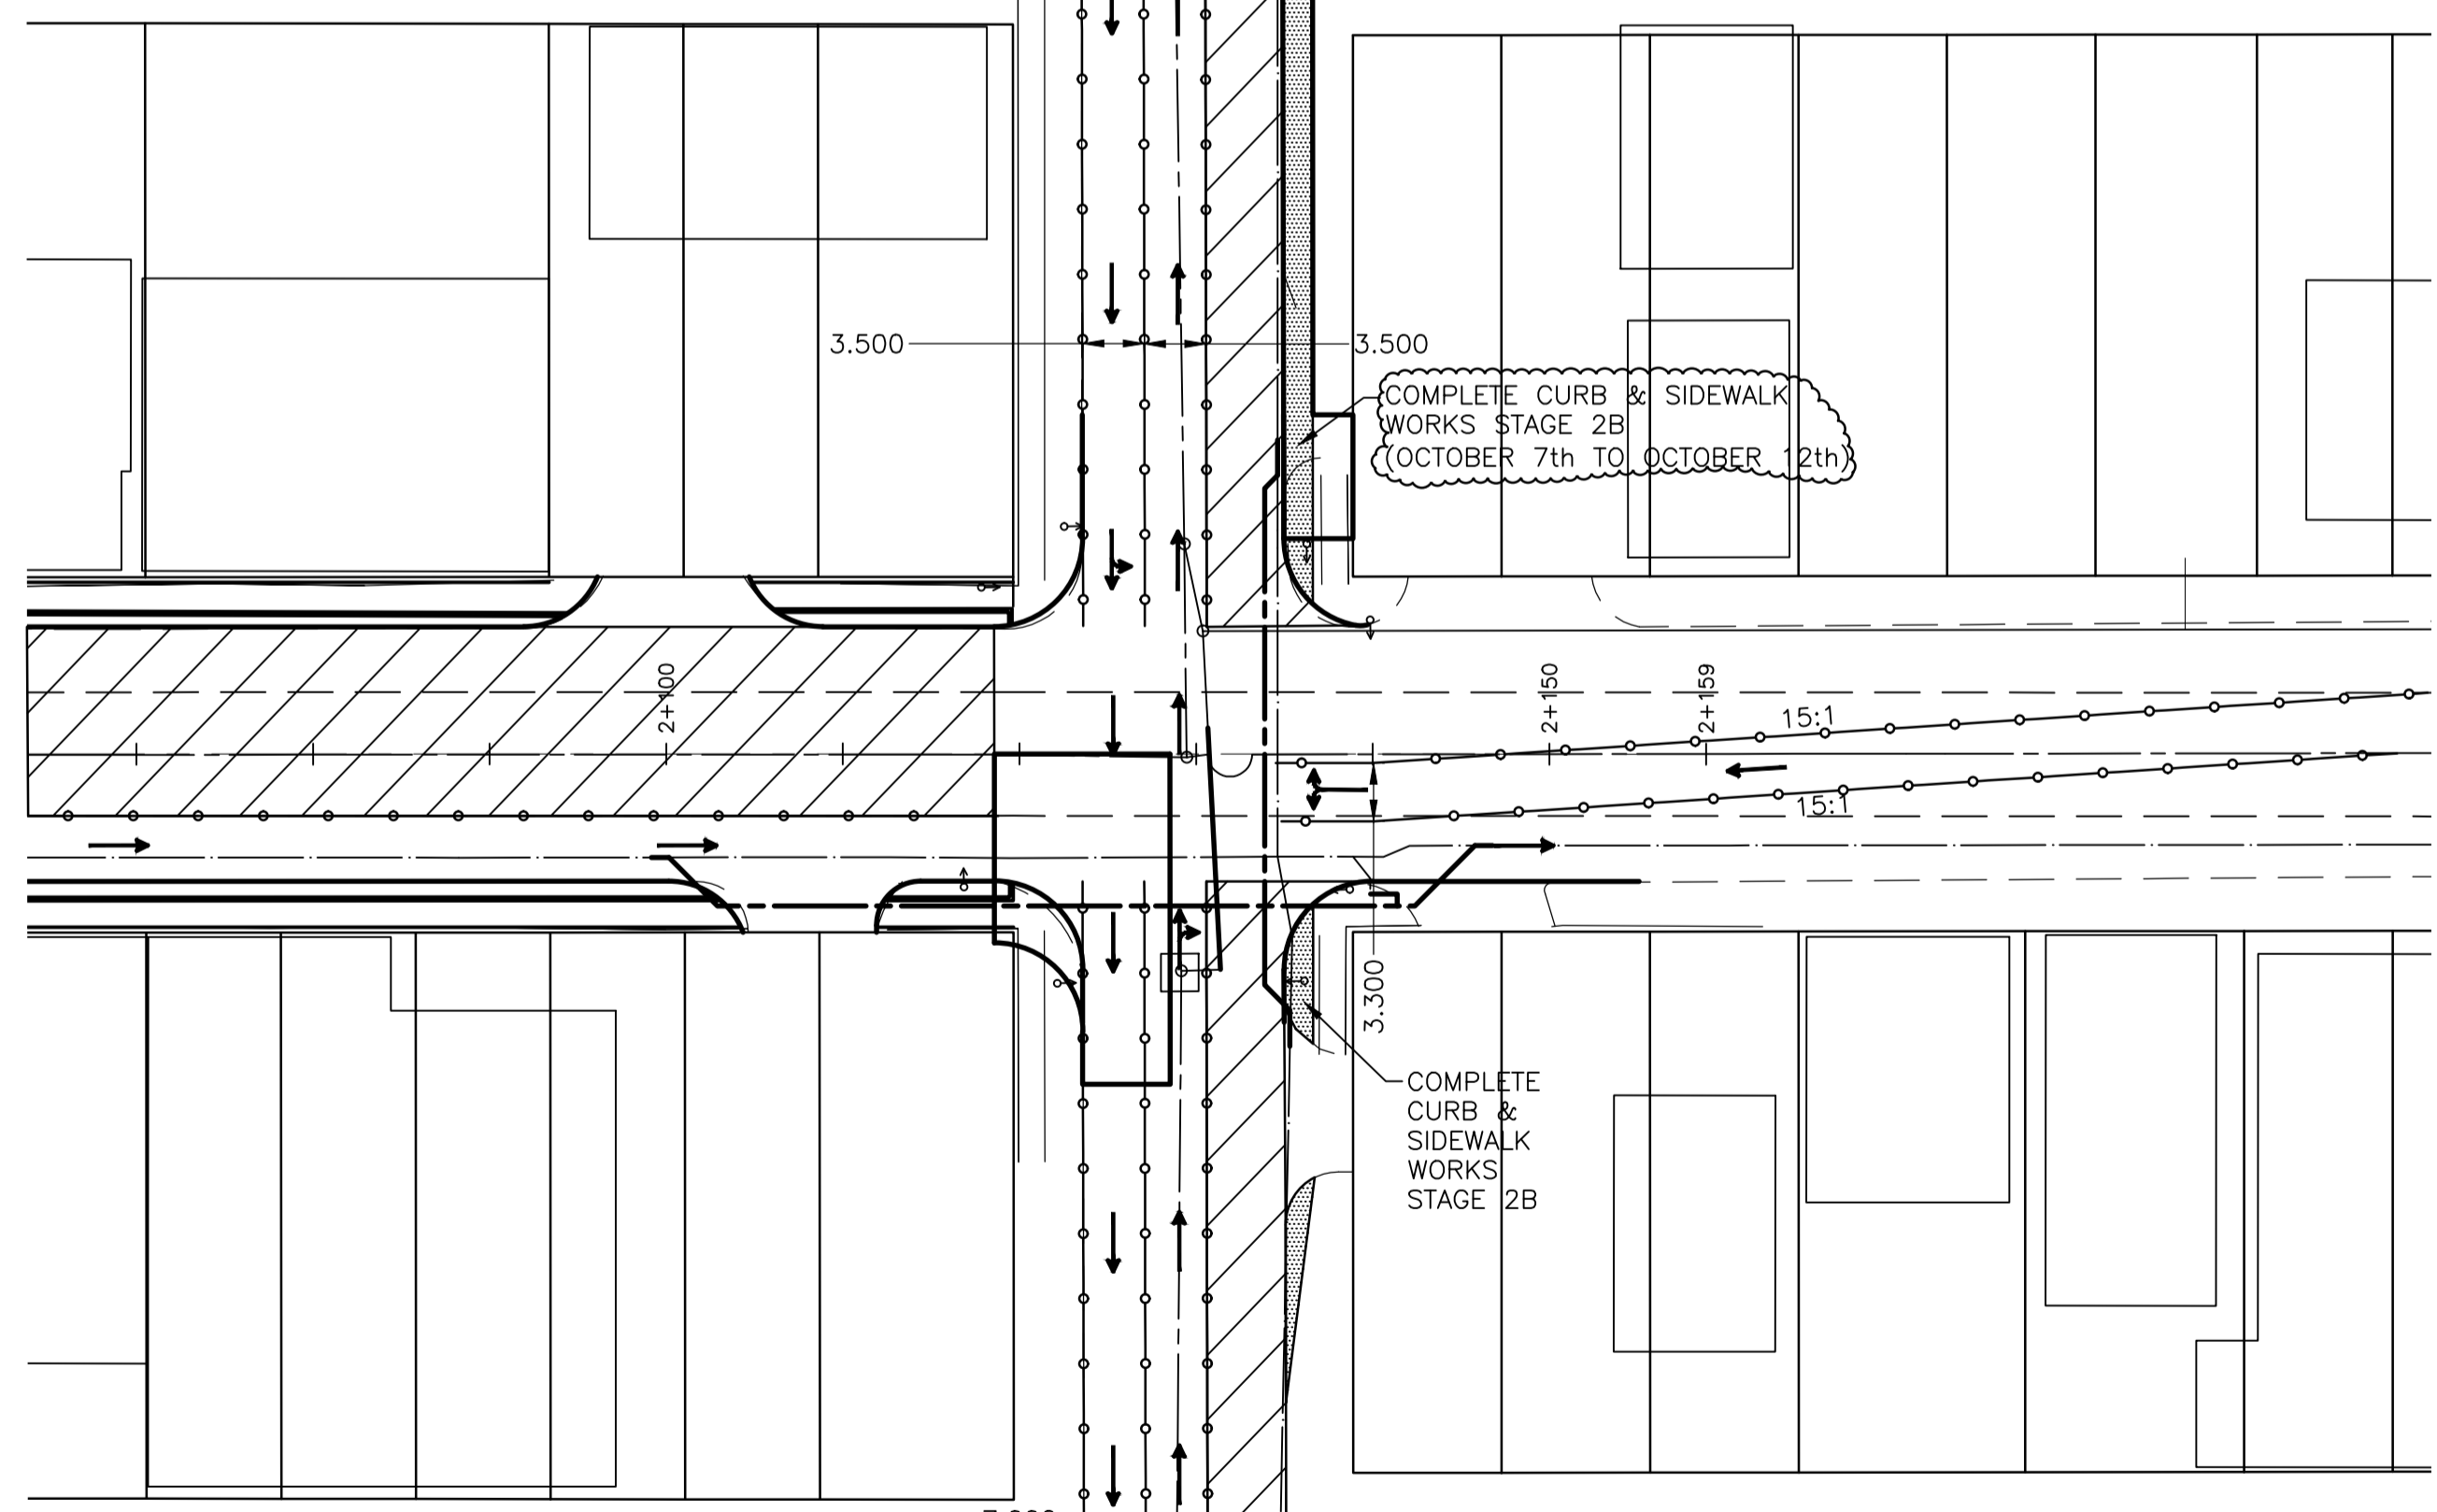

**PHASE 2 STAGE 2B**  
DATES AS PER C702

**WARNING**

IF POWER EQUIPMENT OR EXPLOSIVES ARE TO BE USED FOR EXCAVATION ON THIS PROJECT THE CONTRACTOR MUST:  
 1. NOTIFY THE GAS COMPANY OF THE PROPOSED LOCATION OF EXCAVATION.  
 2. TAKE PRECAUTION TO AVOID DAMAGE TO GAS COMPANY INSTALLATIONS SEE PROVINCIAL REGULATION 210/72 FOR DETAILS.  
 3. OBTAIN EXCAVATION PERMITS PRIOR TO CONSTRUCTION.

**METRIC**

WHOLE NUMBERS INDICATE MILLIMETRES  
 DECIMALIZED NUMBERS INDICATE METRES

**LEGEND**

- POLYPOSTS
- LANE CLOSURE
- CONSTRUCTION ZONE
- PEDESTRIAN CORRIDOR
- CONCRETE LANE WIDENING
- TRAFFIC FLOW

**LOCATION APPROVED UNDERGROUND STRUCTURES**

SUPV. U/G STRUCTURES COMMITTEE DATE  
 NOTE:  
 LOCATION OF UNDERGROUND STRUCTURES AS SHOWN ARE BASED ON THE BEST INFORMATION AVAILABLE BUT NO GUARANTEE IS GIVEN THAT ALL EXISTING UTILITIES ARE SHOWN OR THAT THE GIVEN LOCATIONS ARE EXACT. CONFIRMATION OF EXISTENCE AND EXACT LOCATION OF ALL SERVICES MUST BE OBTAINED FROM THE INDIVIDUAL UTILITIES BEFORE PROCEEDING WITH CONSTRUCTION.

NO.	REVISIONS	DATE	BY
2	ISSUED FOR ADDENDUM 1	17.06.20	
1	ISSUED FOR TENDER	17.06.12	
0	ISSUED FOR REVIEW	17.05.30	

**Stantec**  
 500 - 311 Portage Avenue, Winnipeg MB Canada  
 www.stantec.com

DESIGNED BY	D.L.	CHECKED BY	D.J.M.
DRAWN BY	G.P.	APPROVED BY	S.B.C.
HOR. SCALE:	1:750	RELEASED FOR CONSTRUCTION:	
VERTICAL:		DATE	2017.05.18

ENGINEER'S SEAL  
  
 CONSULTANT DRAWING NO.  
**C704**

**THE CITY OF WINNIPEG**  
 PUBLIC WORKS DEPARTMENT  
 ENGINEERING DIVISION

2017 REGIONAL STREET RENEWAL PROGRAM  
 ELLICE AVENUE  
 ARLINGTON STREET  
 TRAFFIC CONTROL / STAGING

SHEET	20	OF	20
CAD FILE DRAWING NUMBER	07271c-701-xxx.dwg		
CITY DRAWING NUMBER	P-3485-20		

**ENGINEERS GEOSCIENTISTS MANITOBA**  
 Certificate of Authorization  
 Stantec Consulting Ltd.  
 No. 1301

**GENERAL NOTES:**

- TRAFFIC CONTROL PROVIDED AND MAINTAINED BY CONTRACTOR IN ACCORDANCE WITH CITY OF WINNIPEG MANUAL OF TEMPORARY TRAFFIC CONTROL ON CITY STREETS AND TRAFFIC CONTROL SPECIFICATION.
- CONTRACTOR TO SCHEDULE TRAFFIC CONTROL MEETING WITH CONTRACT ADMINISTRATOR & CITY TRAFFIC SERVICES 48 HOURS IN ADVANCE OF COMMENCING SET UP.
- WORKS IN CLOSE PROXIMITY TO THE 400 AC WM TO BE IN COMPLIANCE TO THE CONTRACT SPECIFICATIONS.

V:\1137\active\113707271\0300\_drawing\0302\_sheet\_files\02\_civil\07271c-701-xxx.dwg