


LAST SAVE: 2012/02/17 - 10:54am  
 PATH: R:\DRAWINGS\WATER POLLUTION CONTROL\_CENTRE\_SEP\DRAWINGS\_CONVERTED BY SNC LAVALIN\1-0102P-A0007-001-01D.dwg  
 A1 SIZE - 594 x 841 mm

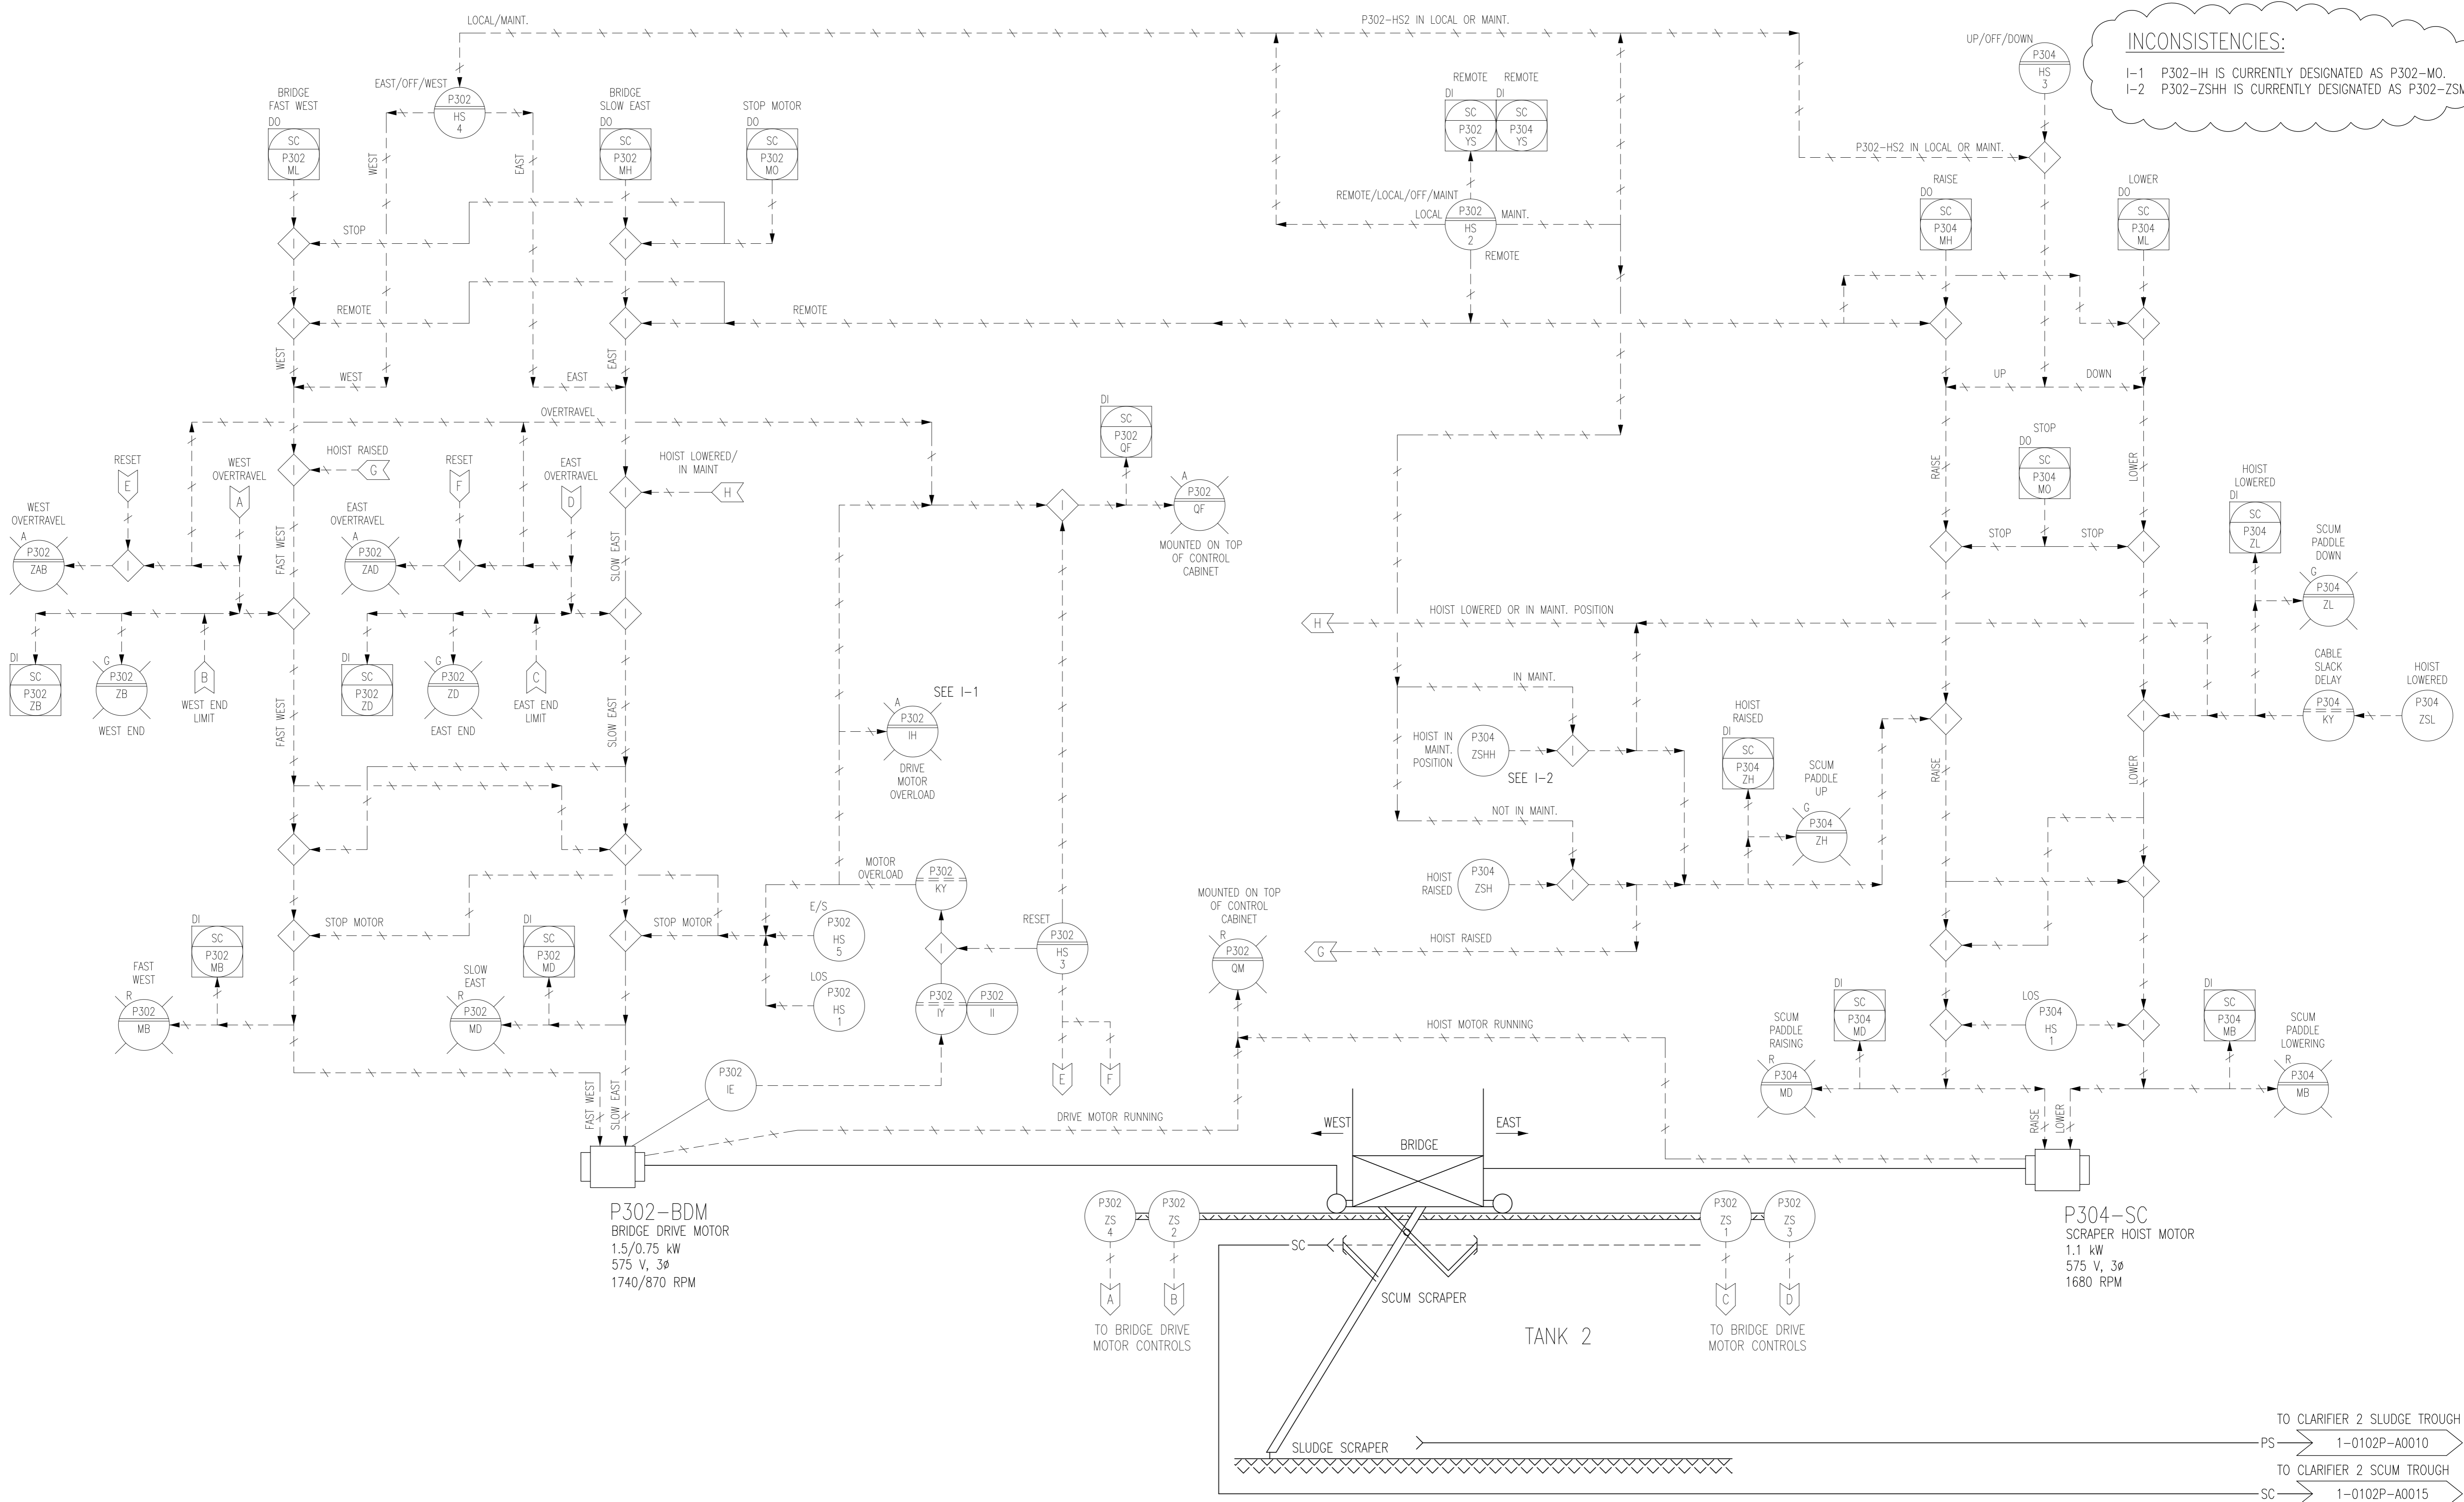

**INCONSISTENCIES:**  
 I-1 P302-IH IS CURRENTLY DESIGNATED AS P302-MO.  
 I-2 P302-ZSHH IS CURRENTLY DESIGNATED AS P302-ZSM.

**NOTES:**  
 1. ALL DEVICES SHOWN IN AN AUXILIARY PANEL ARE LOCATED IN THE CONTROL PANEL ON THE TRAVELLING BRIDGE UNLESS OTHERWISE NOTED.

1-0102P-A0002	CLARIFIER 2
1-0102A-A0001	PROCESS & INSTRUMENT DIAGRAMS LEGEND & DETAILS
DRAWING NUMBER	REFERENCE DRAWINGS

B.M. ELEV.	FIELD BOOK #:			ENGINEER'S SEAL	
POSTED TO LBIS		DESIGNED BY	EXISTING	CHECKED BY	EFB
		DRAWN BY	EFB	APPROVED BY	CJR
		HOR. SCALE	NTS	RELEASED FOR CONSTRUCTION	
01 ORIGINAL DWG No. WAS 1-0102P-A0007-001	2010/07/26	DC		DATE	2005/11/09
00 ISSUED FOR CITY USE	2007/02/26	EFB		DATE	
NO. REVISIONS	DATE	BY	FILENAME: 1-0102P-A0007-001-01D.dwg		
CITY DRAWING NUMBER		SHEET	REV.	SIZE	
1-0102P-A0007		001	01	D	

