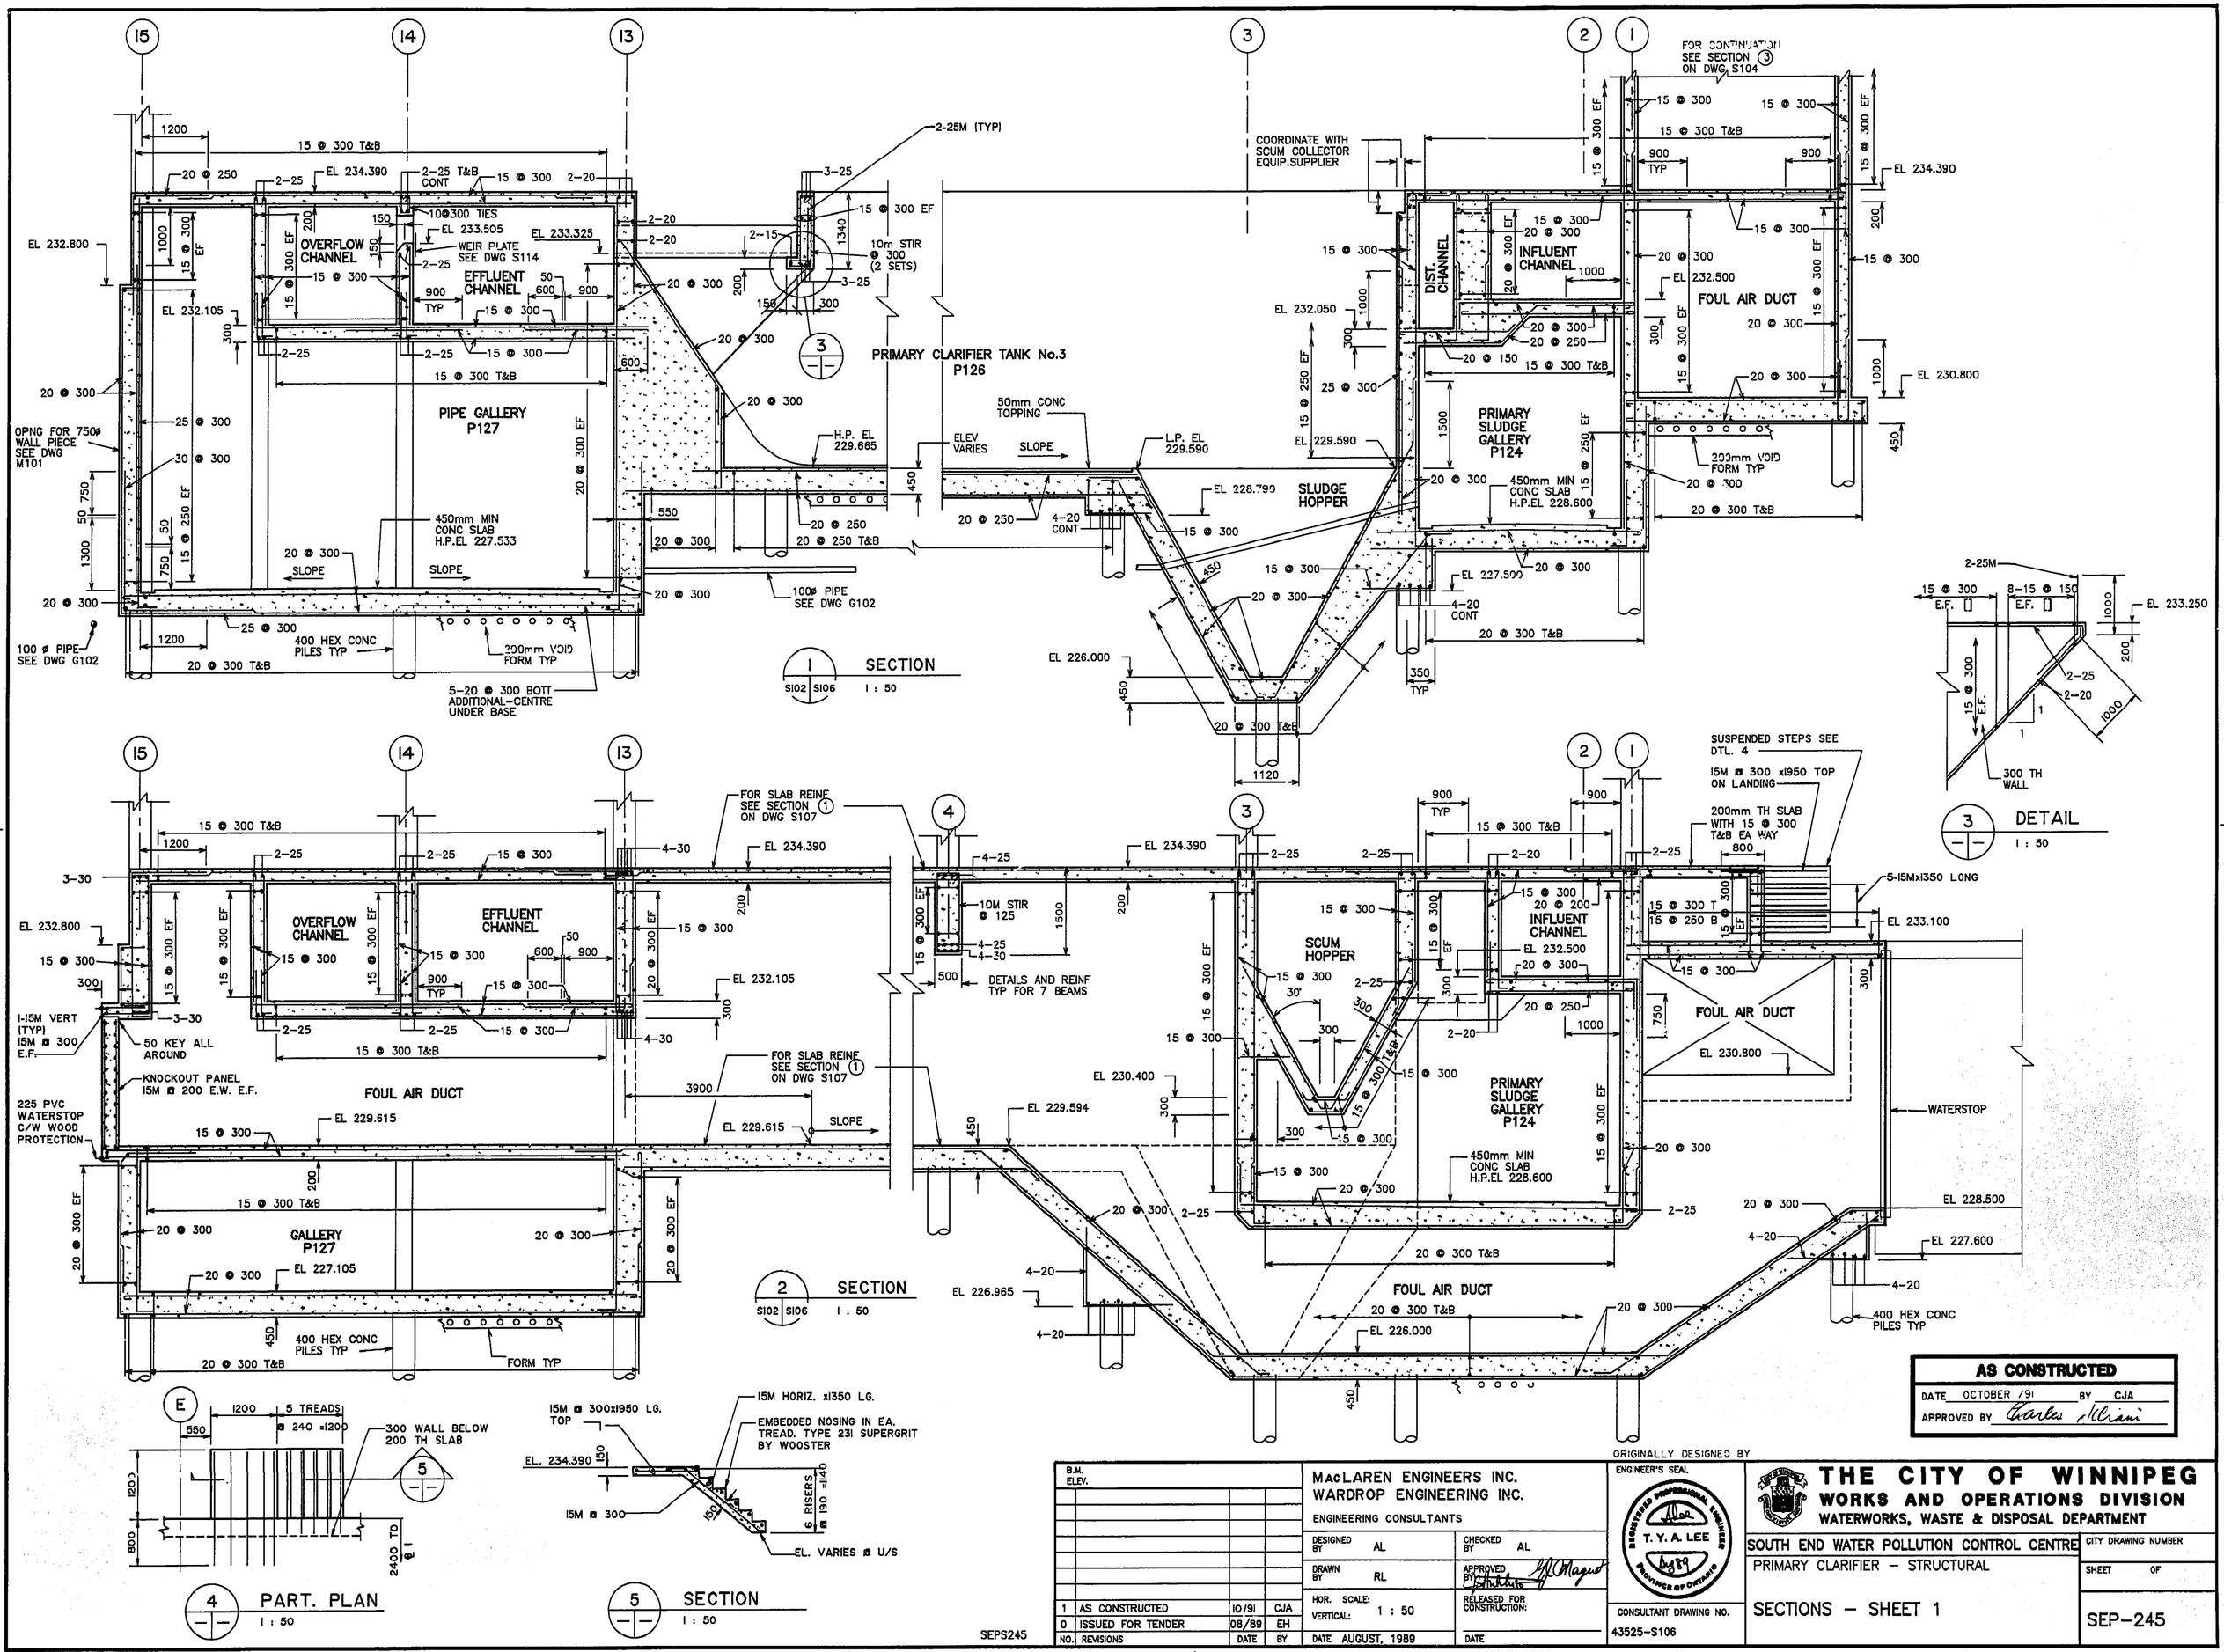

AS CONSTRUCTED
DATE OCTOBER /91 BY CJA
APPROVED BY Charles Milani

ORIGINALLY DESIGNED BY

NO.	REVISIONS	DATE	BY
1	AS CONSTRUCTED	10/91	CJA
0	ISSUED FOR TENDER	08/89	EH

B.M. ELEV.

MacLAREN ENGINEERS INC.
WARDROP ENGINEERING INC.
ENGINEERING CONSULTANTS

DESIGNED BY AL | CHECKED BY AL
DRAWN BY RL | APPROVED BY
HOR. SCALE: VERTICAL: 1 : 50
RELEASED FOR CONSTRUCTION:
DATE AUGUST, 1989 | DATE

ENGINEER'S SEAL
REGISTERED PROFESSIONAL ENGINEER T. Y. A. LEE PROVINCE OF ONTARIO

CONSULTANT DRAWING NO. 43525-S106

THE CITY OF WINNIPEG
WORKS AND OPERATIONS DIVISION
WATERWORKS, WASTE & DISPOSAL DEPARTMENT

SOUTH END WATER POLLUTION CONTROL CENTRE
PRIMARY CLARIFIER – STRUCTURAL
SECTIONS – SHEET 1

CITY DRAWING NUMBER
SHEET OF
SEP-245

SEPS245