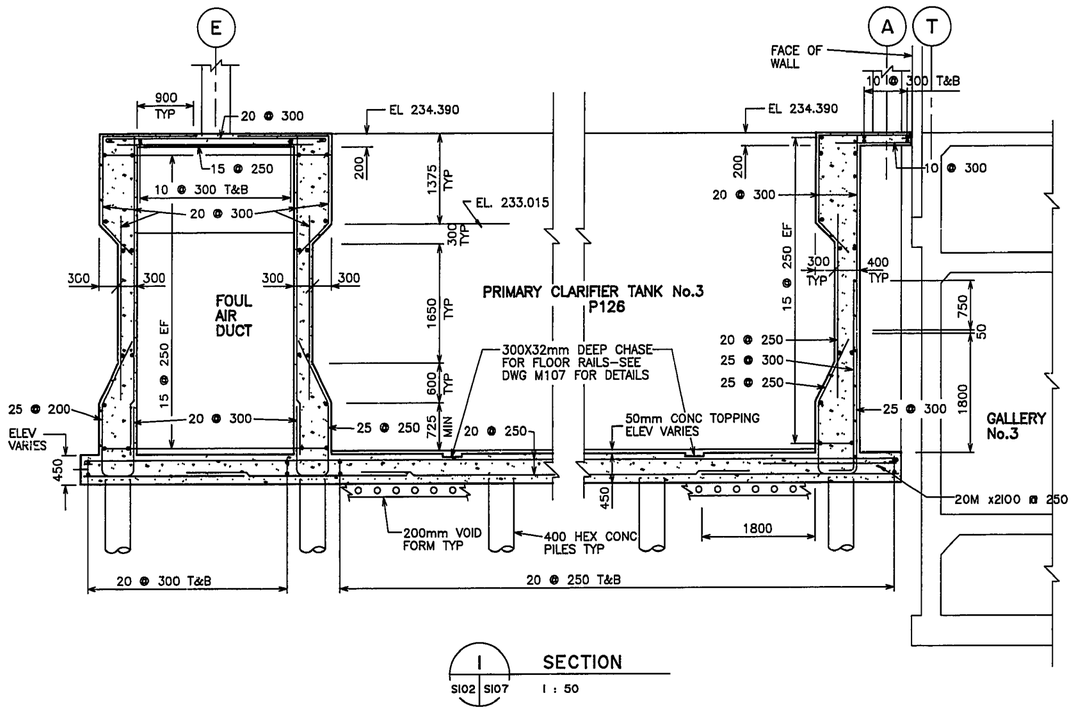

1 SECTION
S102 | S107 1 : 50

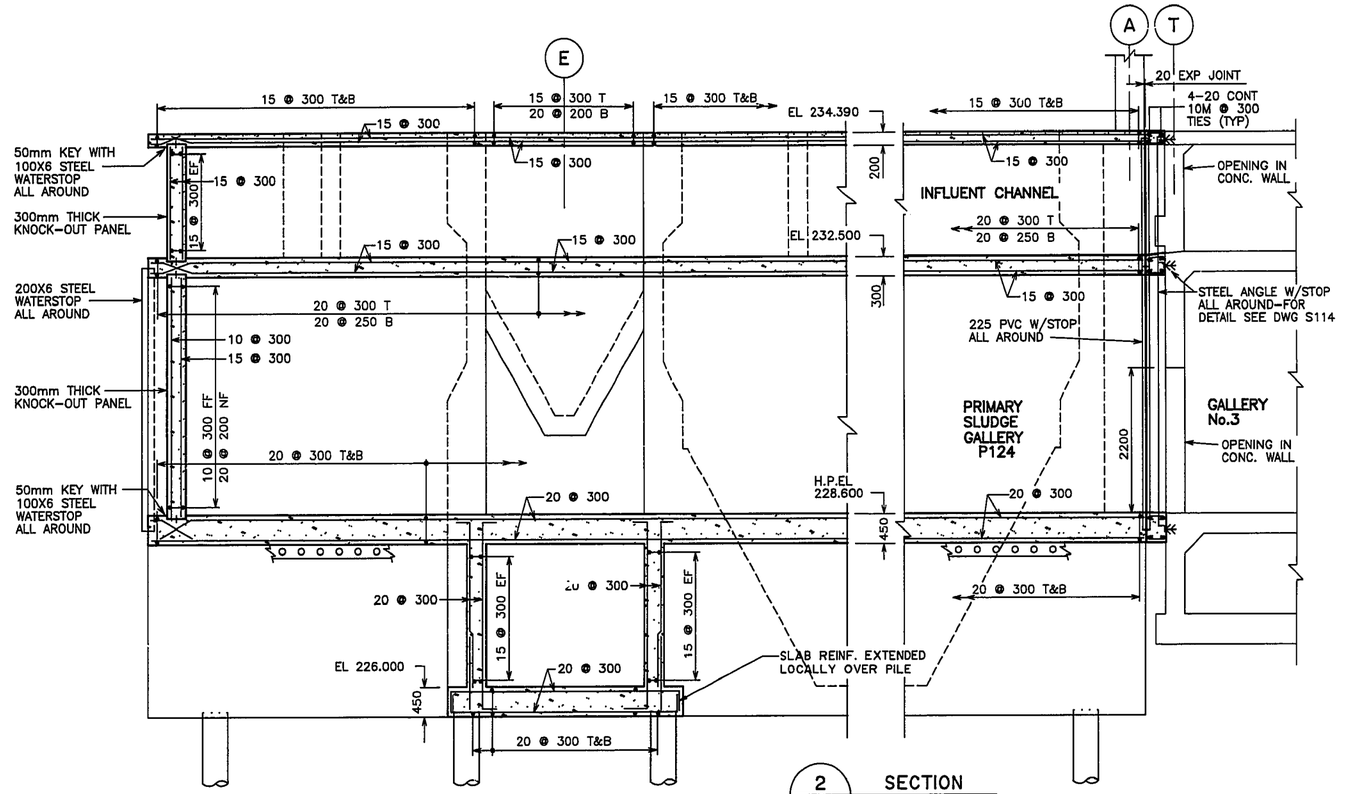

2 SECTION
S102 | S107 1 : 50

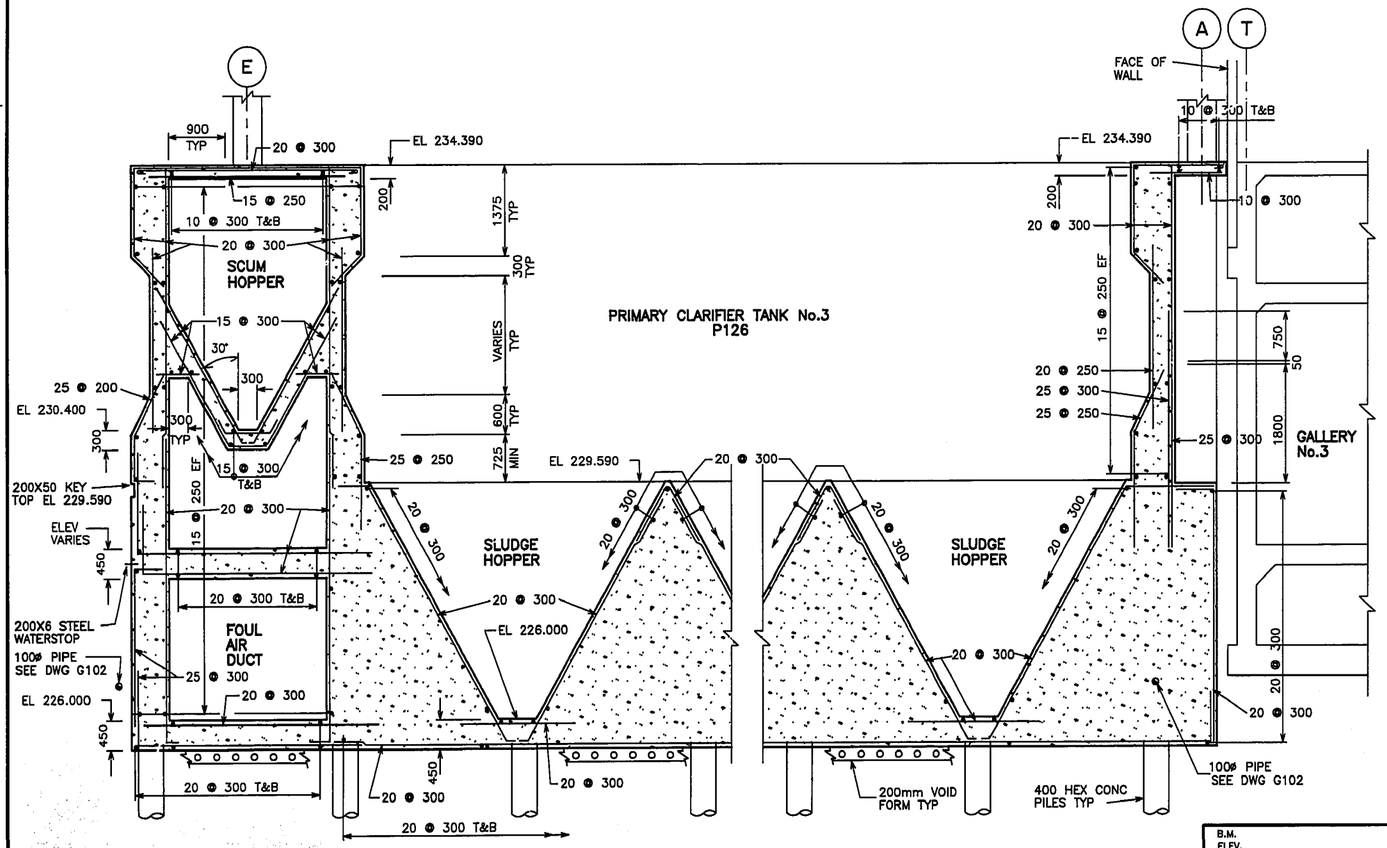

3 SECTION
S102 | S107 1 : 50

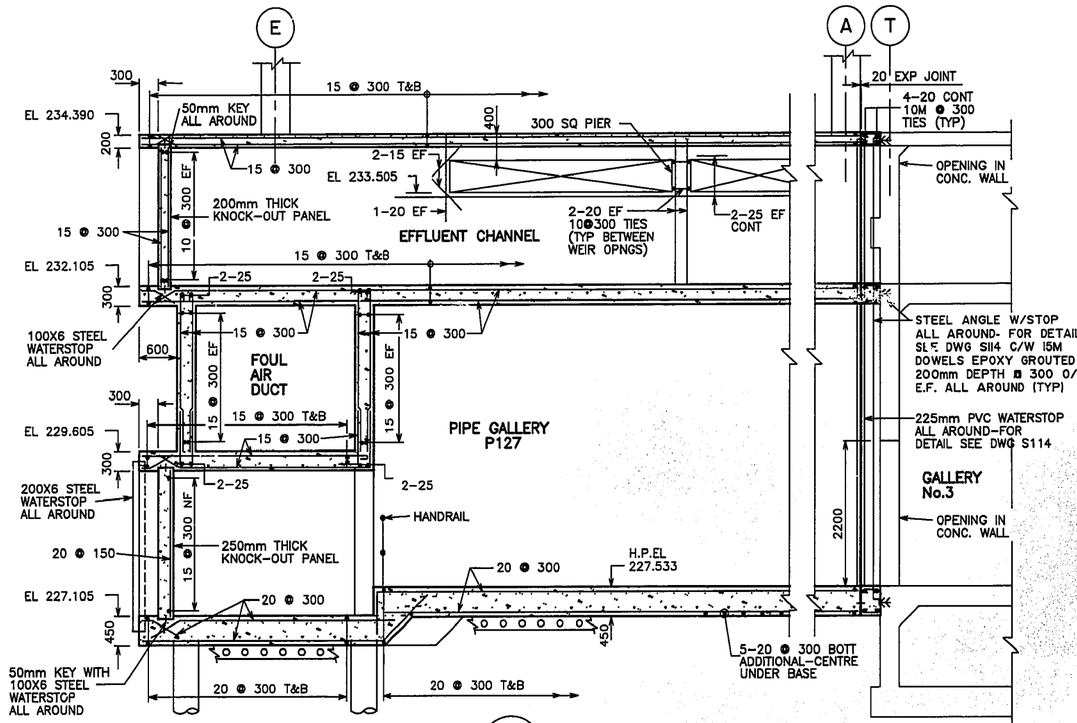

4 SECTION
S102 | S107 1 : 50

ORIGINALLY DESIGNED BY

AS CONSTRUCTED
DATE OCTOBER /91 BY CJA
APPROVED BY Charles Sklriani

SEPS246

NO.	REVISIONS	DATE	BY
1	AS CONSTRUCTED	10/91	CJA
0	ISSUED FOR TENDER	08/89	EH

B.M. ELEV.

MacLAREN ENGINEERS INC.
WARDROP ENGINEERING INC.
ENGINEERING CONSULTANTS

DESIGNED BY AL | CHECKED BY AL
DRAWN BY AL | APPROVED BY
HOR. SCALE: VERTICAL: 1 : 50 | RELEASED FOR CONSTRUCTION:
DATE AUGUST, 1989 | DATE

ENGINEER'S SEAL
T. Y. A. LEE
1989
PROVINCE OF ONTARIO

CONSULTANT DRAWING NO. 43525-S107

THE CITY OF WINNIPEG
WORKS AND OPERATIONS DIVISION
WATERWORKS, WASTE & DISPOSAL DEPARTMENT

SOUTH END WATER POLLUTION CONTROL CENTRE
PRIMARY CLARIFIER - STRUCTURAL
SECTION - SHEET 2

CITY DRAWING NUMBER
SHEET OF
SEP-246