

ELECTRICAL POWER AND SYSTEMS NOTES: "["x"]"

ALSO SEE NOTES & SPECIFICATIONS. ALL WIRING & CABLING SHALL BE CONCEALED IN DOOR JAMB &/OR IN WALL CAVITY FOR FINISH SPACES. ALL WIRING & CABLING IN CEILING SPACE SHALL BE PLENUM RATED AS PER LATEST CEC.

1. ELECTRICAL CONDUIT SUPPORT 1.1. PROVIDE ANCHORED SUPPORT RODS TO CEILING TO SUPPORT 16"
MINIMUM LONG UNISTRUTS ALONG LAYOUT SHOWN. PROVIDE STEEL EMT CLAMPS FOR UNISTRUT MOUNTING. MOUNT HEIGHT TBD.

2. COMMUNICATION TRAY SYSTEM

- 2.1. PROVIDE COMMUNICATION TRAY SYSTEM TO SUPPORT CABLING FOR DATA, FUTURE CARD ACCESS, TELEPHONE, INTRUSION ALARM, LIGHTING CAT5e. SYSTEM SHALL BE LEGRAND "CABLOFIL CABLE MANAGEMENT" WITH CABLOFIL CABLE TRAY CF105/300 (4" HEIGHT x 12" WIDTH) ALL NECESSARY CLAMP KITS, SUPPORTS, BRACKETS, DROPOUTS, CABLE EXITS, CLIPS. MOUNT HEIGHT TBD. GROUNDING SHALL CONFORM TO LATEST CEC.

  2.2. ATTACH CABLE TRAY TO TOP OF ELECTRICAL CONDUIT SUPPORT

3. TRANSFORMER POWER FOR VAVs

- 3.1. PROVIDE DEDICATED 120V/1PH. 15A CIRCUIT WITH BREAKER TO (2) TRANSFORMER WITH AUTOMATIC SHORT CIRCUIT PROTECTION, 120VAC-24VAC, 100VA RATING, PLATE MOUNTING, MOUNT TRANSFORMERS WITH PLATE SECURELY ON WALL AT 2300mm AFF.
- 4. REFER TO MOTOR SCHEDULE FOR WIRE & CONNECT OF EQUIPMENT.
- 5. MOUNT EMERGENCY SIGN/ BATTERY UNIT ABOVE DOOR AT 2400mm AFF.

7. TELEPHONE/COMMUNICATION BACKBOARD, REFER TO SPECIFICATION.

- MOUNT COMPACT DOUBLE REMOTE EMERGENCY LAMPS AT 2400mm AFF.
- 8. LINE-VOLTAGE THERMOSTAT WITH 24V RELAY & TRANSFORMER 347V/24V
- 9. PROVIDE NETWORK RACK & MOUNT SECURELY TO FLOOR. PROVIDE 1000mm SPACE IN FRONT & BEHIND & 600mm AT SIDES FOR ACCESS.

REFER TO ELECTRICAL LEGEND FOR EQUIPMENT SPECIFICATION.

TO CONTROL BASEBOARD HEATER & VAV.

10. PROVIDE IN-DUCT SMOKE DETECTOR & ALL NECESSARY COMPONENTS TO BE MOUNTED ON AHU-1 RETURN DUCT. WIRE WITH RELAY & ALL NECESSARY COMPONENTS TO BUILDING ALARM CONTROL PANEL, HEAT & SMOKE DETECTOR CONTACTS. CONFIGURE TO SHUT-DOWN AHÚ-1 WHEN HEAT &/OR SMOKE DETECTOR IS ACTIVATED. REFER TO DRAWING E8, INTRUSION ALARM AND MONITORING SYSTEMS. BUILDING ALARM CONTROL PANEL BY-OTHERS.


√ 11. ROOF MAST CABLING ENTRANCE CONDUIT

- 11.1. PROVIDE TRUE VERTICAL, NO BENDS, 50mm EMT FROM BASEMENT UP TO 610mm ABOVE FINISHED ROOF. TERMINATE 50mm EMT BASEMENT END WITH PLASTIC GROMMET TO A WALL MOUNTED STEEL ENCLOSURE (254x203x152,NEMA 1 SCREW COVER WALL MOUNT) 150mm FROM FINISHED BASEMENT CEILING.
- 11.2. PROVIDE ANOTHER ENCLOSURE MOUNTED TO CONCRETE BLOCK WALL IN MAIN FLOOR CEILING RETURN AIR SPACE. **CONDUIT SHALL BE** LOCATED BEHIND LUNCHROOM DOOR & TIGHT AGAINST WALL TO ALLOW DOOR TO FULLY OPEN 90°. INSULATE CONDUIT 600mm INTERIOR LENGTH FROM UNDERSIDE OF ROOF TO PREVENT CONDENSATION.
- 11.3. TERMINATE, FIRESTOP AT ROOF & FLOOR PENETRATIONS & WEATHERSEAL 50mm EMT END WITH SERVICE ENTRANCE HEAD (IBERVILLE MODEL BCEFSA-2 OR EQUAL.). PLUG SERVICE ENTRANCE PHENOLIC INSULATOR HEAD ACCESS HOLES TO PREVENT WATER INFILTRATION. ALSO PROVIDE A PITCH PAN (100mm HIGH MINIMUM) AT ROOF LEVEL TO WEATHERSEAL THE EMT ROOF PENETRATION.

NOTES:

. THESE DRAWINGS SHALL NOT BE SCALED. CONSULT WITH CLIENT AND DESIGNER ON

- 2. DIMENSIONS & UNITS SHOWN IN WHOLE NUMBERS ARE IN MILLIMETRES (mm).
- 3. DIMENSIONS & UNITS SHOWN TO DECIMAL PLACES ARE IN METRES (M).
- 4. ALSO REFER TO SHEET E1 & ELECTRICAL SPECIFICATIONS.

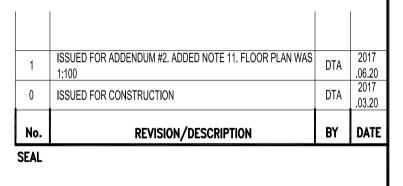

ORIGINAL STAMPED BY: XINYU WU, 30166 DATE: **2017-03-20** 

DESIGNED DTA APPROVED DATE 2017.03.20 USER APPROVAL



THE CITY OF WINNIPEG PLANNING, PROPERTY AND DEVELOPMENT DEPARTMENT MUNICIPAL ACCOMMODATIONS DIVISION 3-65 GARRY STREET, R3C 4K4

**PROJECT** 

BRADY ROAD LANDFILL ADMINISTRATION BUILDING DEVELOPMENT FOR BRADY LANDFILL

1777 BRADY ROAD SHEET TITLE

> BASEMENT FLOOR PLAN ELECTRICAL

POWER AND SYSTEMS

E3-R1 2015-037-02 AS SHOWN

DRAWING SHEET SIZE: A1 (841mm x 594mm) PLOT 1:1