

NOTES:

NOTES:

- SLOPE GRADE 1.5% FROM BUILDING ON WEST & SOUTH SIDES TO ROADS/ DITCHES/ BUFFER ZONE.
- HYDROSEEDING & WOOD CHIP MULCH & FOR SHRUBS PROVIDED BY CITY.
- LANDSCAPE FABRIC BY CONTRACTOR.
- REQUIRED BY ZONING BY-LAW:
WITHIN 100 M FRONTAGE: 11 TREES & 49 SHRUBS
FOUNDATION LANDSCAPE: 8 SHRUBS
PARKING LOT INTERIOR LANDSCAPE: 4 TREES & 13 SHRUBS.

- BIKE RACK
SUPPLY & INSTALL BARKMAN PRECAST CONCRETE WITH LOCKING RING. (SINGLE SLOT BIKE RACK)
- CONCRETE PAVER STONE PATH INSTALLATION

FOLLOW THE CITY OF WPG GUIDELINES FOR 'INSTALLATION OF PAVER STONES' CW3330 LOCATED ON THE CITY OF WPG. WEBSITE 'STANDARD CONSTRUCTION SPECIFICATIONS'.

NOTE:

~~THIS DRAWING IS NOT IN CONTRACT. SEE DRAWING C1.2 FOR ITEMS IN CONTRACT.~~

No.	REVISION/DESCRIPTION	BY	DATE
1	ISSUED FOR ADDENDUM #2	JAW	JUNE 15, 2017
0	ISSUED FOR CONSTRUCTION	MMK	MAR 17, 2017

ORIGINAL STAMPED BY: R. LI
DATE: MARCH 20, 2017

DRAWN	MMK	CHECKED	DESIGNED	APPROVED
DATE	2016.08.30	USER APPROVAL		



THE CITY OF WINNIPEG
PLANNING, PROPERTY AND DEVELOPMENT DEPARTMENT
MUNICIPAL ACCOMMODATIONS DIVISION
3-65 GARRY STREET, R3C 4K4

PROJECT
BRADY ROAD LANDFILL
ADMINISTRATION BUILDING
DEVELOPMENT FOR BRADY LANDFILL
1777 BRADY ROAD


SHEET TITLE

LANDSCAPING DETAILS


SCALE	PROJECT No:	SHEET No:
AS SHOWN	2015-037	L1.1-R1

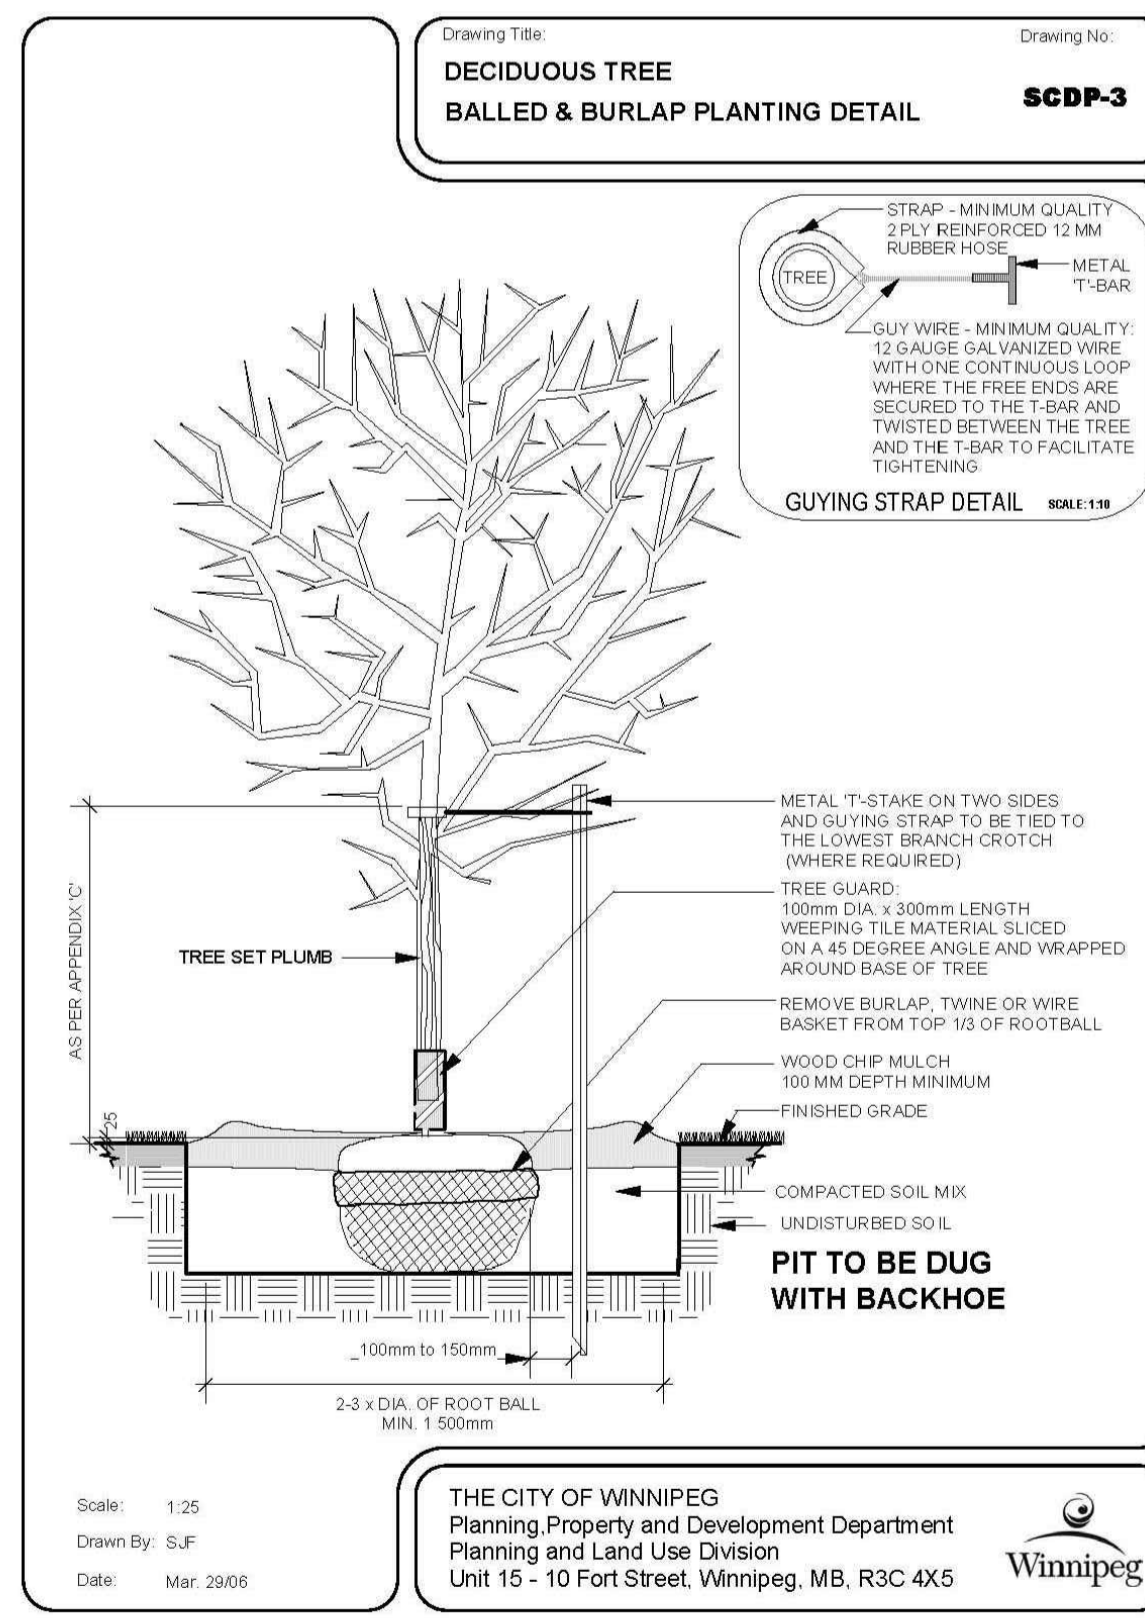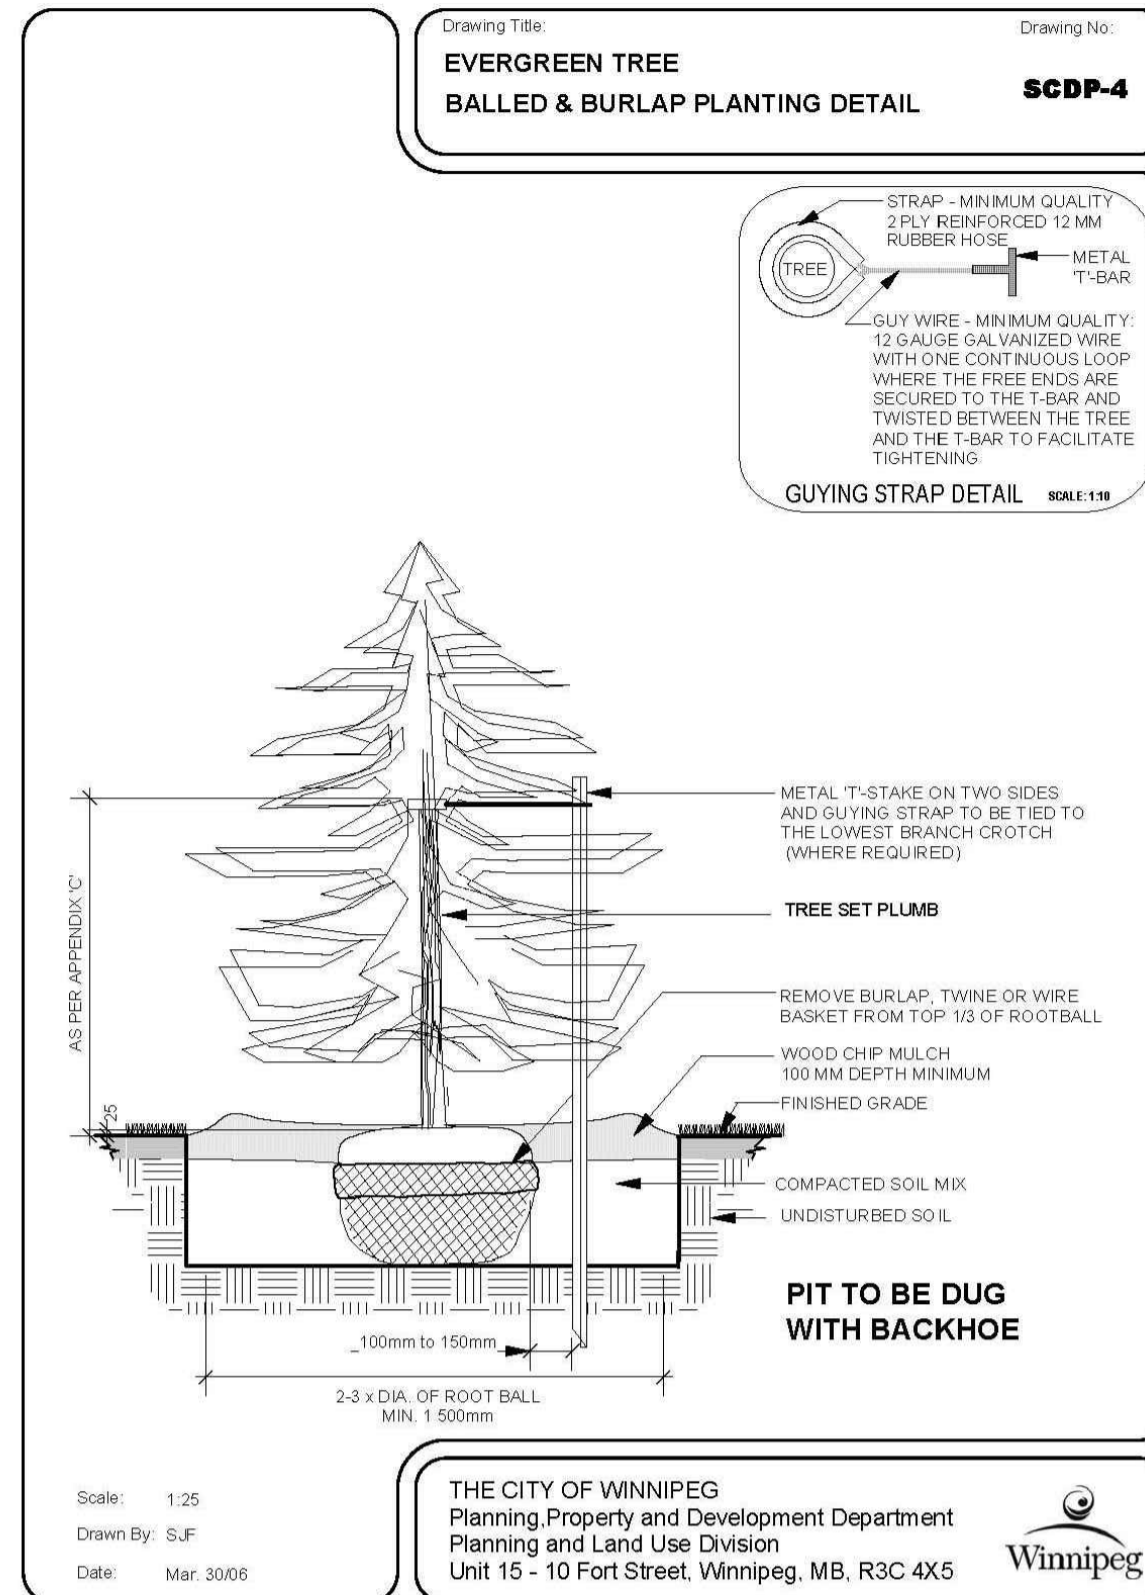





NOTE:
ALL ITEMS ON THIS DRAWING THAT ARE TO BE PLANTED FOR EXAMPLE: TREES, BUSHES, SOD, PLANTS ARE NOT IN CONTRACT AND ARE SHOWN ONLY FOR INFORMATION PURPOSES

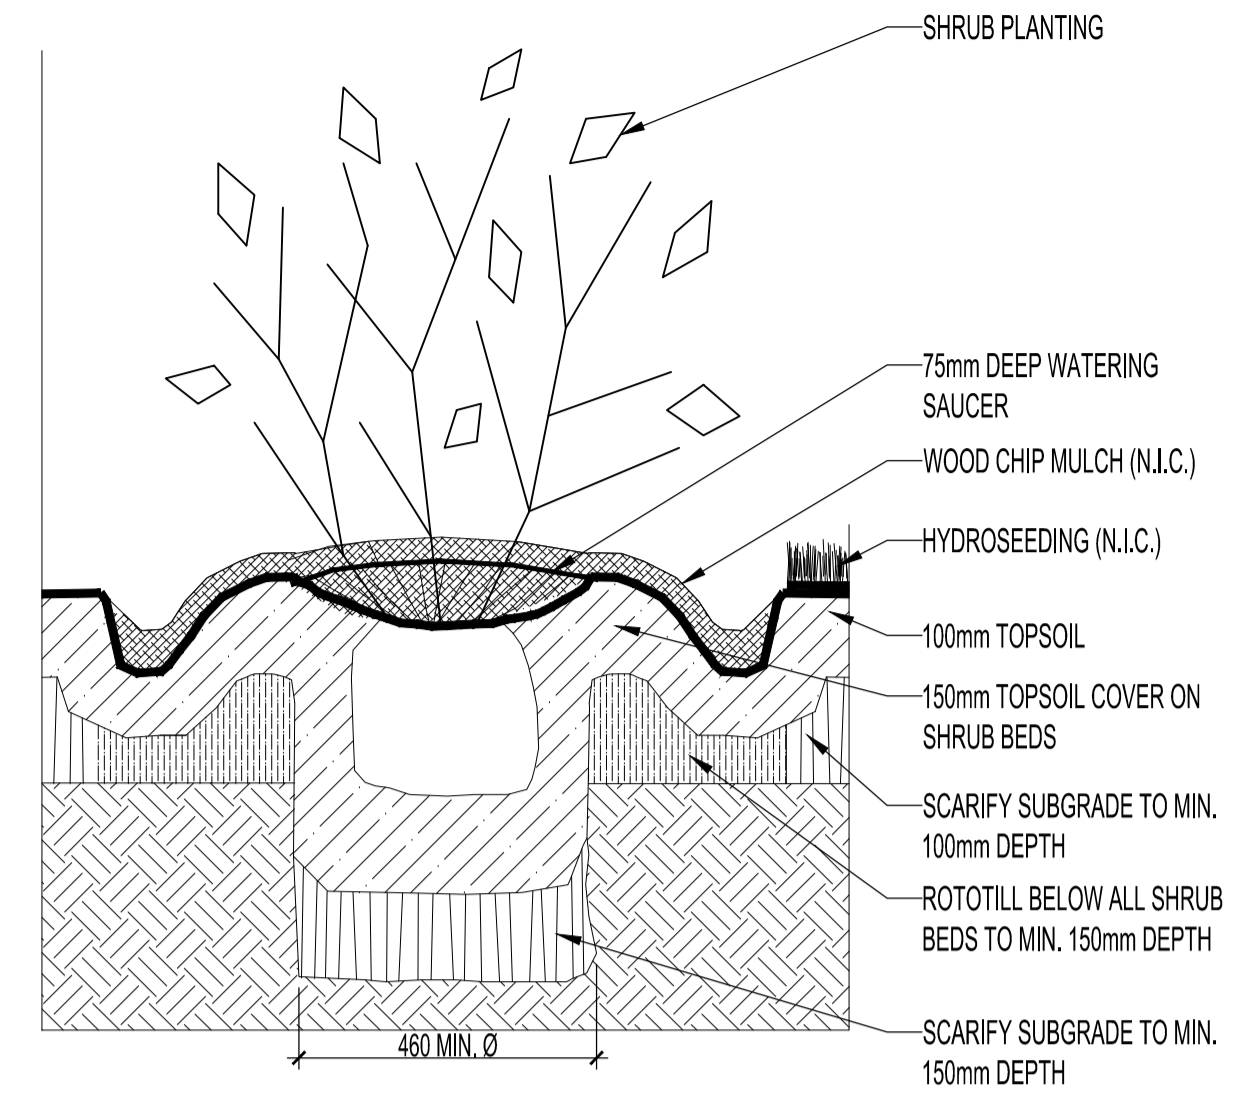


TYPICAL SECTION - BEDDING PLANTS
SCALE: N.T.S.

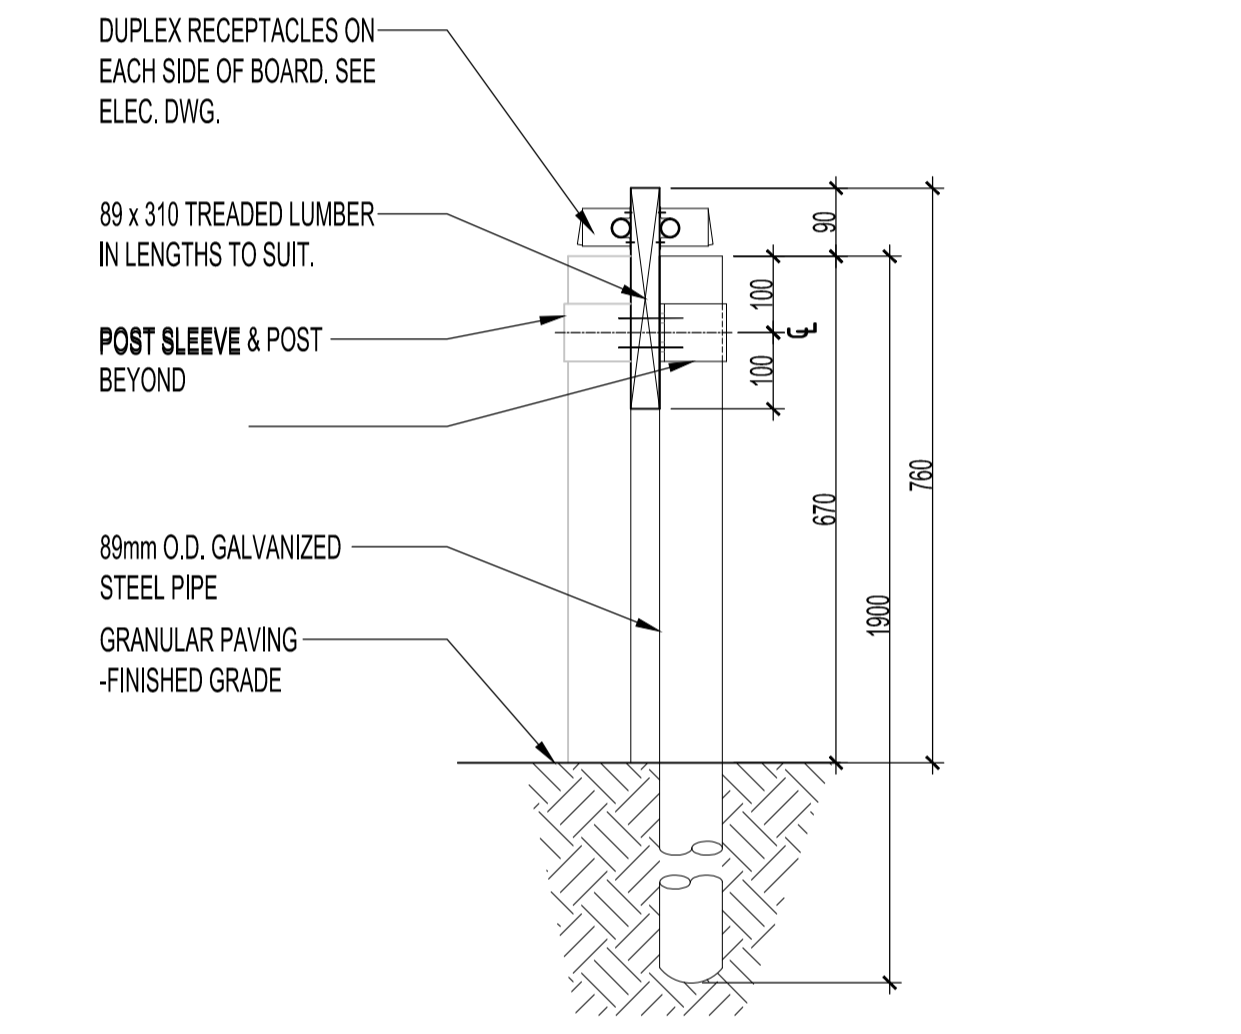

1 SECTION - PARKING FENCING - TYPICAL
SCALE: 1:10

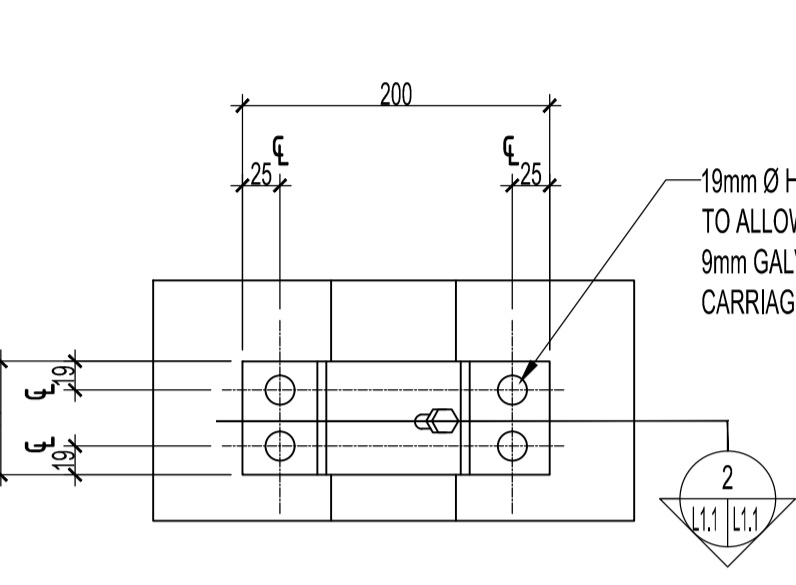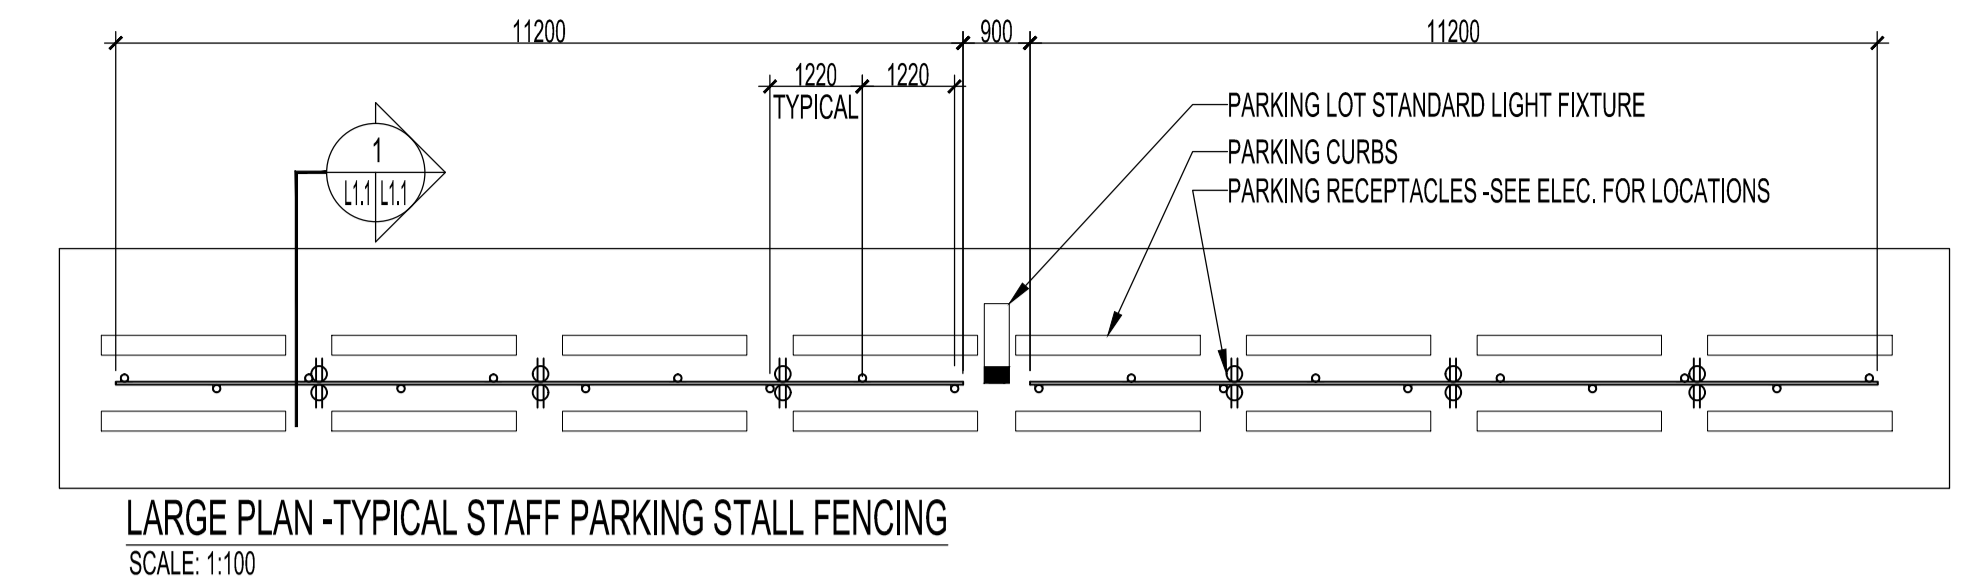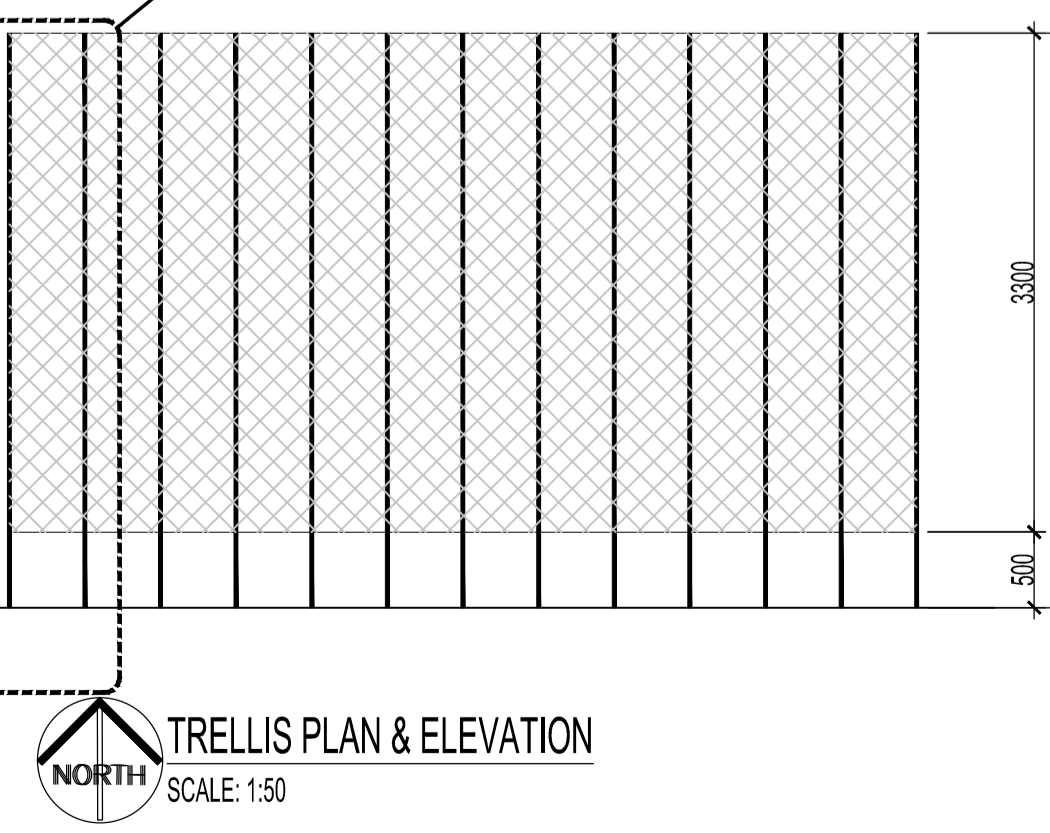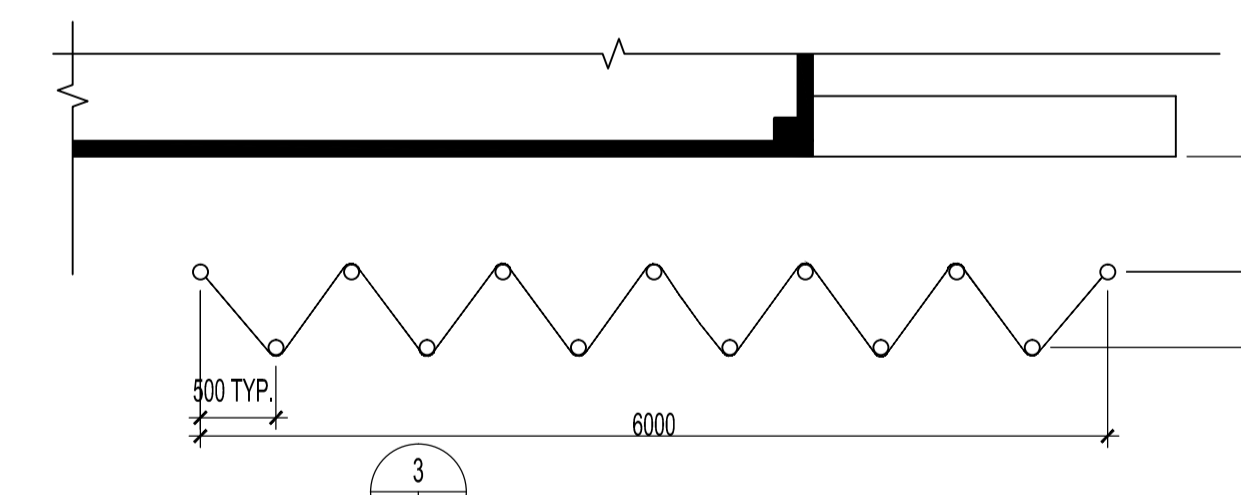

2 SECTION - POST SLEEVE - TYPICAL
SCALE: 1:10

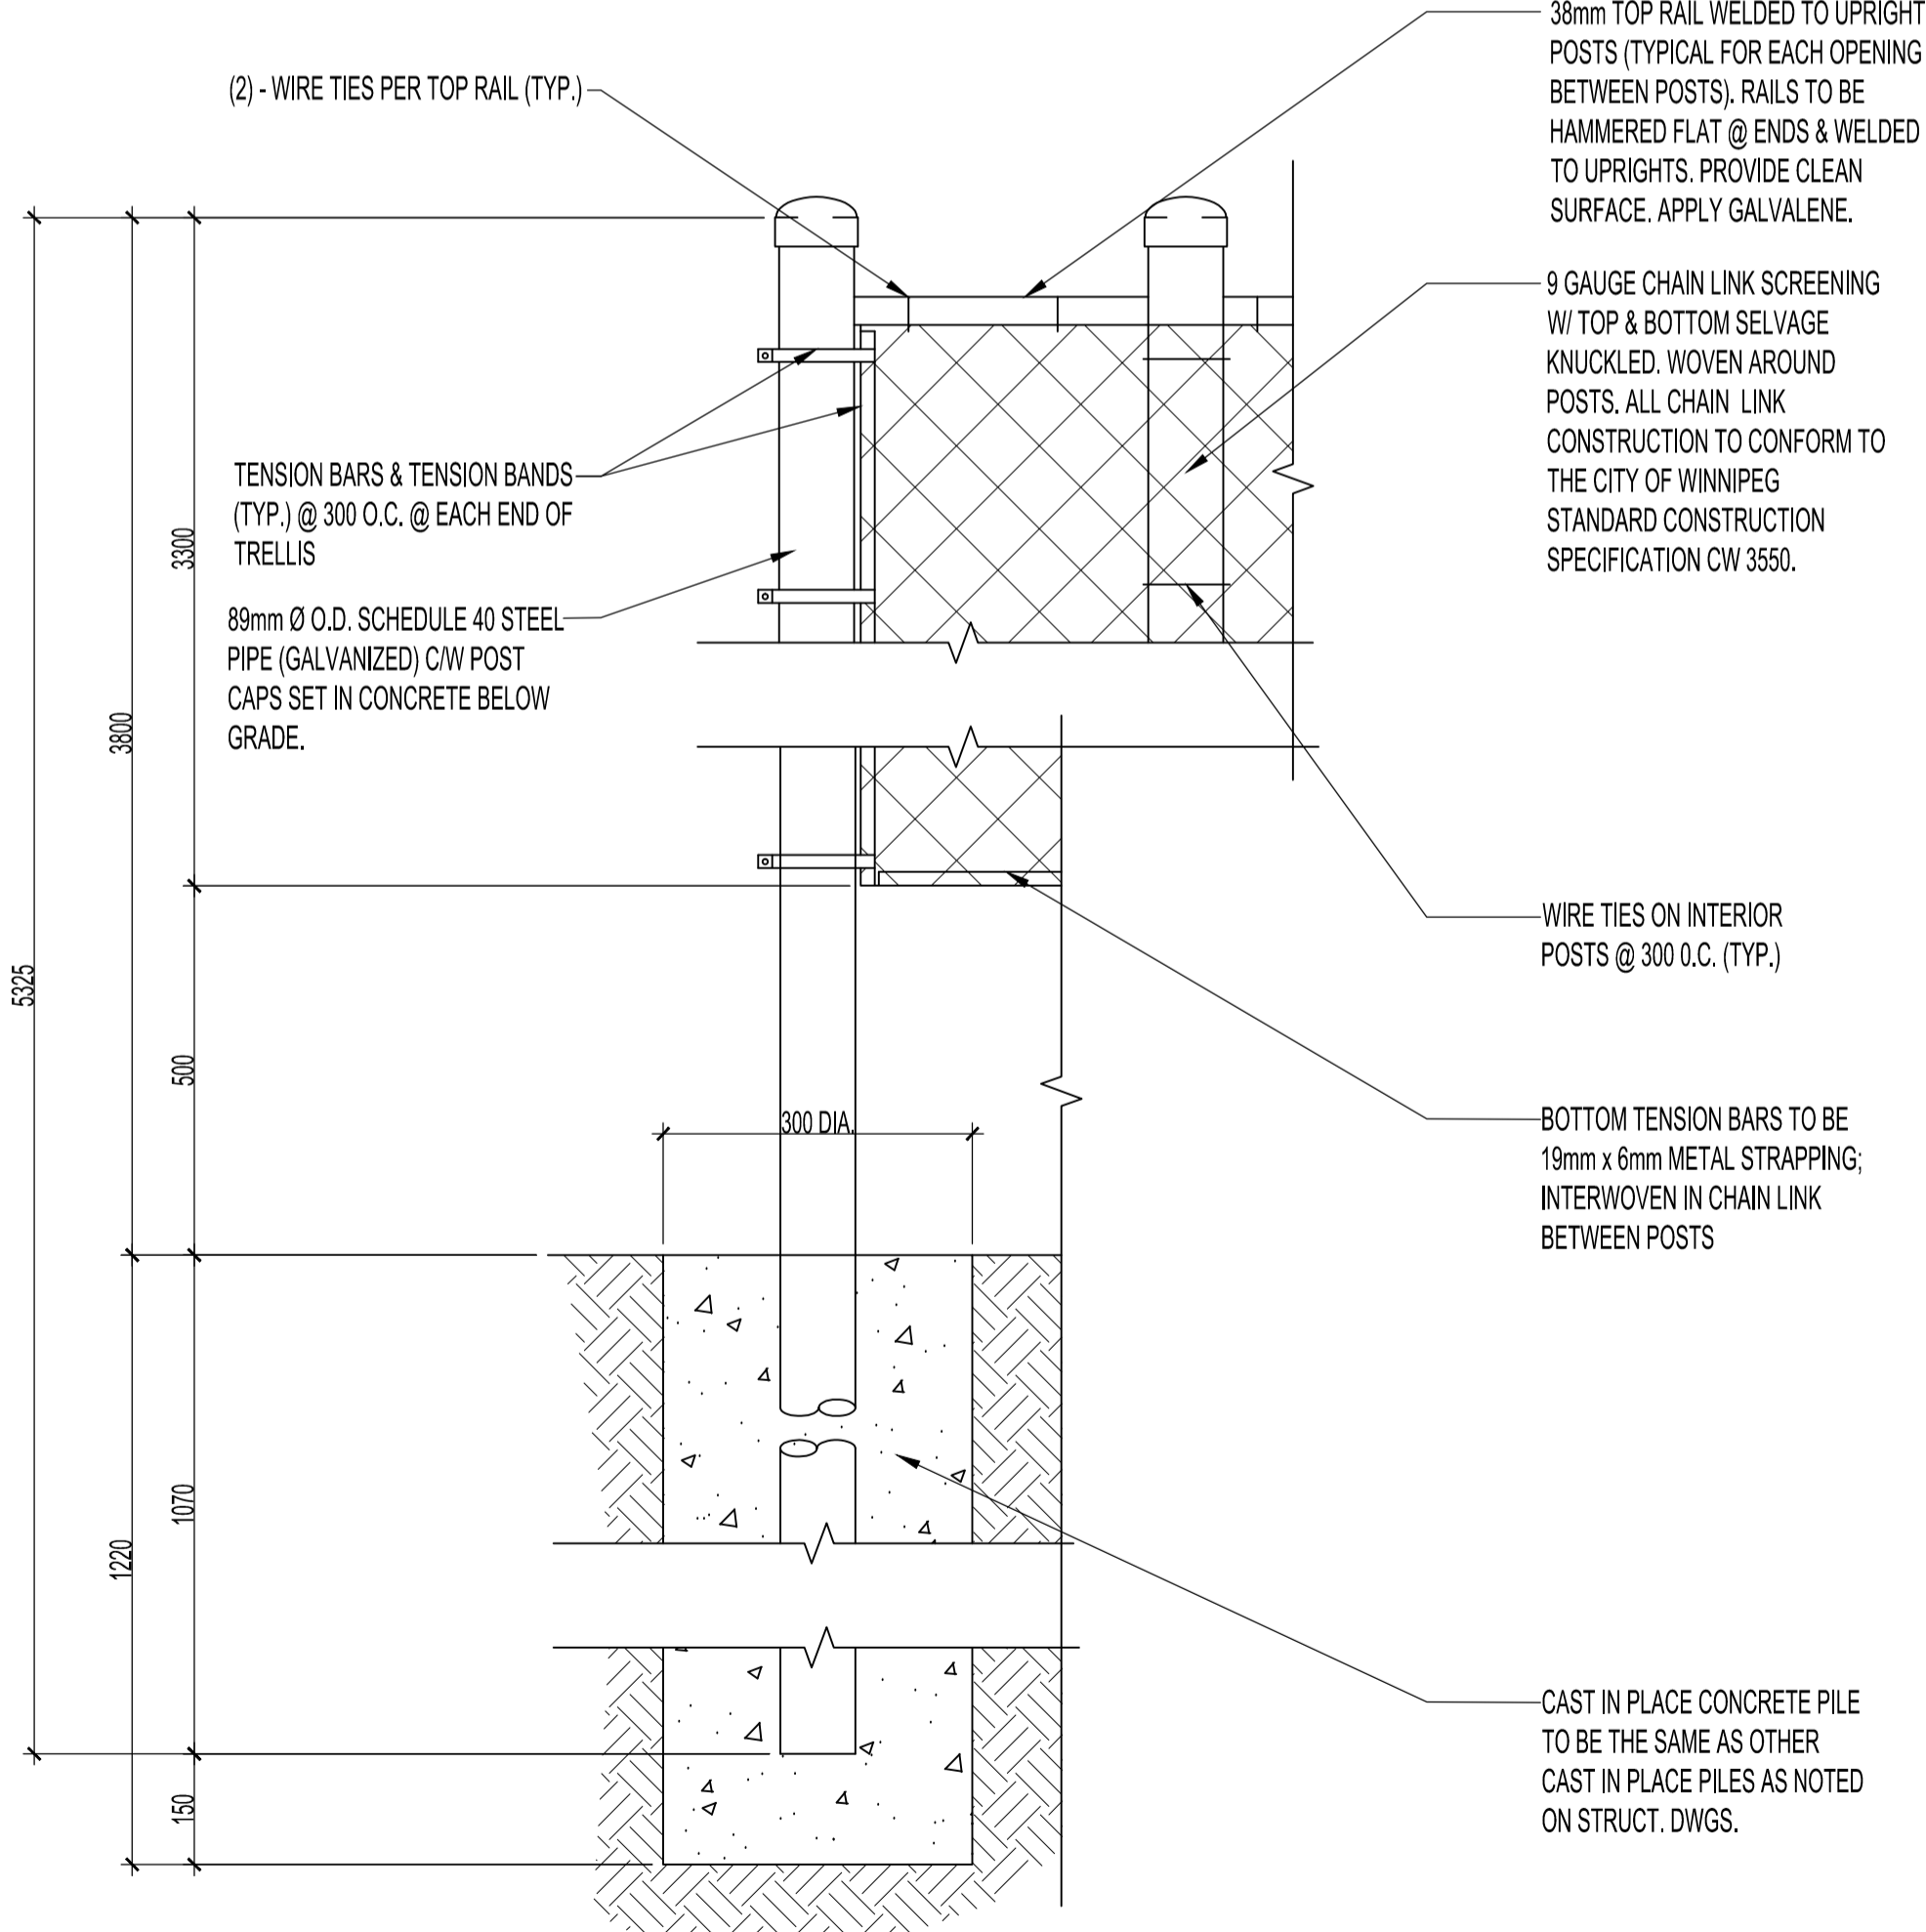

NOTE:
THIS DRAWING IS NOT IN CONTRACT. SEE DRAWING C1.2 FOR ITEMS IN CONTRACT.