

DOMESTIC WATER - DEMOLITION PLAN
1:200



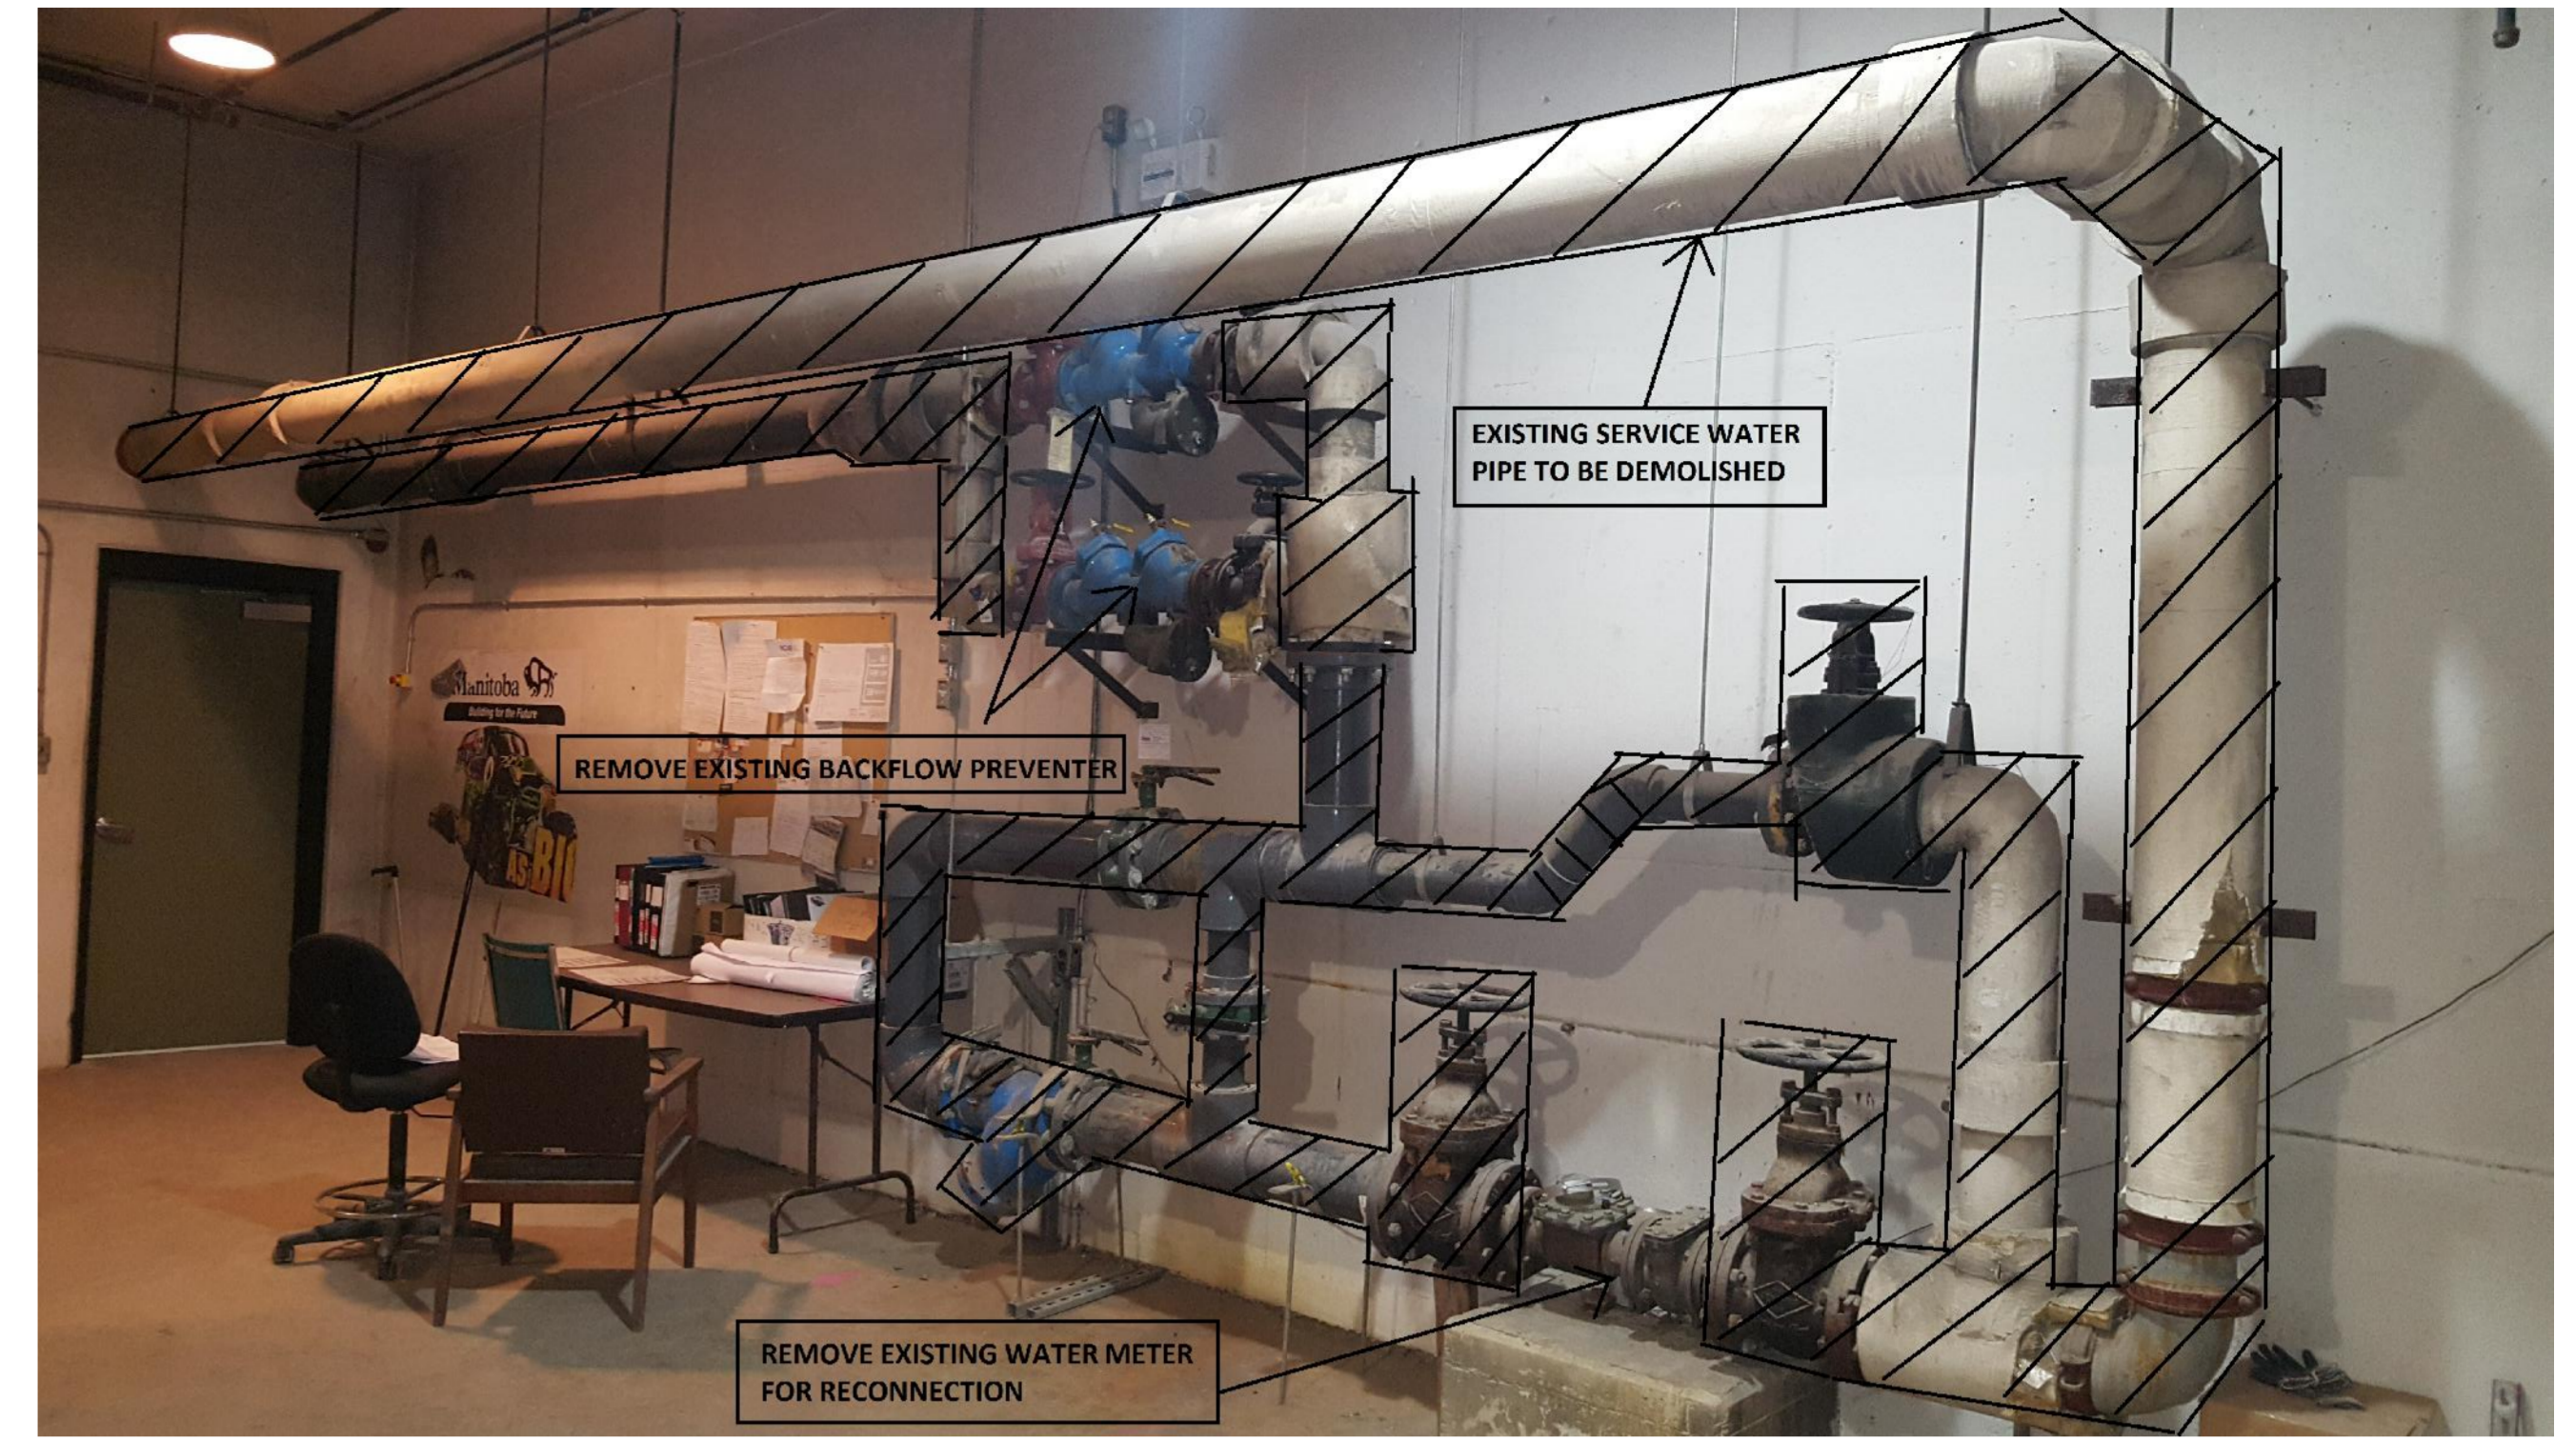


PHOTO 'A'
NTS

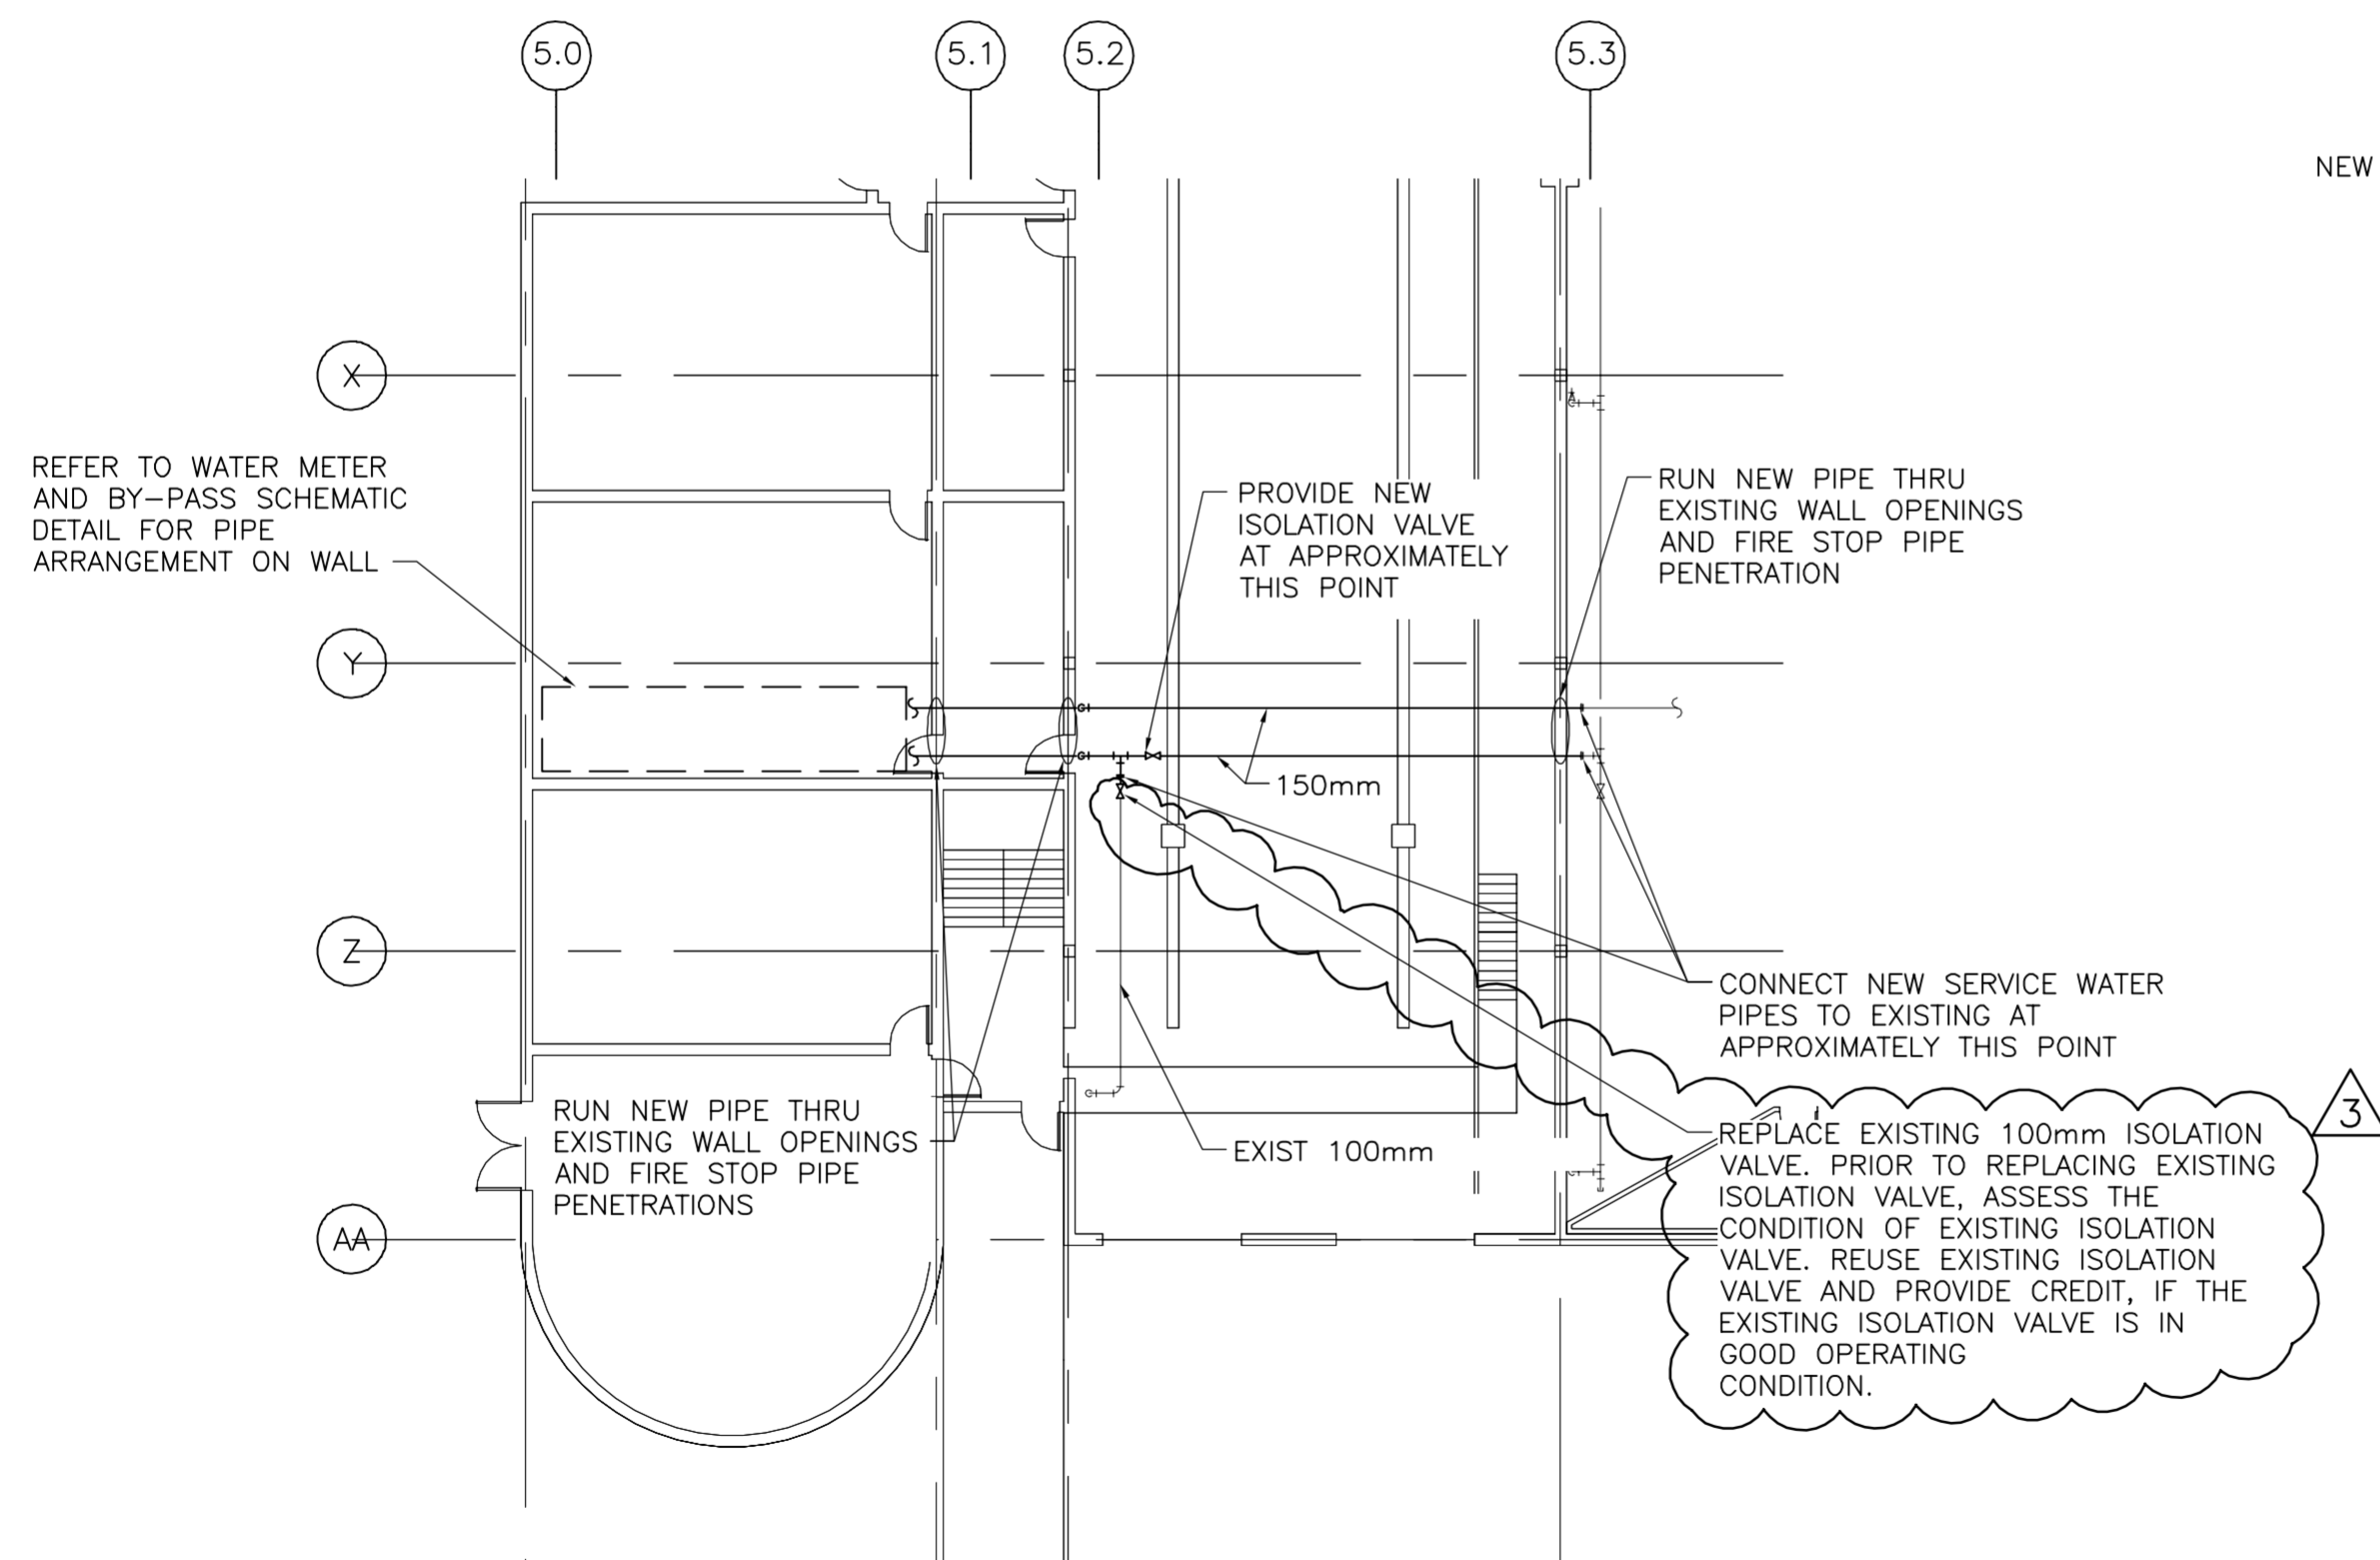


DOMESTIC WATER - NEW PIPING PLAN
1:200

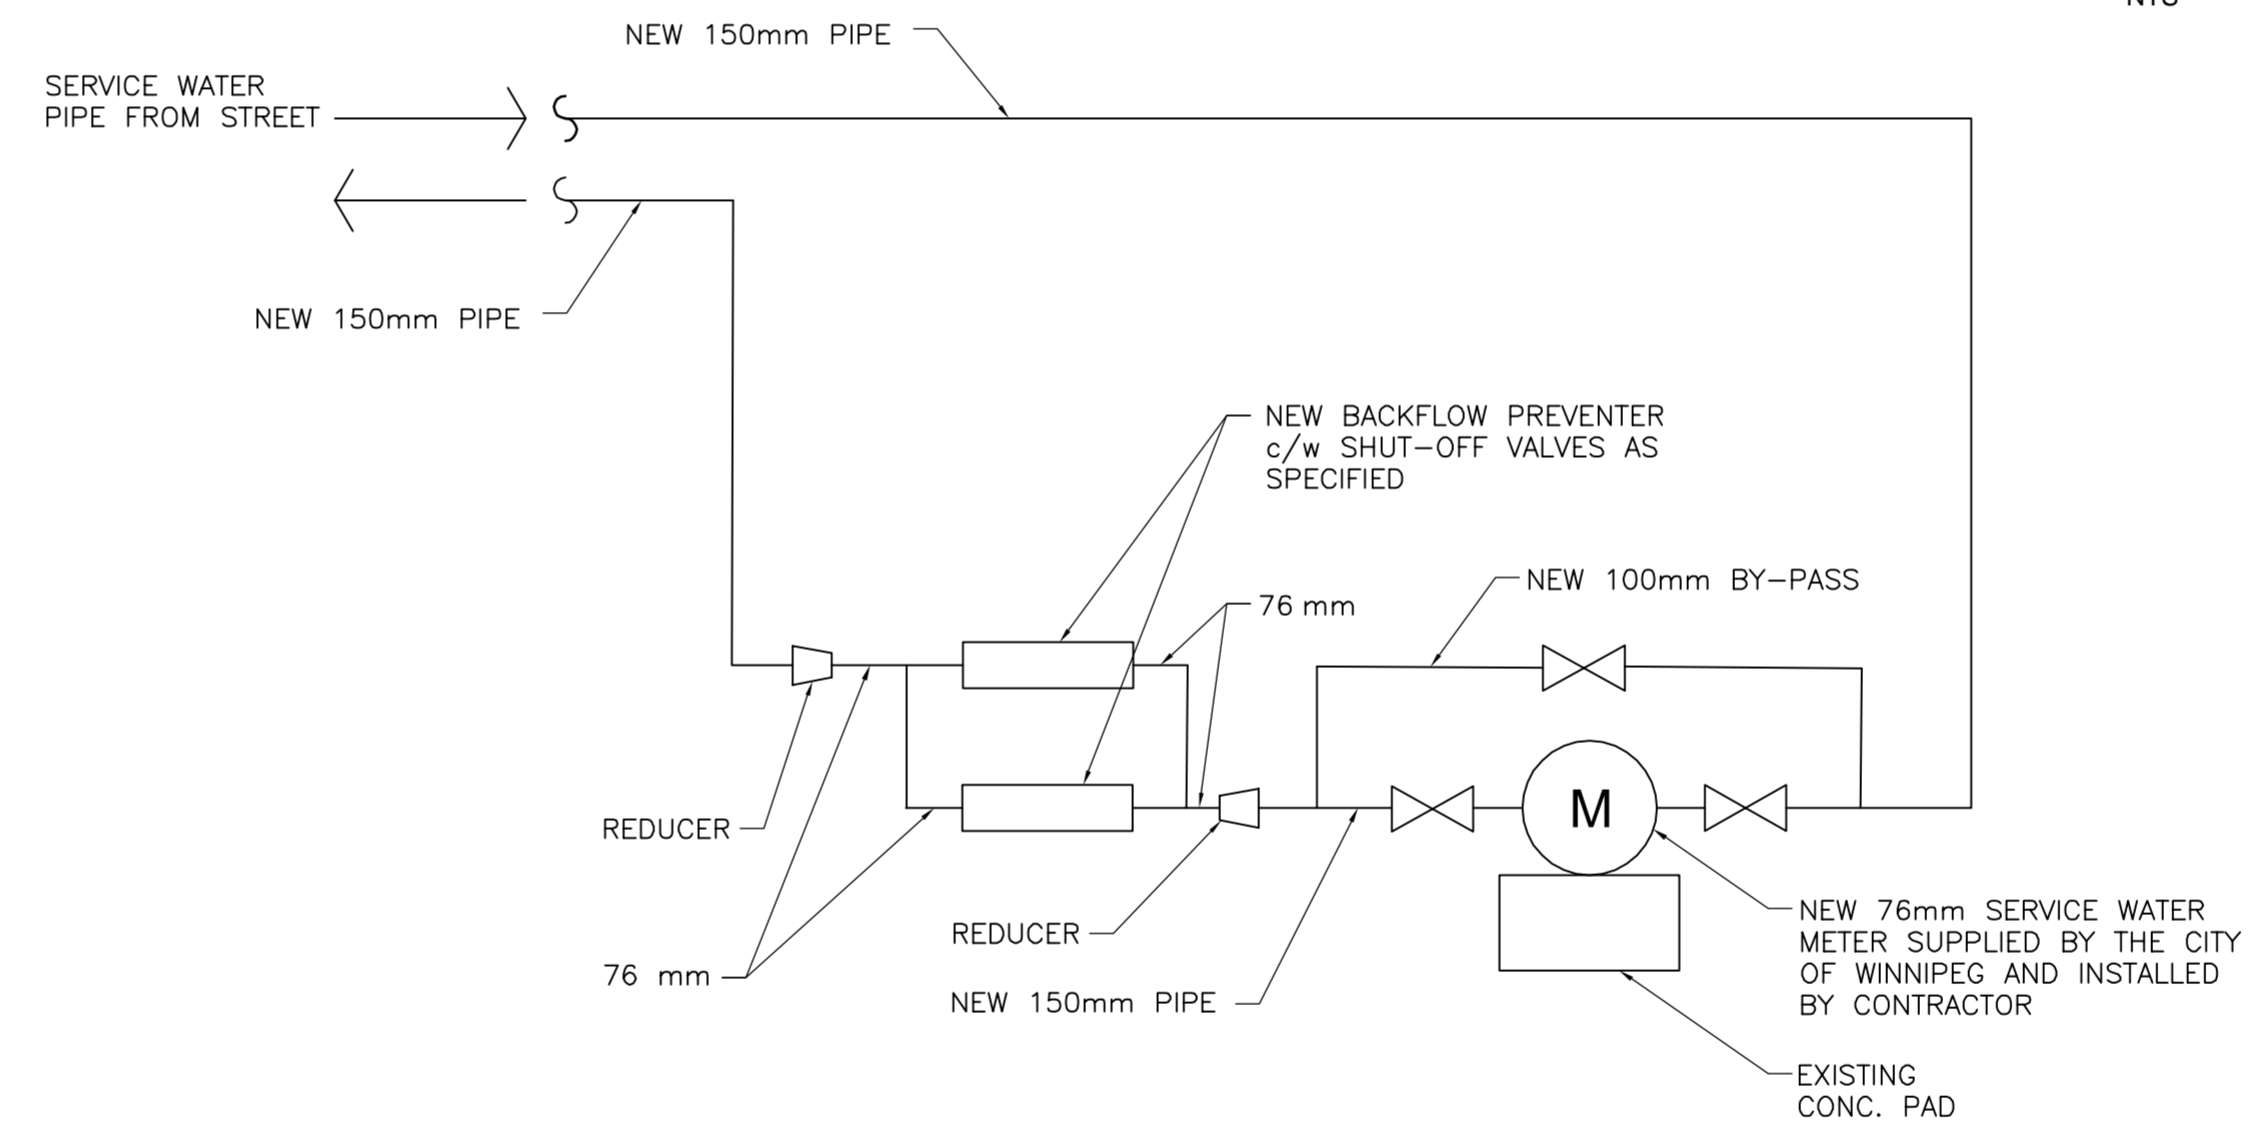

WATER AND BY-PASS SCHEMATIC DETAIL
NTS

GENERAL NOTE

1. ASSESS THE CONDITION OF EXISTING THREE BACKFLOW PREVENTERS. REUSE EXISTING BACKFLOW PREVENTERS AND PROVIDE CREDIT ACCORDINGLY, IF ANY OF THE THREE EXISTING BACKFLOW PREVENTERS ARE IN EXCELLENT CONDITION.
2. PROVIDE TEMPORARY PIPING TO MAINTAIN WATER SUPPLY TO THE BUILDING DURING CONSTRUCTION AND COORDINATE ALL WATER SUPPLY SHUT DOWNS WITH OWNER.

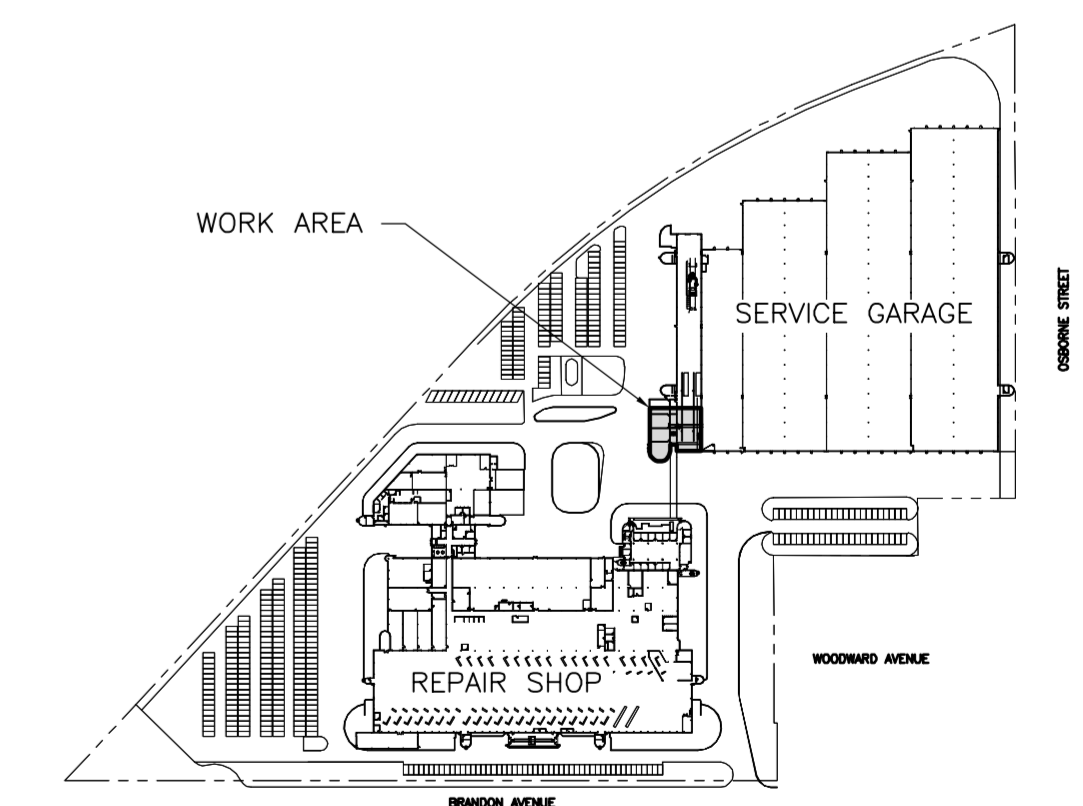

KEY PLAN
NTS

\\DILLON\CADD\CONTRACTS\149749_CITY OF WINNIPEG TRANSIT\07-MECHANICAL\01-CONTRACT\175195-07-MECH-DES.DWG



NO.	REVISIONS	DATE	BY	DATE
3	ADDENDUM #1	9/07/17	EP	
2	ISSUED FOR CONSTRUCTION	5/17/17	EP	
1	ISSUED FOR REVIEW	4/12/17	PDT	

DESIGNED BY	EP
DRAWN BY	JV
CHECKED BY	PDT
APPROVED BY	EP
HOR. SCALE	
VERTICAL	

DILLON CONSULTING

RELEASED FOR CONSTRUCTION

DATE

ENGINEER'S SEAL

PROVINCE OF MANITOBA

E. PLANIM

Member 30607

REGISTERED PROFESSIONAL ENGINEER

CONSULTANT PROJECT NO. 175195

THE CITY OF WINNIPEG
TRANSIT DEPARTMENT

WINNIPEG TRANSIT FT. ROUGE GARAGE
WATER MAIN P.O.E. UPGRADE

DEMOLITION AND NEW PIPING PLANS

CITY DRAWING NUMBER P-XXXX- ----
SHEET 1 OF 2
CONSULTANT DRAWING NUMBER M1