405

Ref. or Drawing No. 405 DETAILS

file # GC 10018

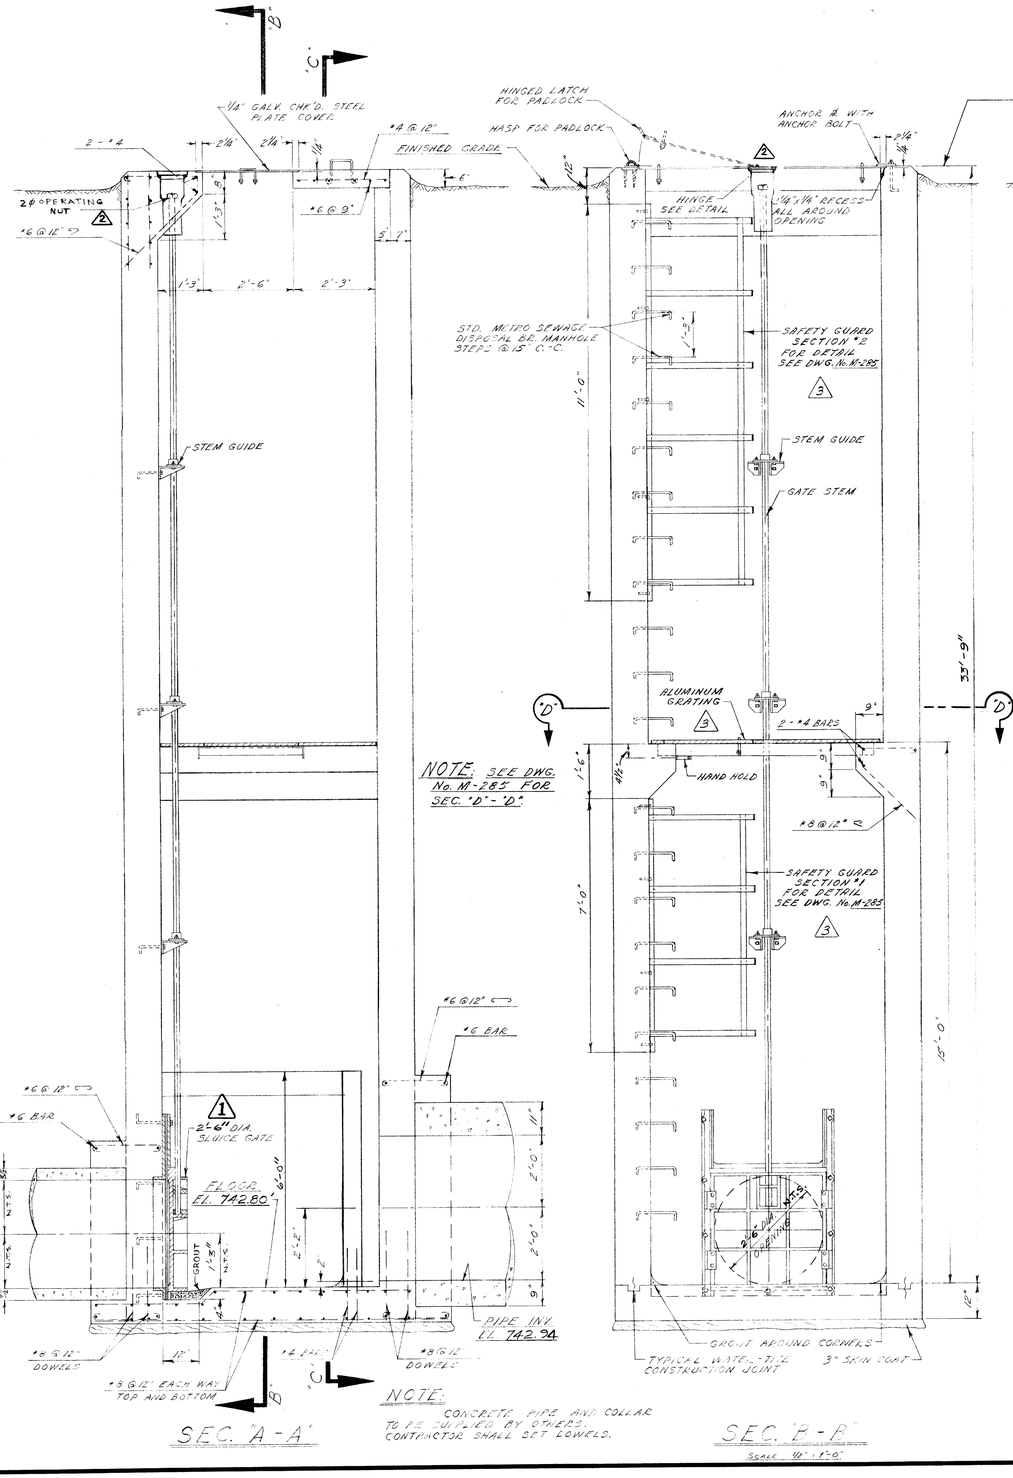

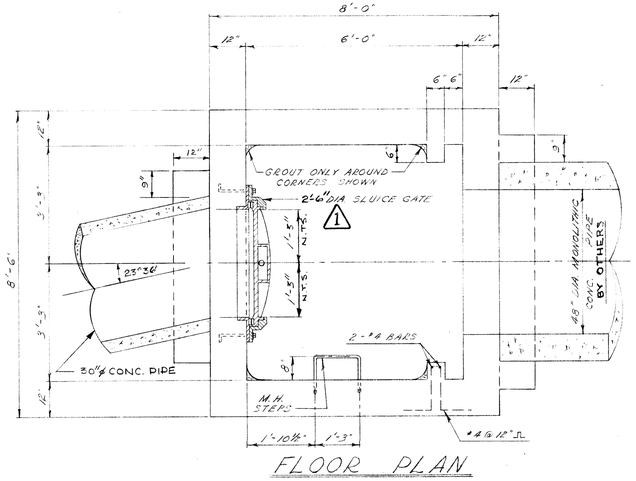

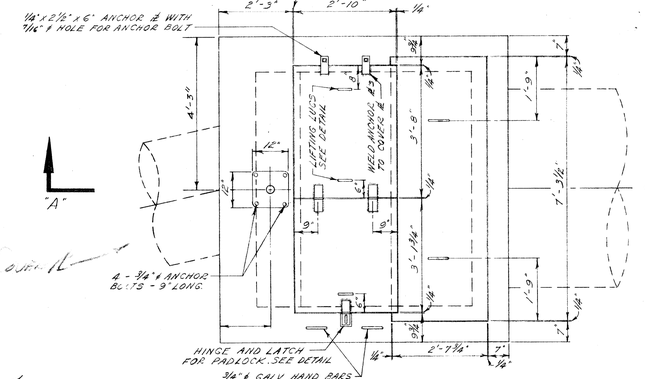

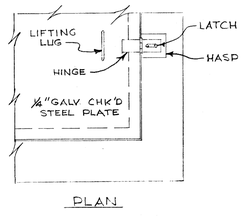

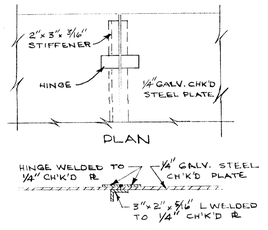

PROVINCE OF MANITOBA — E. H. KLASSEN — REGISTERED ENGINEER

PROVINCE OF MANITOBA — G. E. BURNS — REGISTERED ENGINEER

REVISIONS			
NO.	DESCRIPTION	DATE	BY
1	DIA. OF SLUICE GATE REVISED	AUG 2/63	K.H.B.
2	PEDESTAL LIFT FLOOR BOX PUT IN	DEC 9/63	A.C.
3	SAFETY GUARD + SAFETY PLAT. FORM ADDED COVER & REVISED.	19 DEC 63	S.K.
4			
5			
6			
7			
8			

THE METROPOLITAN CORPORATION OF GREATER WINNIPEG
WATERWORKS & WASTE DISPOSAL DIVISION
SEWAGE DISPOSAL BRANCH

CHARLESWOOD INTERCEPTOR
COMMUNITY ROW - GATE CHAMBER

APPROVED BY	DESIGNED BY	CHECKED BY	DRAWING NO.
CHIEF ENGINEER	DRAWN BY S.K. & K.H.B.	DATE APRIL 26/63	405
	SCALES AS SHOWN		

Micro-Filmed 1965