ISO A1 - 594mm x 841mm

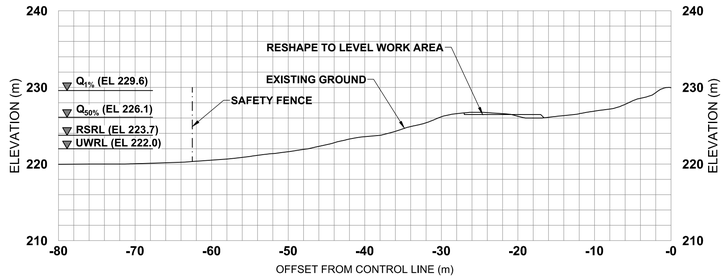

A 01 03 **CROSS SECTION AT STA. 8+00.00**

SCALE: 1:400

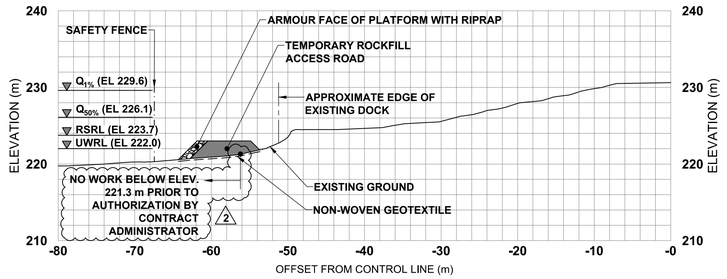

D 01 03 **CROSS SECTION AT STA. 9+65.00**

SCALE: 1:400

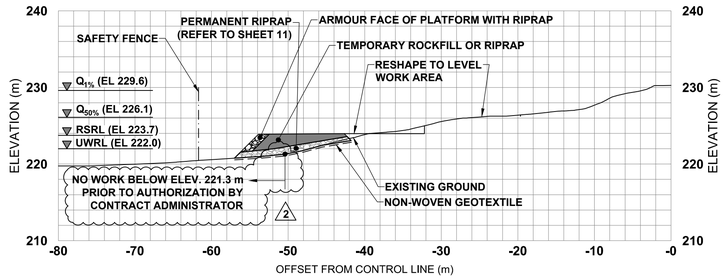

B 01 03 **CROSS SECTION AT STA. 8+90.00**

SCALE: 1:400

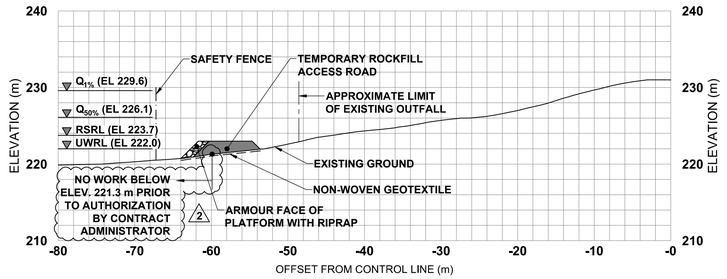

E 01 03 **CROSS SECTION AT STA. 10+18.91**

SCALE: 1:400

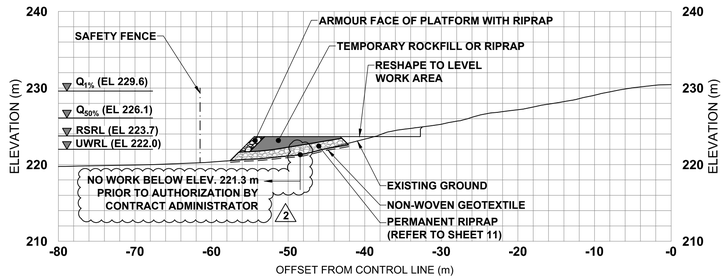

C 01 03 **CROSS SECTION AT STA. 9+10.00**

SCALE: 1:400

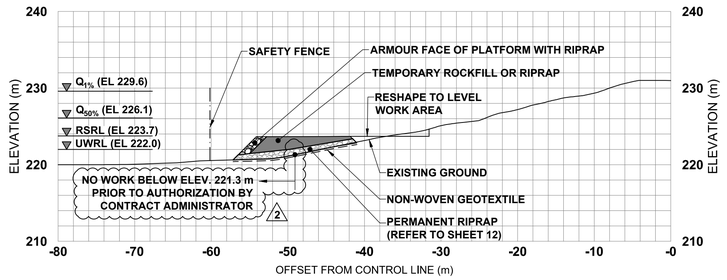

F 01 03 **CROSS SECTION AT STA. 11+00.00**

SCALE: 1:400

NOTES:

1. RSRL = REGULATED SUMMER RIVER LEVEL
2. UWRL = UNREGULATED WINTER RIVER LEVEL
3. $Q_{1\%}$ = ANNUAL FLOOD LEVEL WITH RETURN PERIOD OF 1 IN 100 YEARS
4. $Q_{50\%}$ = ANNUAL FLOOD LEVEL WITH RETURN PERIOD OF 1 IN 2 YEARS

Certificate of Authorization
Trek Geotechnical Inc.
No. 4877 Date:_____

BID OPPORTUNITY No. 754-2017

METRIC

WHOLE NUMBERS INDICATE MILLIMETRES
DECIMALIZED NUMBERS INDICATE METRES

EXISTING	LEGEND - PLAN	NEW	EXISTING	LEGEND - PLAN	NEW	EXISTING	LEGEND - PLAN	NEW
	GAS		○	MANHOLE	●		CONCRETE PAVEMENT	
MTS	MTS HANDWELL/PEDESTAL		□	CATCH BASIN/CATCH PIT	■		CONC SIDEWALK/MEDIAN	
HD	HYDRO HANDWELL/CABINET		△	CURB INLET WITH BOX	▲		ASPHALT PAVEMENT	
	CATV/FIBRE OPTIC			TREE			PAVING STONE	
	TRAFFIC SIGNALS/PIT		TH-12	TEST HOLE			GRAVEL	
	LAND DRAINAGE SEWER			PROPERTY LINE			RAMP CURB	
	SANITARY/COMBINED SEWER			SURVEY BAR			PLANING/REMOVAL	
	CB LEAD/SSP/DCP			FENCE				
	WATERMAIN			BOC/EDGE OF PAVEMENT				
	SUBDRAIN		33.000	ELEVATION	33.333			
	DITCH			TRAFFIC SIGN				

LOCATION APPROVED
UNDERGROUND STRUCTURES

SUPR. U/G STRUCTURES COMMITTEE _____ DATE _____

NOTE:
LOCATION OF UNDERGROUND STRUCTURES AS SHOWN ARE BASED ON THE BEST INFORMATION AVAILABLE BUT NO GUARANTEE IS GIVEN THAT ALL EXISTING UTILITIES ARE SHOWN OR THAT THE GIVEN LOCATIONS ARE EXACT. CONFIRMATION OF EXISTENCE AND EXACT LOCATION OF ALL SERVICES MUST BE OBTAINED FROM THE INDIVIDUAL UTILITIES BEFORE PROCEEDING WITH CONSTRUCTION.

BM
ELEV

No.	REVISIONS	YY/MM/DD	BY
1	ISSUED FOR ADDENDUM 2	17/11/08	JGK
0	ISSUED FOR TENDER	17/10/13	JGK

TREK GEOTECHNICAL

DESIGNED BY	MVH	CHECKED BY	KMS
DRAWN BY	KMB	APPROVED BY	BWB
HOR SCALE	AS NOTED	RELEASED FOR CONSTRUCTION	
VERT SCALE			
DATE	17/10/13	DATE	

PROFESSIONAL'S SEAL
PROVINCE OF MANITOBA
M. J. VAN HELDEN
Member 24729
REGISTERED PROFESSIONAL ENGINEER

CONSULTANT FILE NAME
5170563-Tache-SW-03.dwg

Winnipeg

THE CITY OF WINNIPEG
PUBLIC WORKS DEPARTMENT
ENGINEERING DIVISION

TACHE PROMENADE

TACHE AVENUE
TEMPORARY ACCESS & WORKING PLATFORMS
SECTIONS

CITY DRAWING NUMBER: B250-17-11
SHEET 11 OF 70
DRAWING No. 03 REV 1

O:\Winnipeg\Proj\5170563\09. Drawings\05. Design\06. Sheets\Detailed Design\Stabilization Works\5170563-Tache-SW-03.dwg Last Saved: 11/7/2017 2:46 PM by AHepponer Plotted: 11/7/2017 3:04 PM by Alex Hepponer