WO 101-84

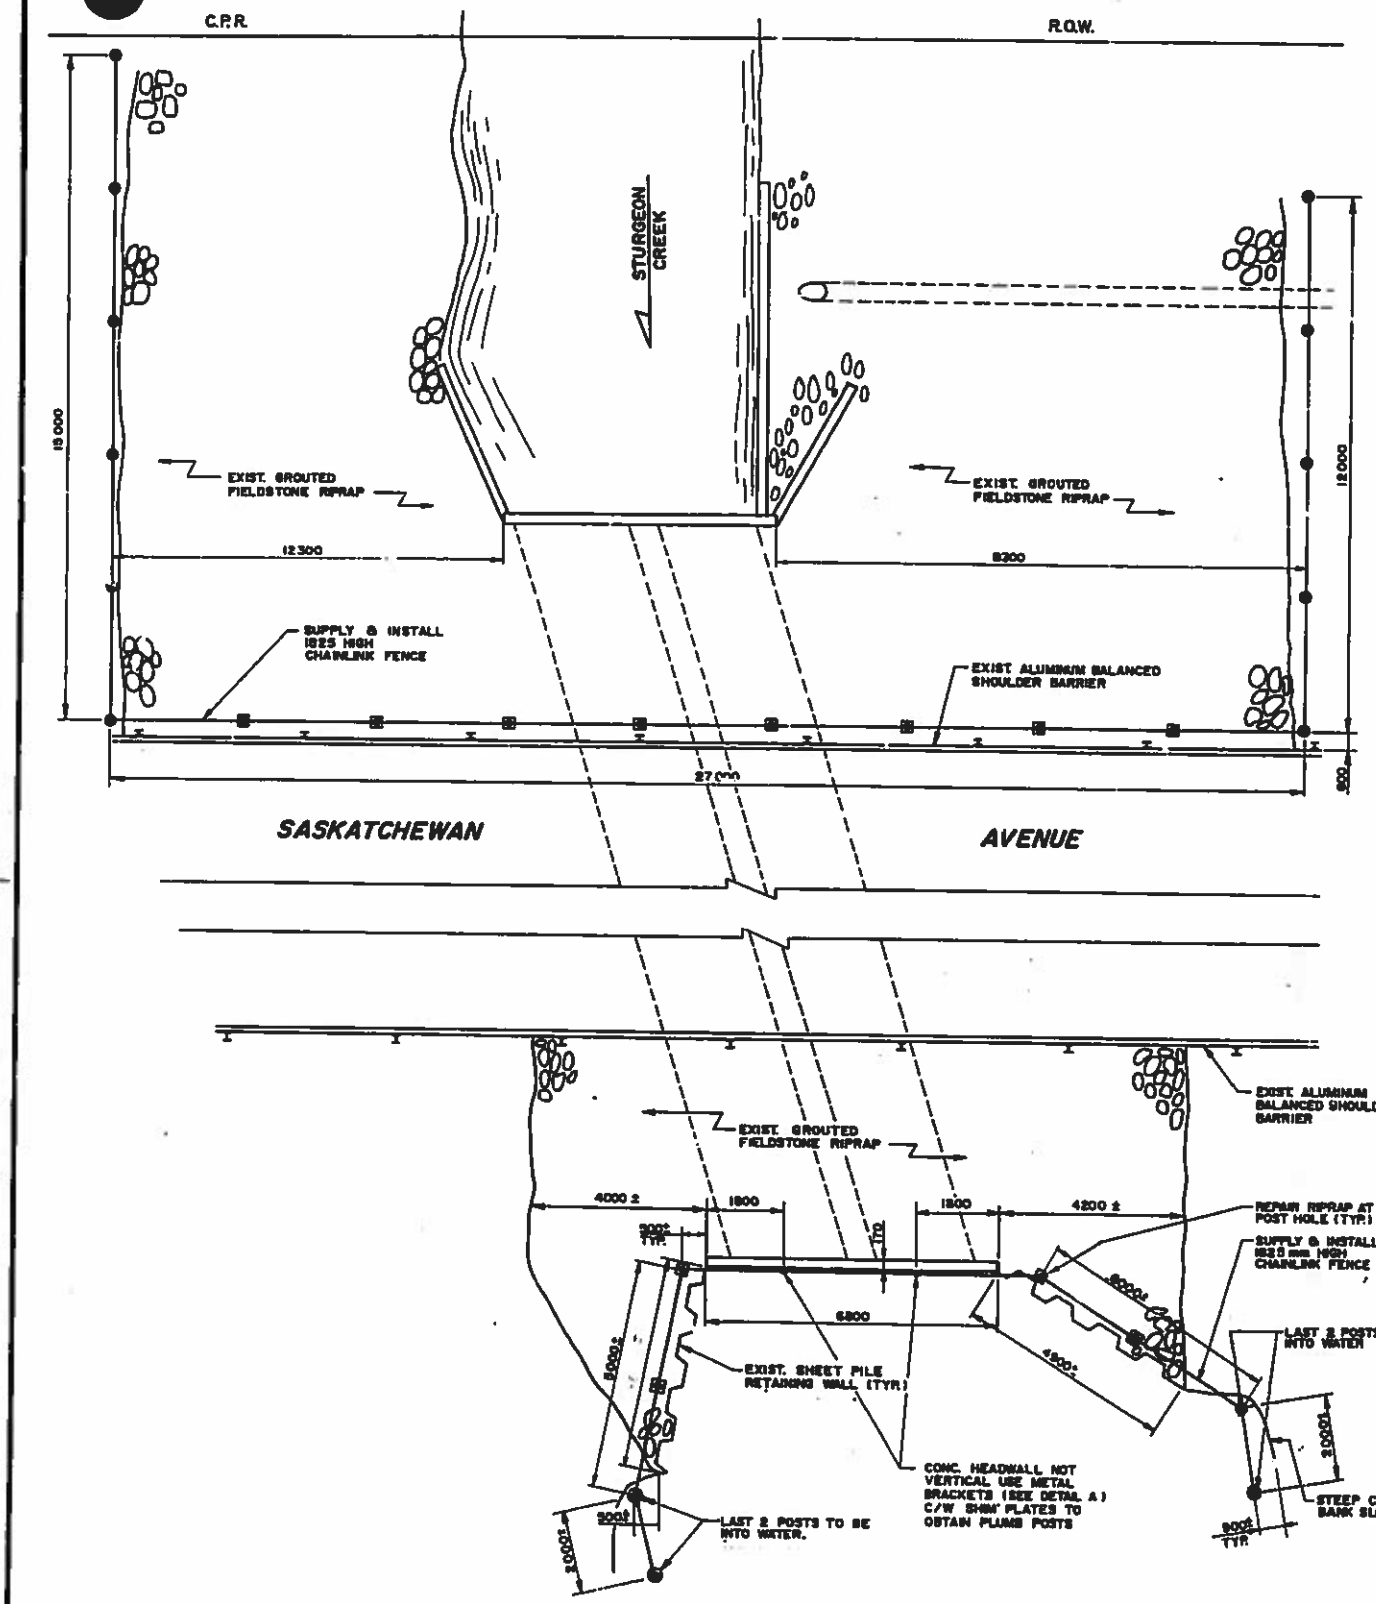

PLAN

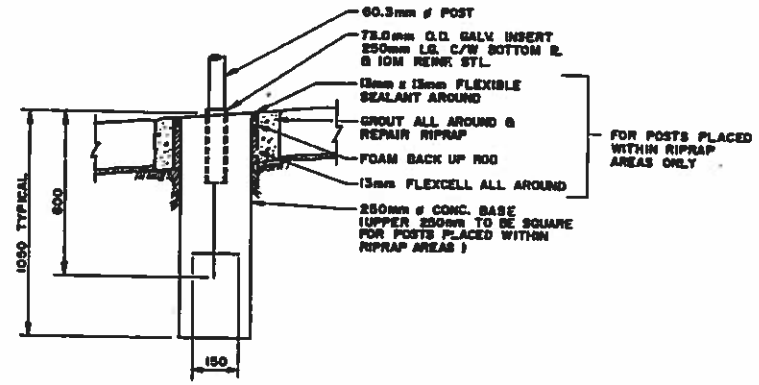

TYPICAL POST INSTALLATION DETAIL

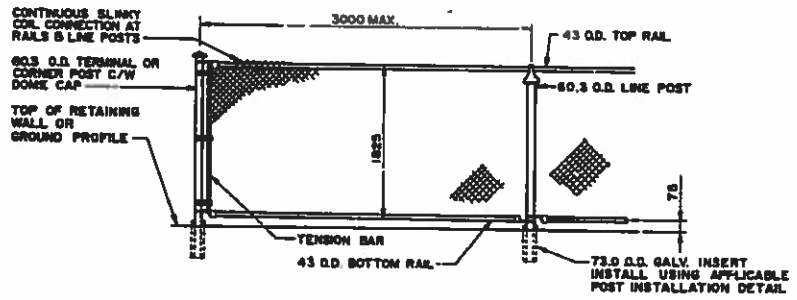

CHAINLINK FENCE INSTALLATION DETAIL

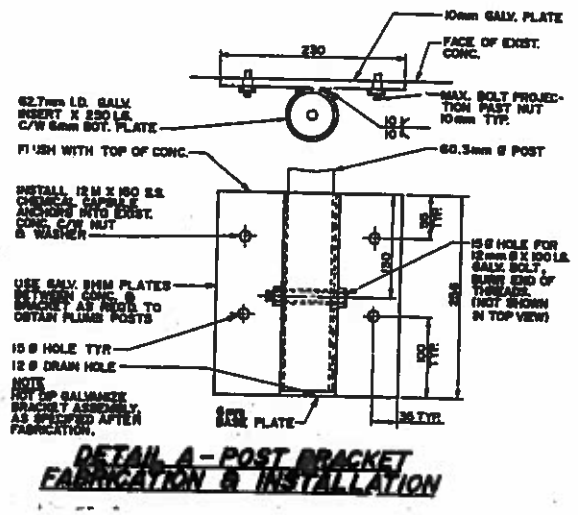

DETAIL A - POST BRACKET FABRICATION & INSTALLATION

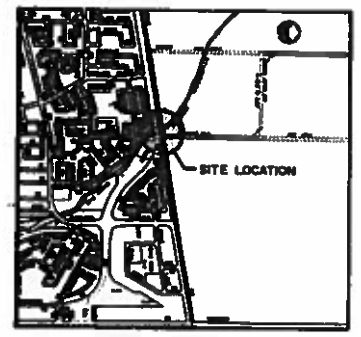

LOCATION PLAN

NOTES:

1. THE NUMBER OF FENCE POSTS SHOWN WITHIN RIPRAP AREAS MAY NOT BE ACCURATE.
2. ALL FENCING TO BE GALVANIZED, AS SPECIFIED, AND TOUCHED UP USING THE GALVALOT PROCESS.
3. POSTS ARE TO BE LOADED INTO STEEL POST INSERTS.
4. ALL FENCING IS TO HAVE A SMOOTH PROFILE.
5. NO SHARP POINTS TO REMAIN ON WIRE MESH FABRIC.

RECORD DRAWING
APPROVED BY: [signature] DATE 89 11 07

B.M. ELEV.			
NO.	REVISIONS	DATE	BY

BILLON
Consulting Engineers · Planners
Environmental Scientists

DESIGNED BY B.A.N.	CHECKED BY R.A.W.
DRAWN BY B.K.B.	APPROVED BY R.A.W.
HOR. SCALE VERTICAL N.T.S.	
DATE JULY 1988	

ENGINEER'S SEAL
18.0222
PROFESSIONAL ENGINEER
CONSULTANT DRAWING NO.

THE CITY OF WINNIPEG
WORKS AND OPERATIONS DIVISION

1988 BRIDGE MAINTENANCE
MISCELLANEOUS REHABILITATION WORKS
PHASE I

SASKATCHEWAN AVE. AT STURGEON CREEK
CHAINLINK FENCING

CITY DRAWING NUMBER C309-88-01
SHEET 1 OF 1

B-5796