




Rev. No.	Date	Revision Notes
1	2017.11.28	Issued for Construction
2	2018.01.30	Issued for Addendum 03

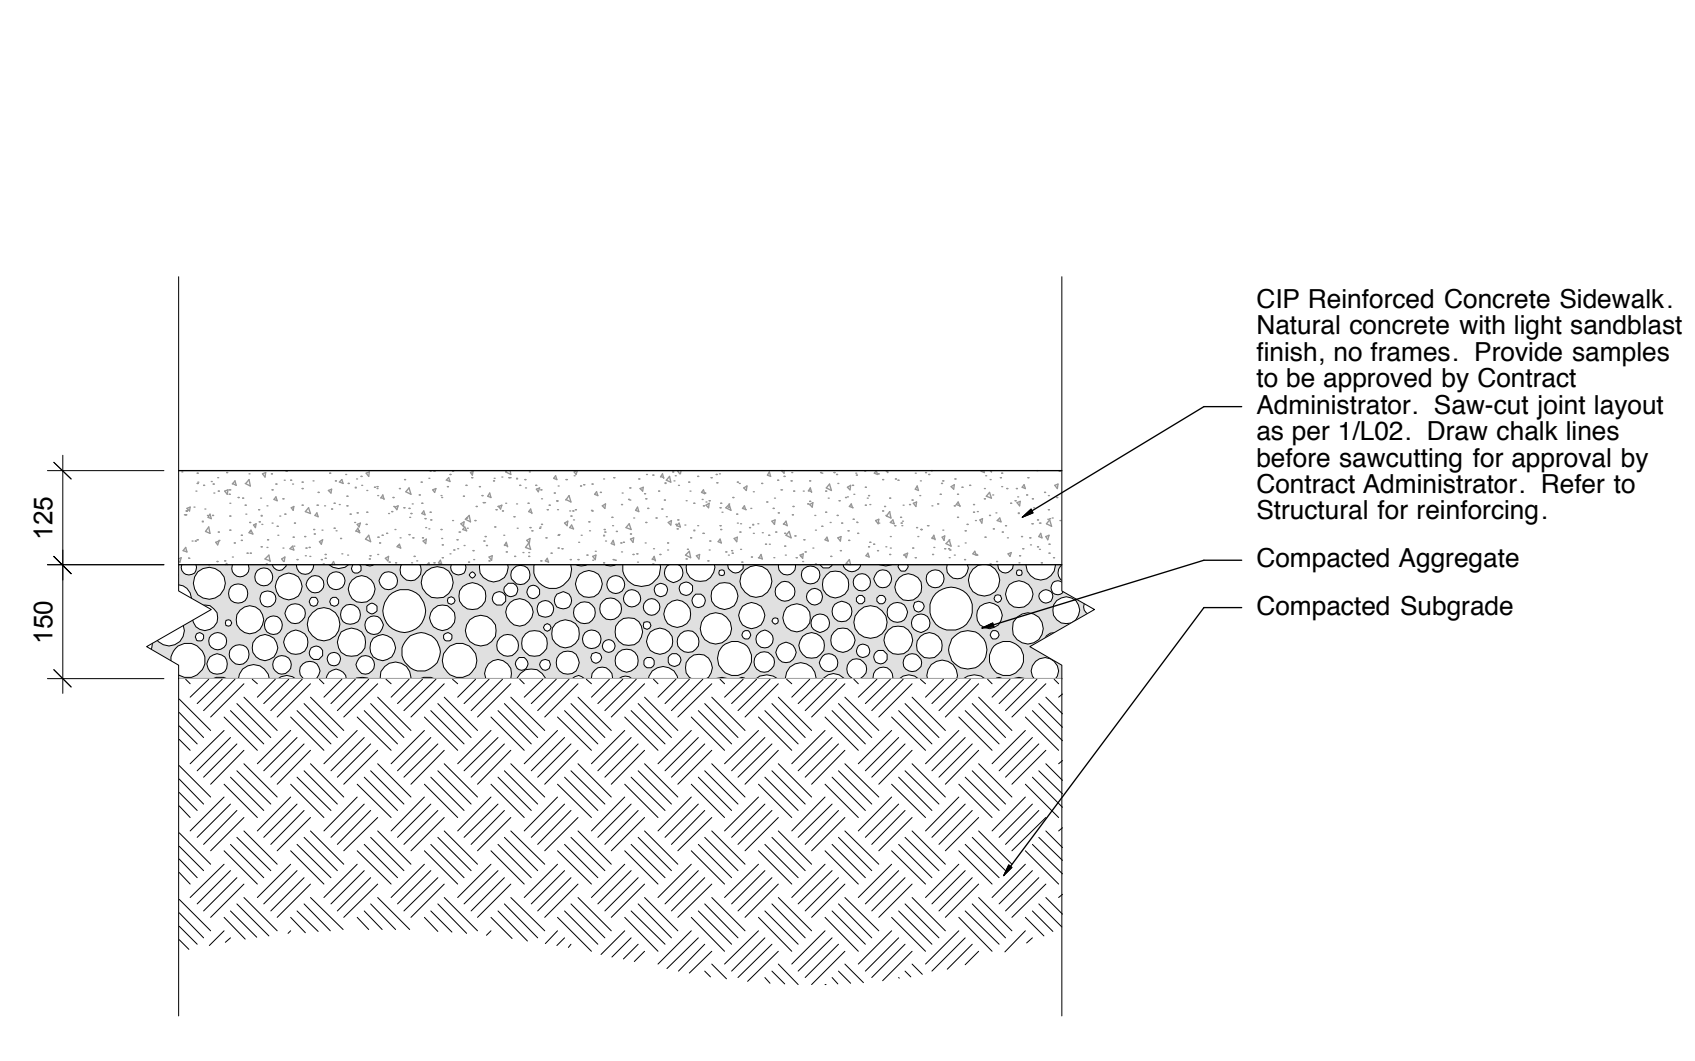


1 C.I.P. Concrete Paving, Typ.
Scale: 1:10

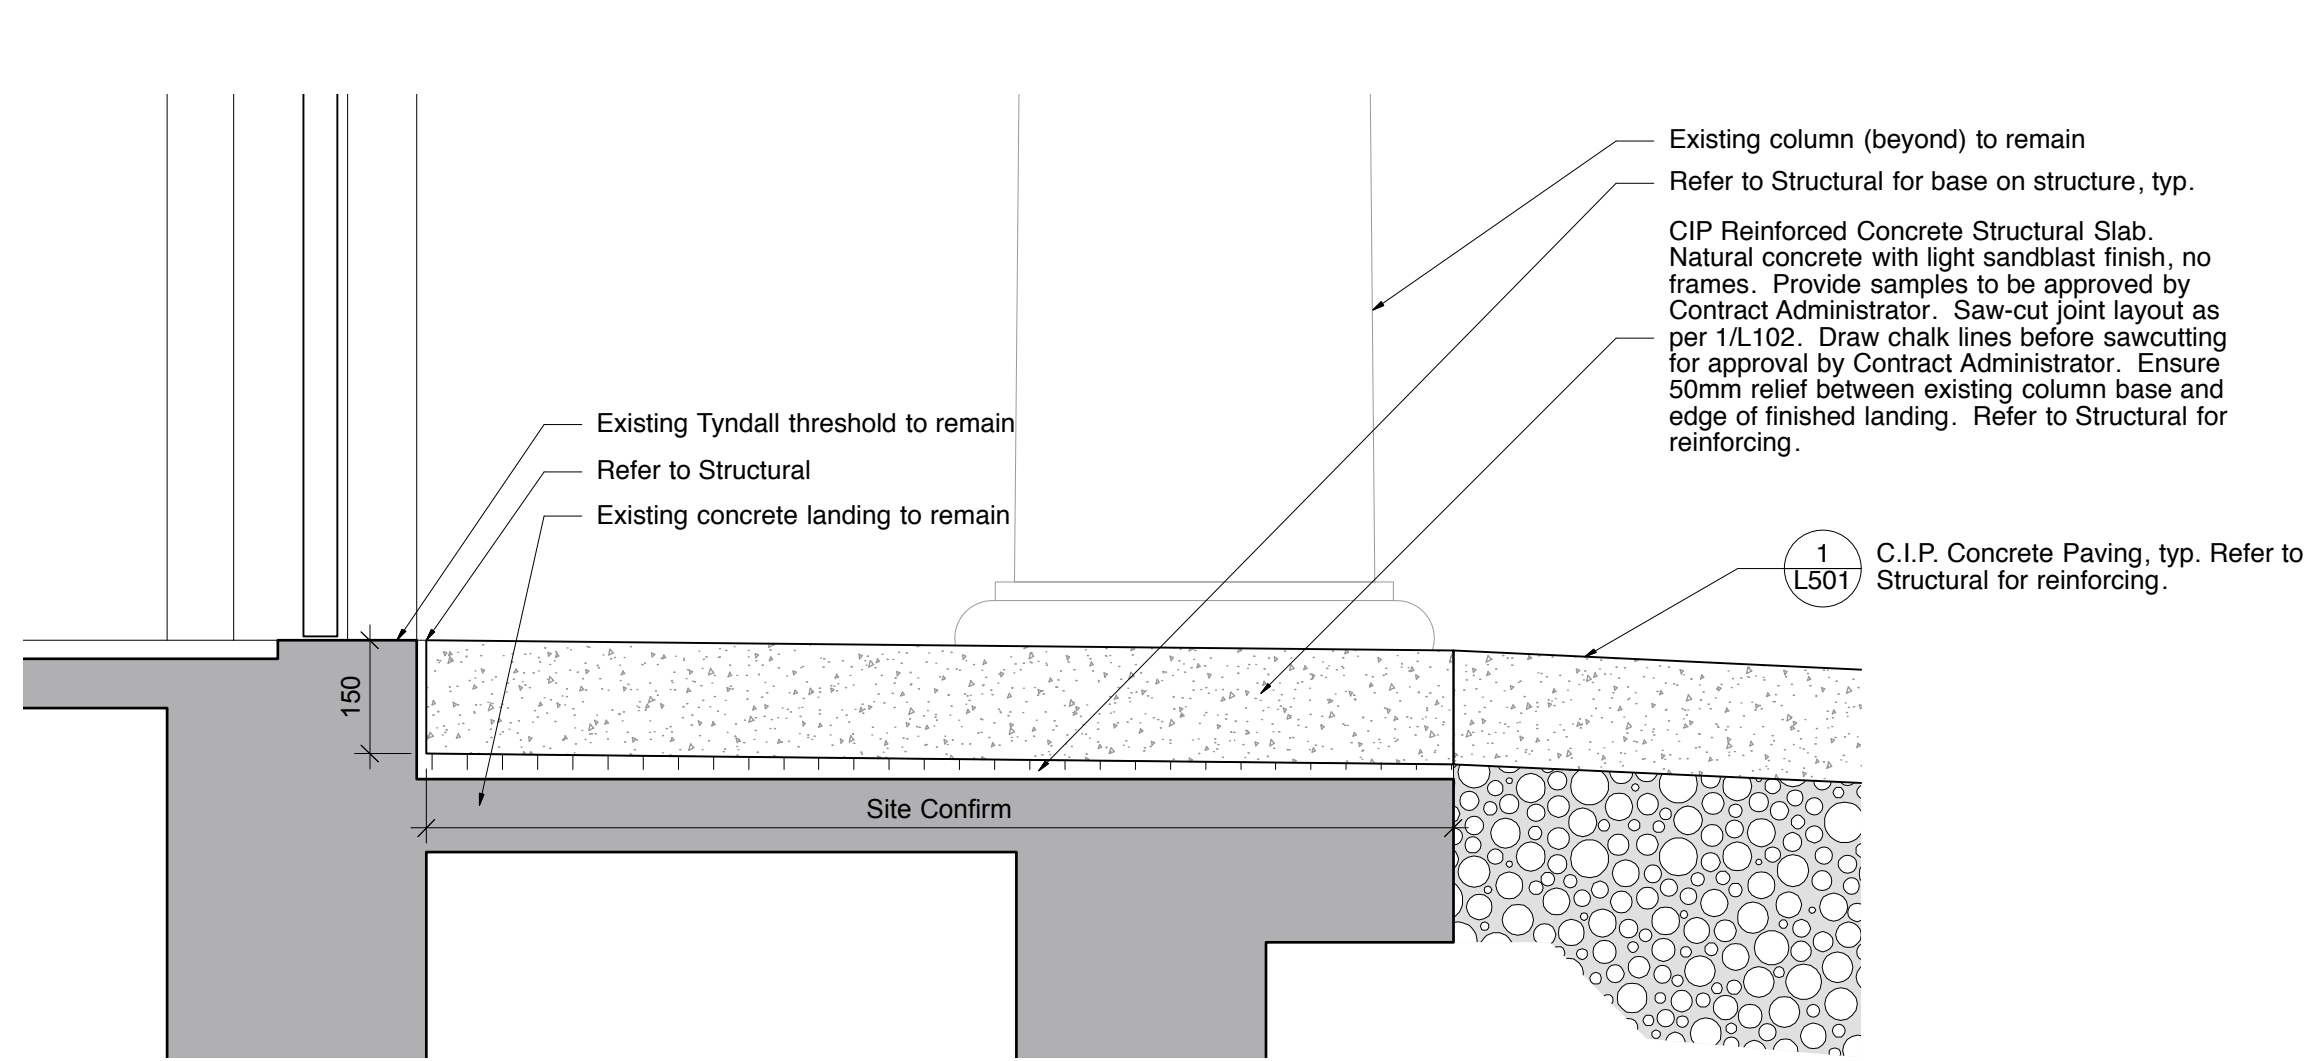


2 C.I.P. Concrete Landing at Building Entry
Scale: 1:10

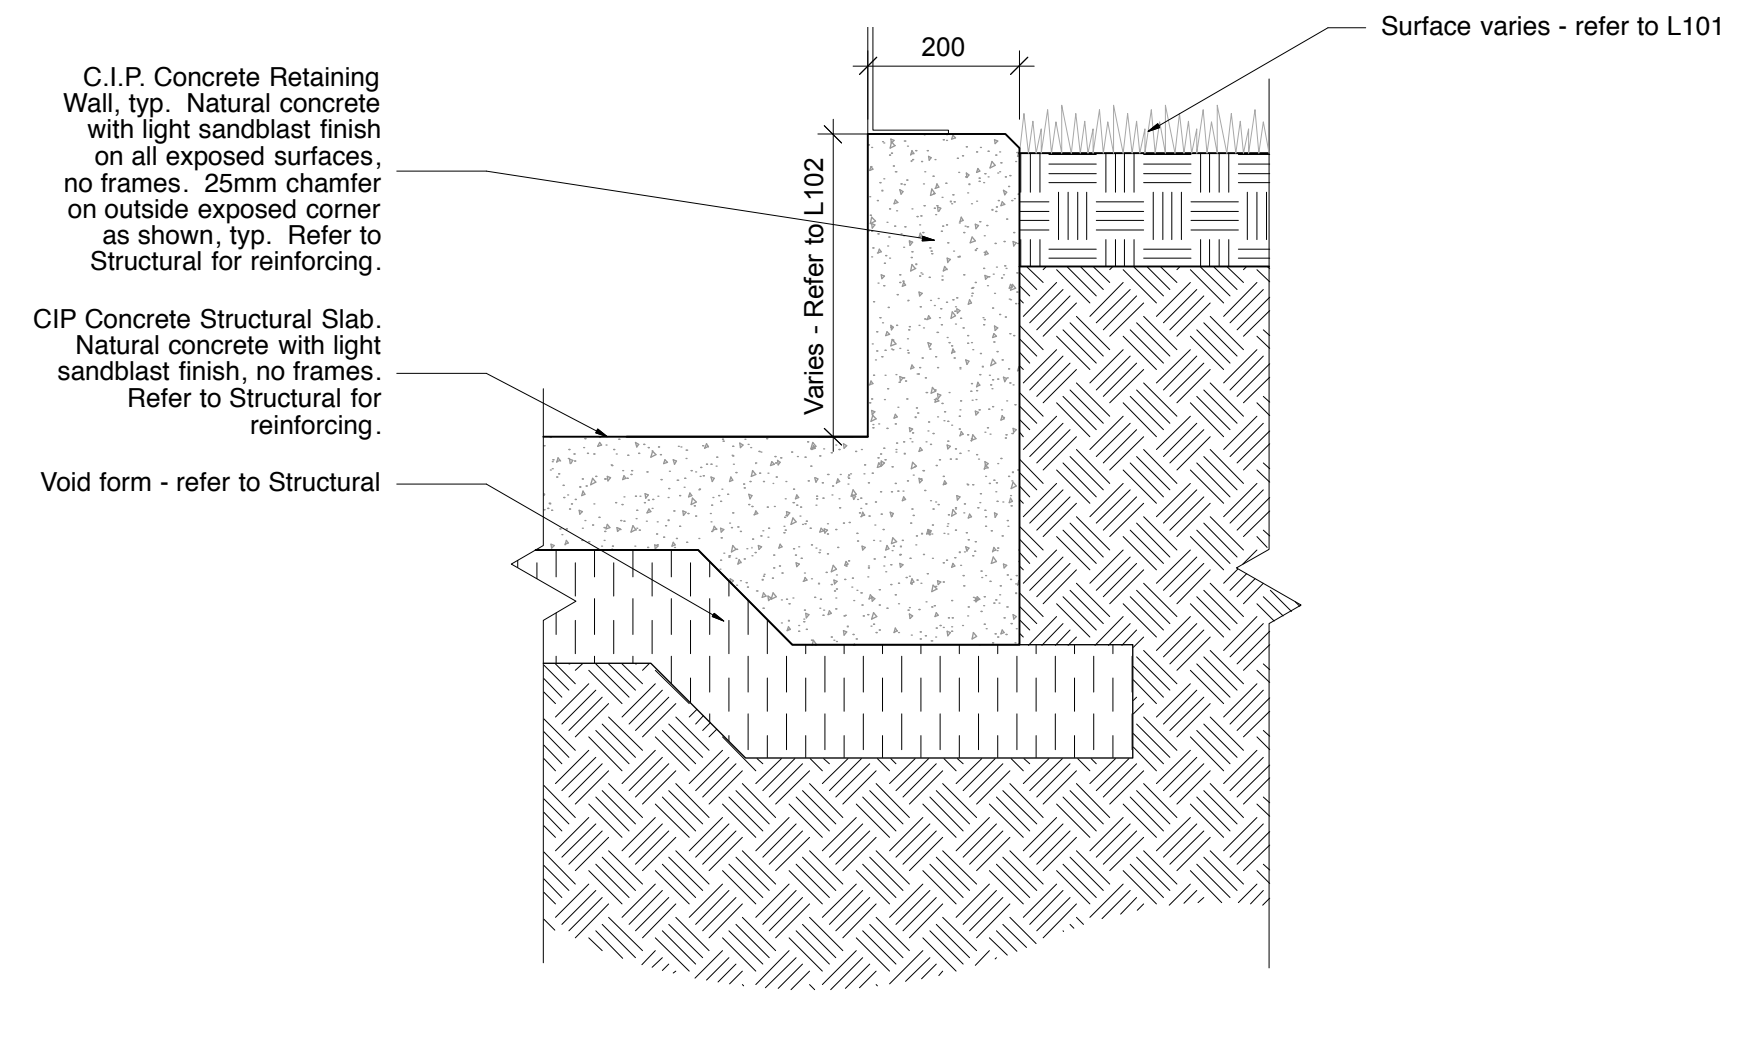


3 C.I.P. Concrete Retaining Wall
Scale: 1:10

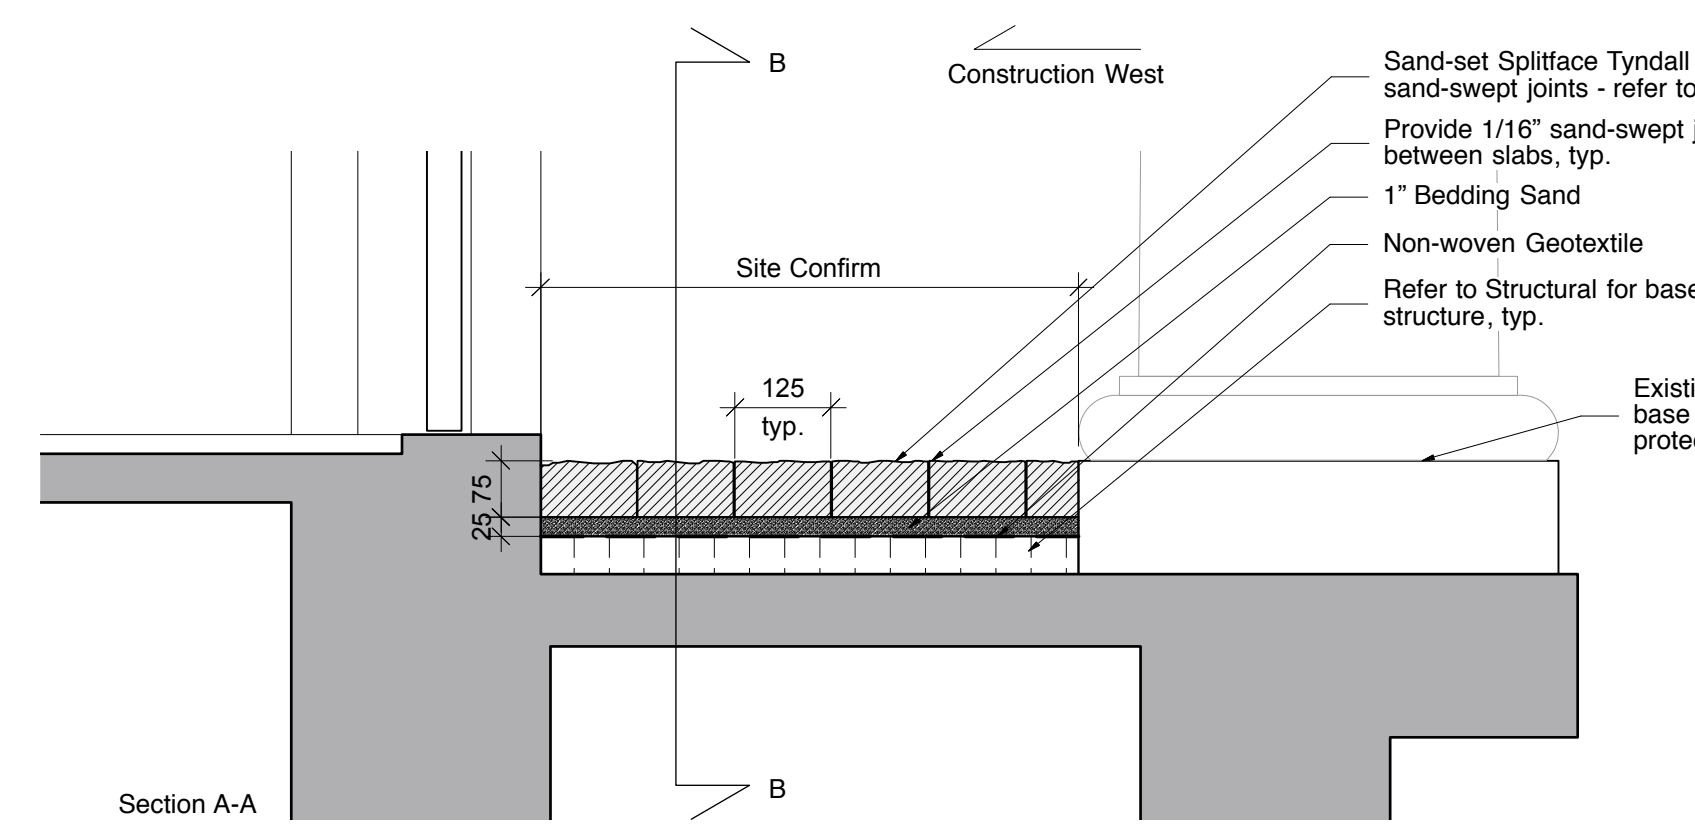


4 Tyndall Pavers on Structure
Scale: 1:10

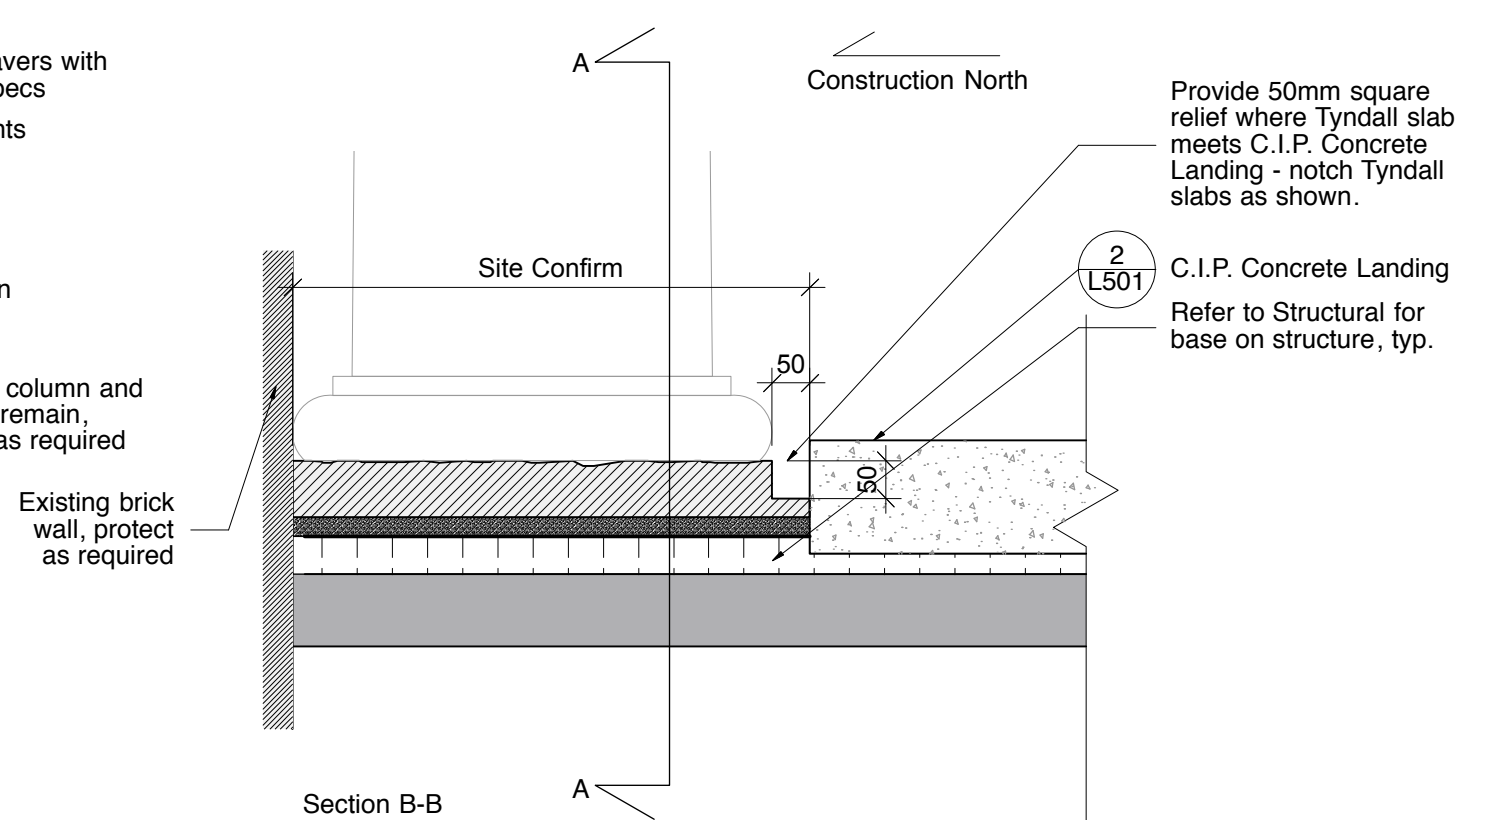


5 C.I.P. Concrete Landing
Scale: 1:10

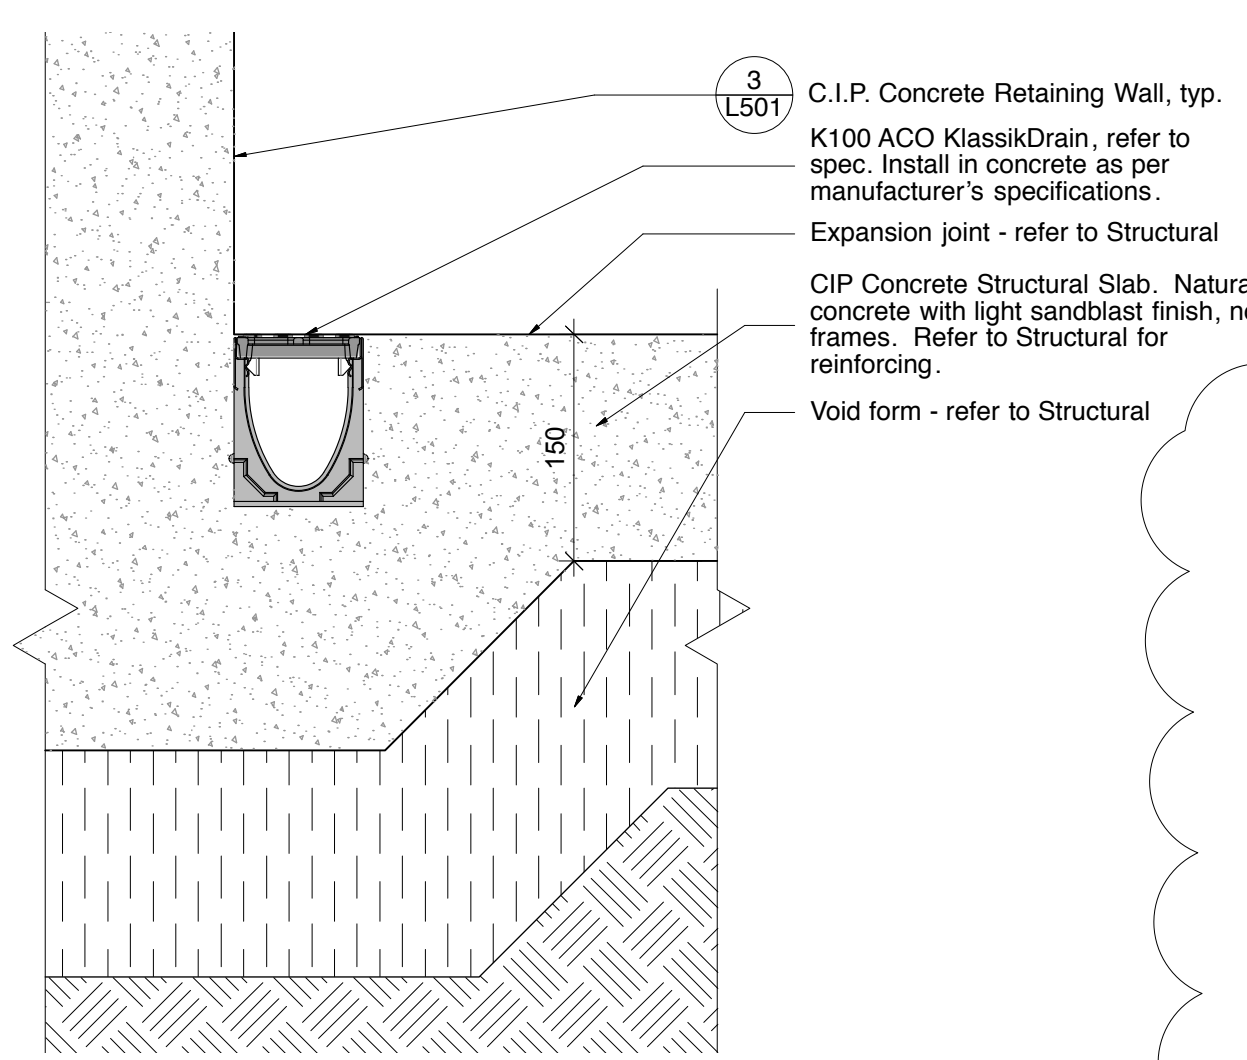


5 Trench Drain in C.I.P. Concrete
Scale: 1:5

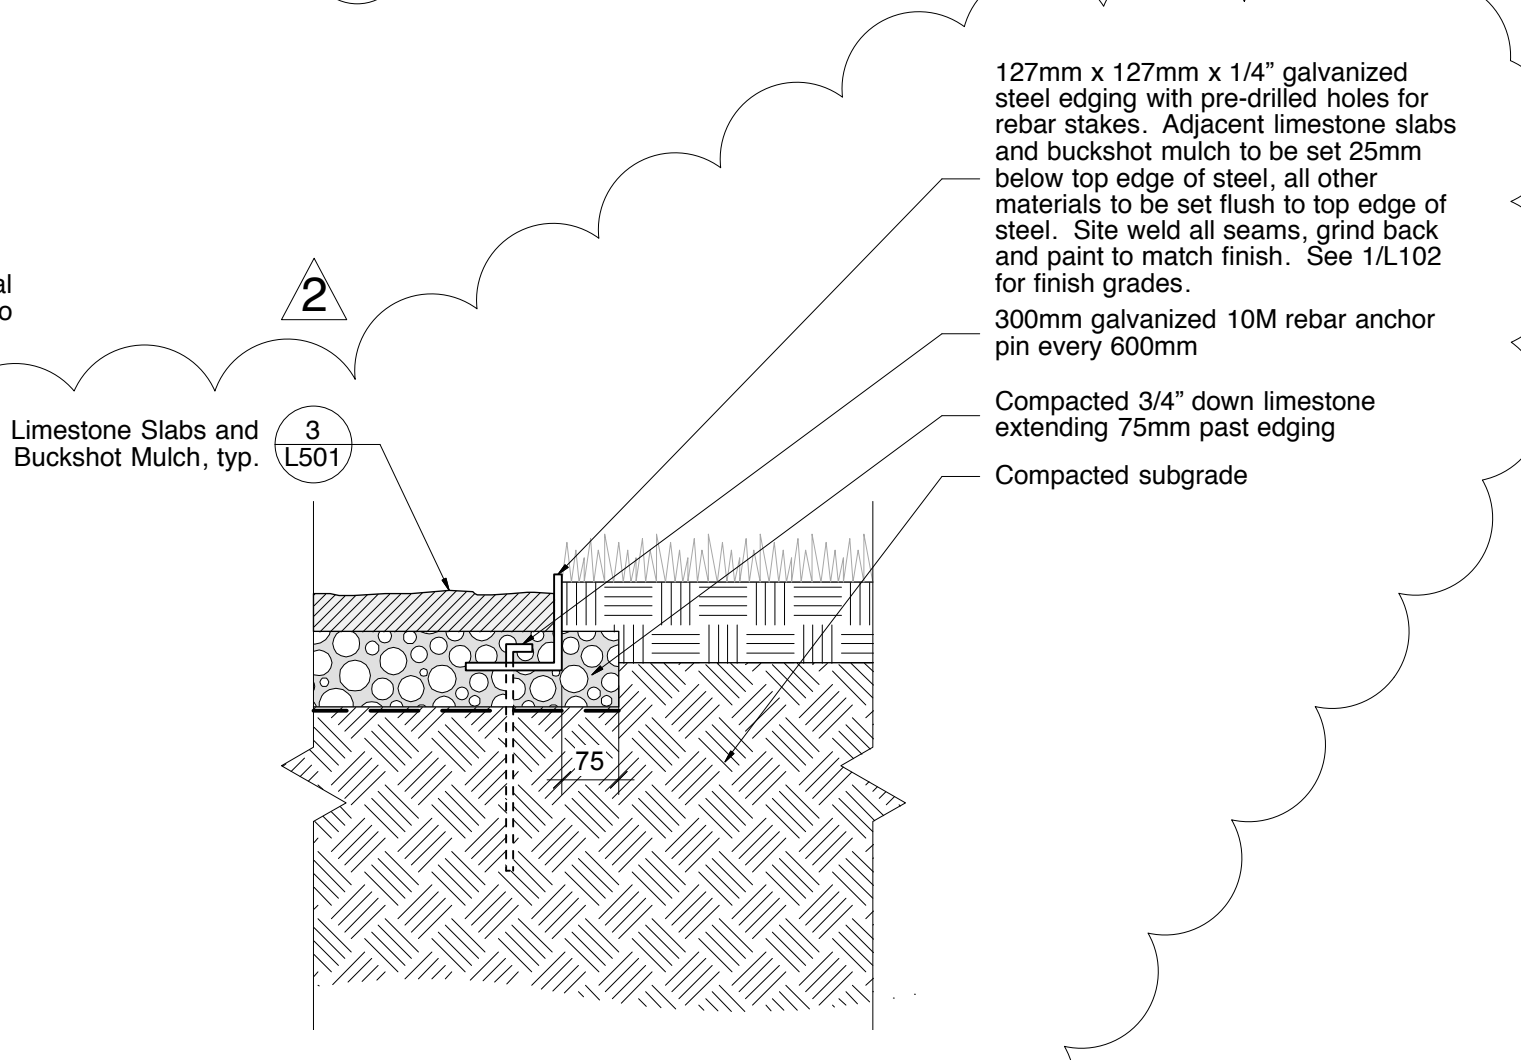


6 Steel Edge, typ.
Scale: 1:10

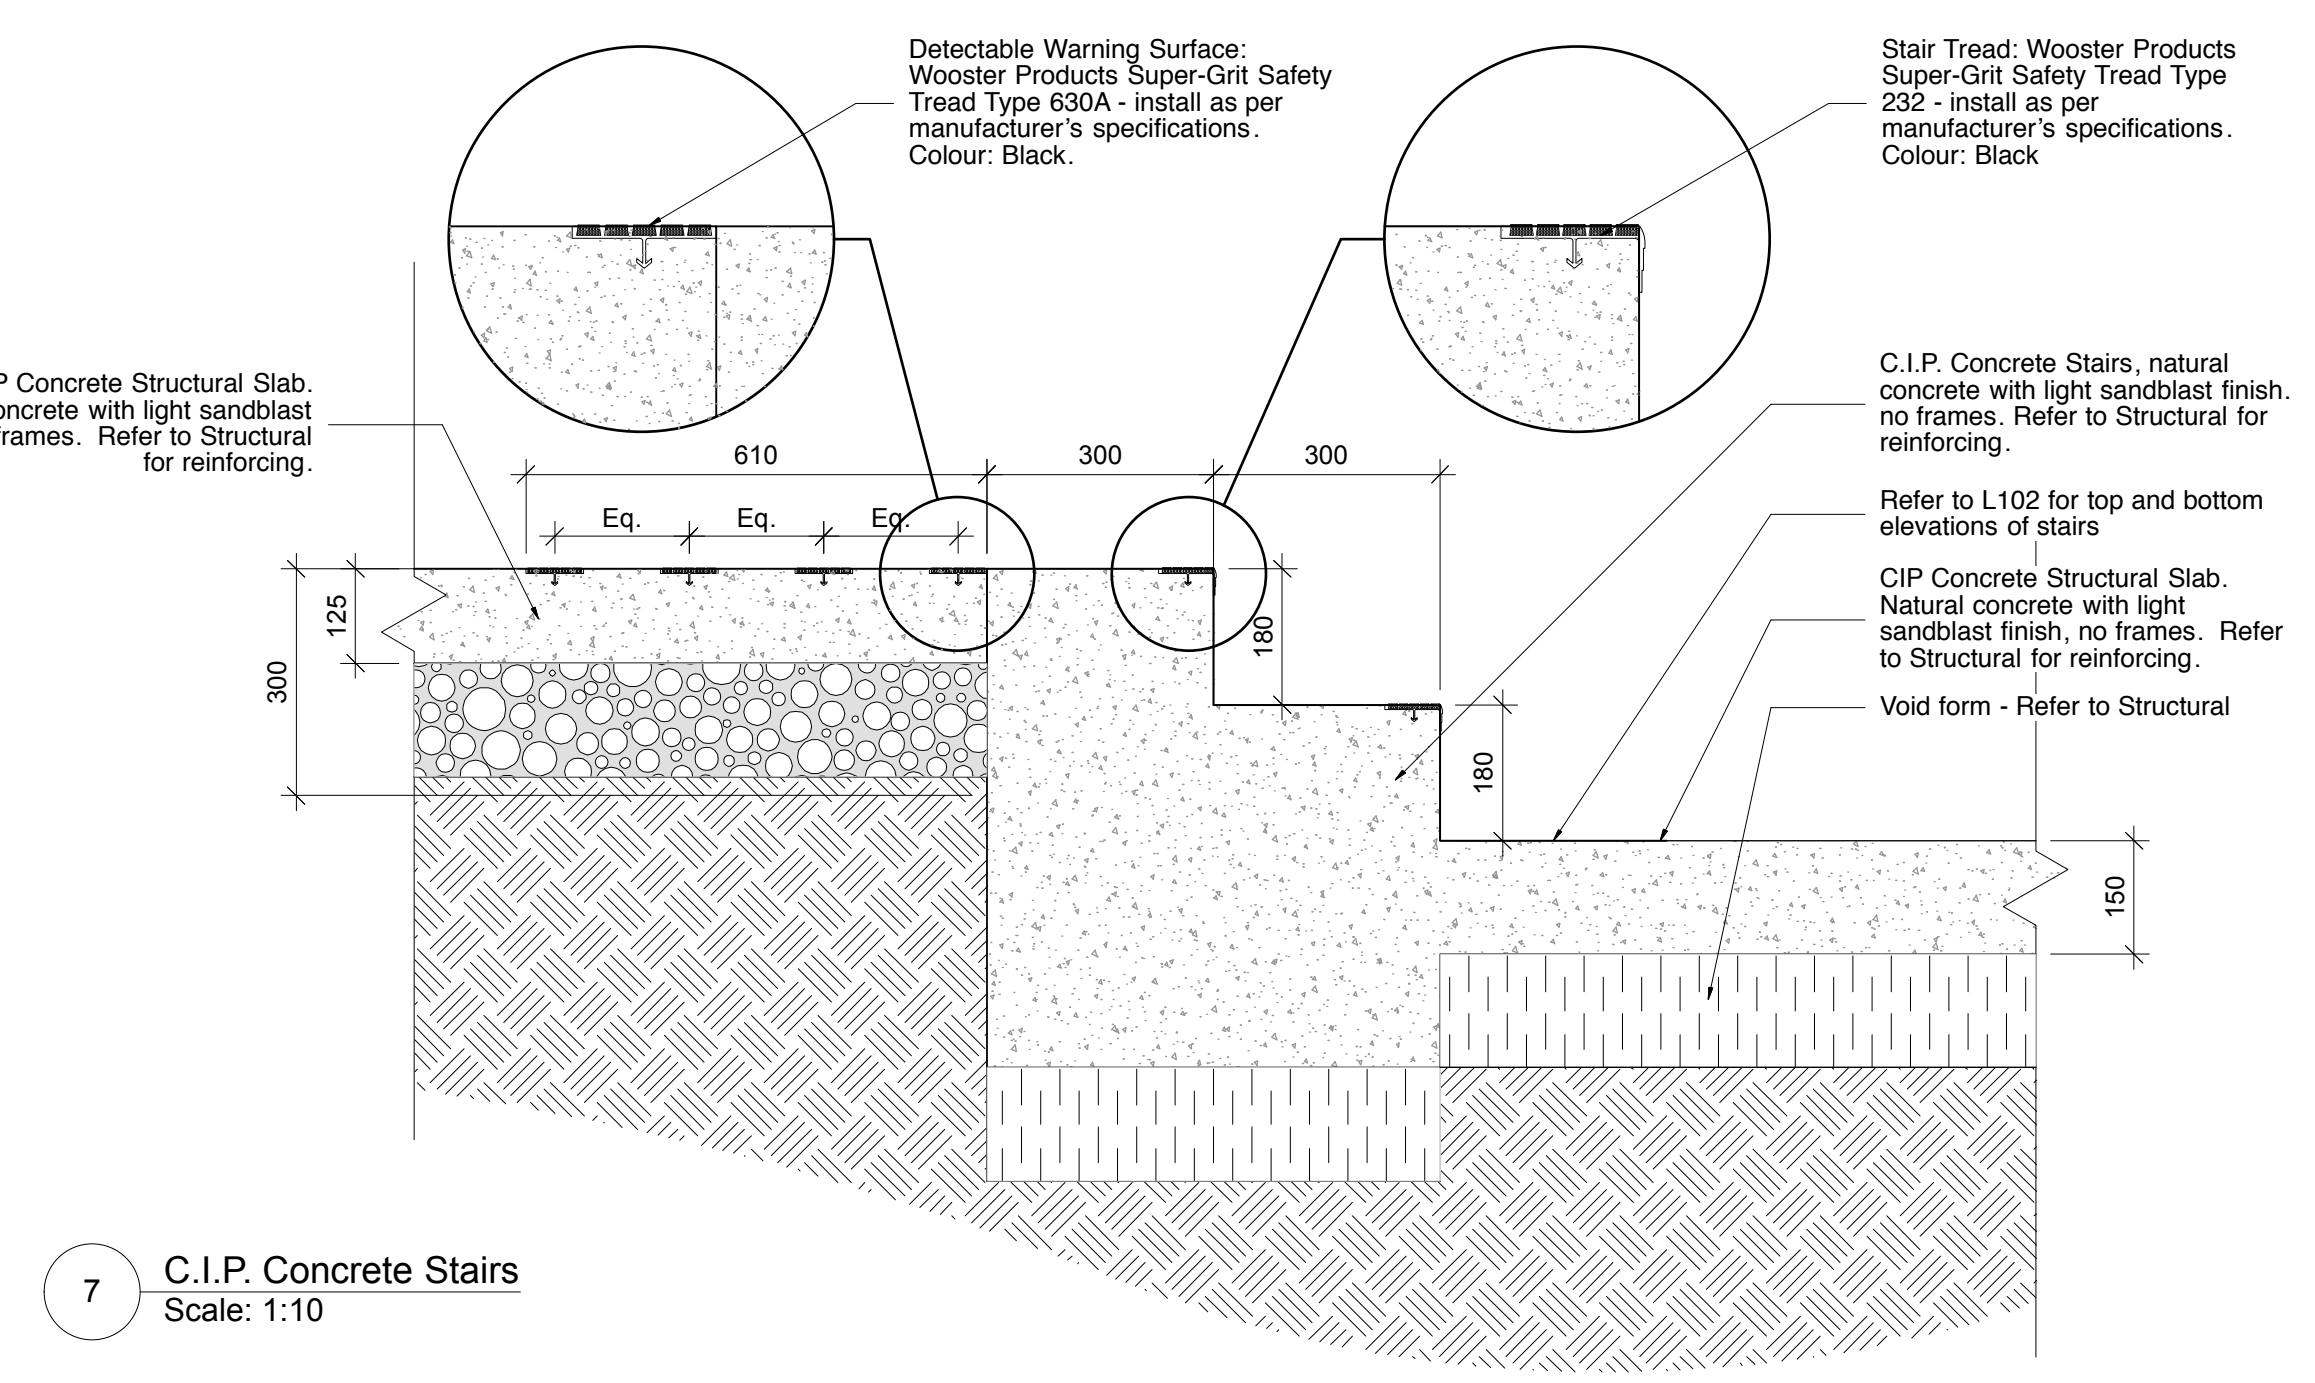

7 C.I.P. Concrete Stairs
Scale: 1:10

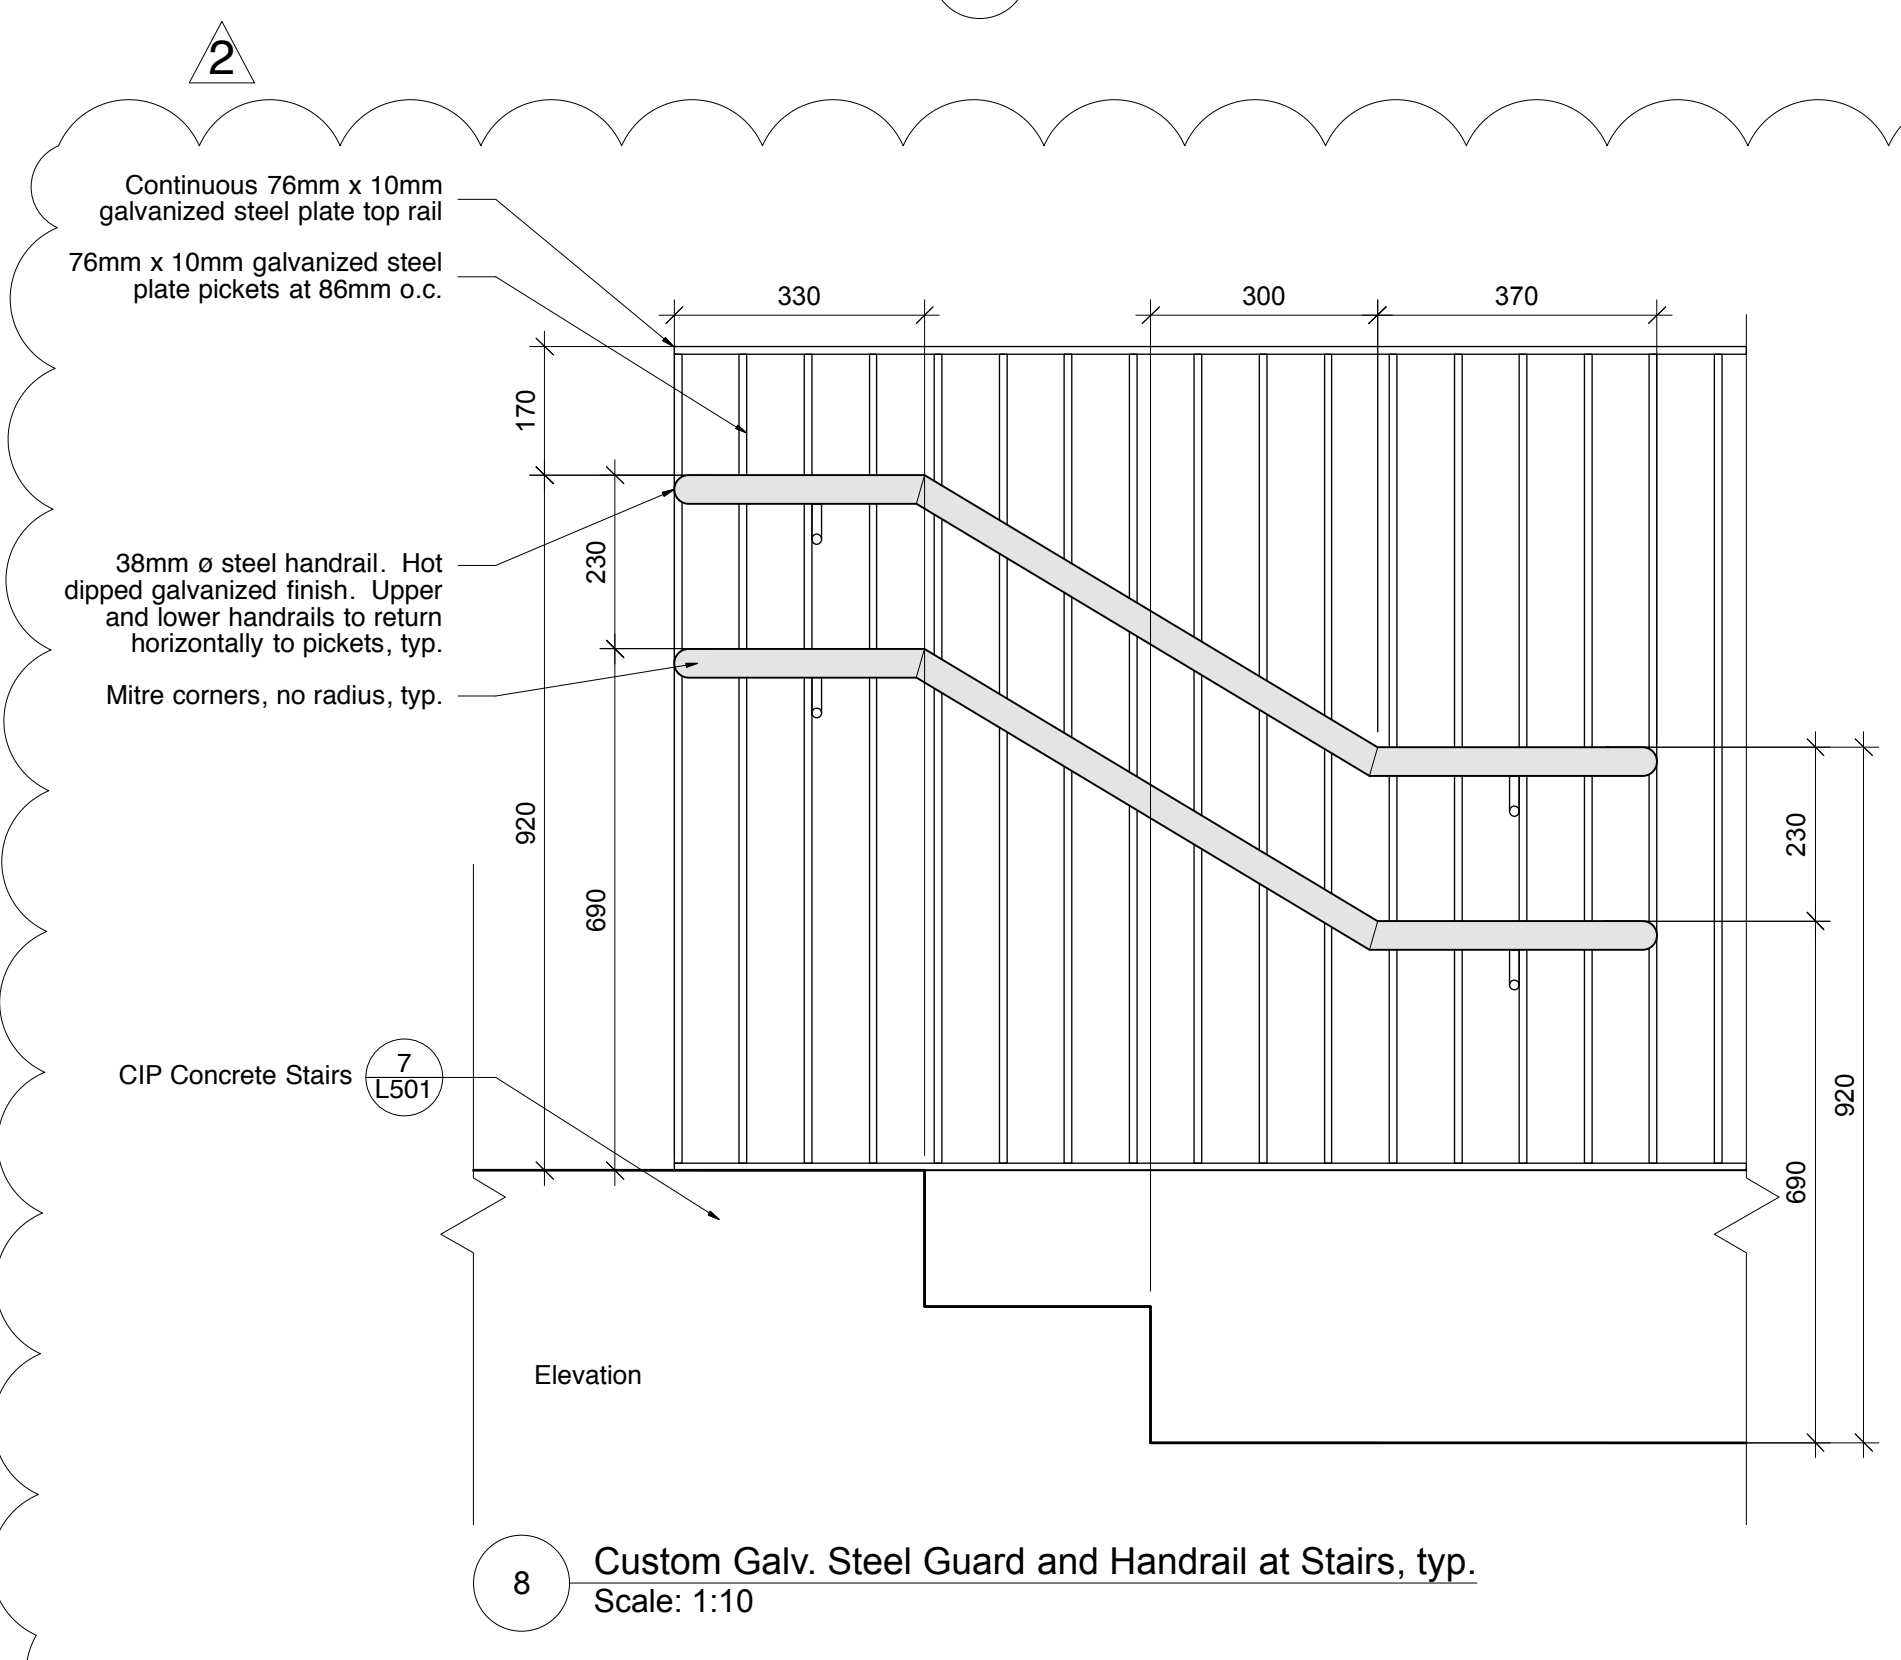

8 Custom Galv. Steel Guard and Handrail at Stairs, typ.
Scale: 1:10

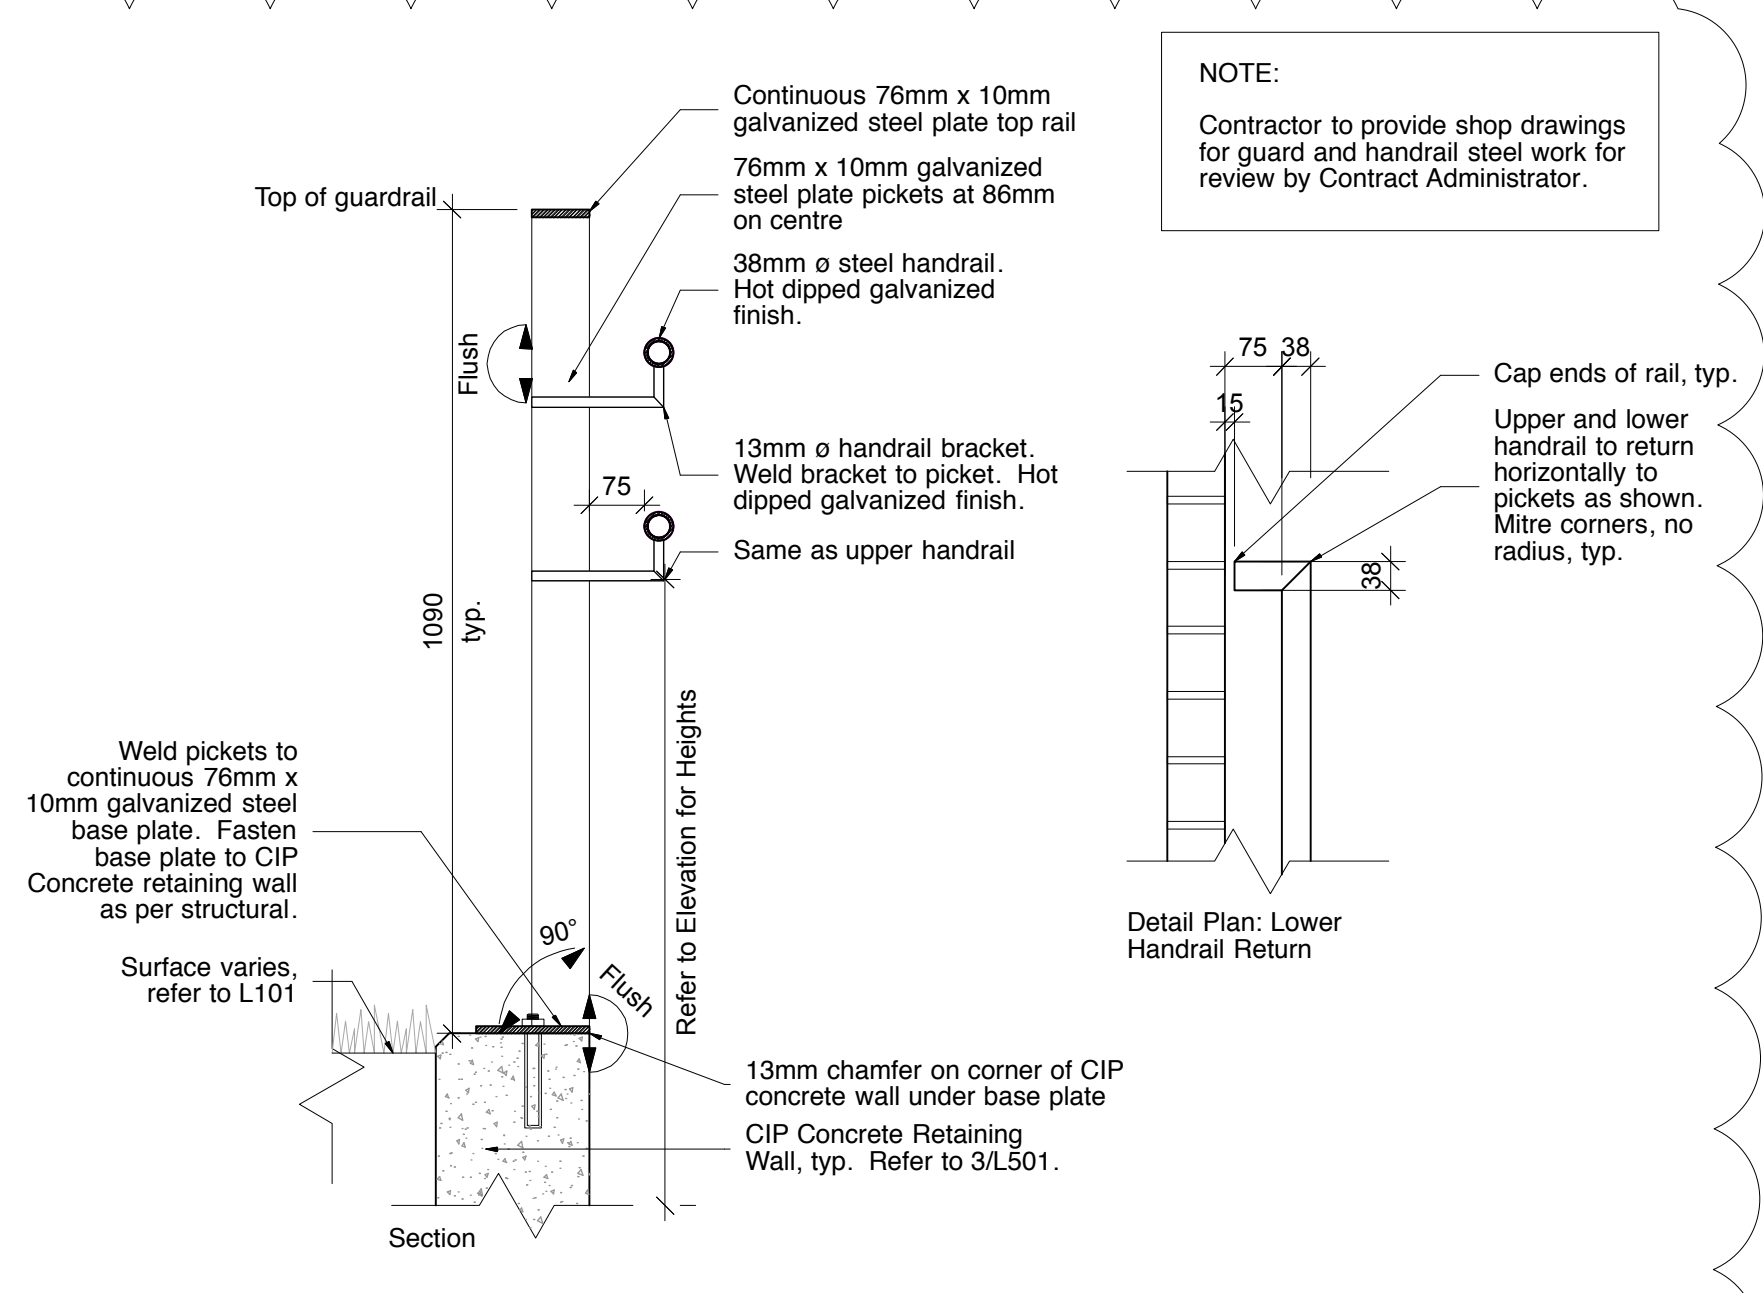

This drawing must not be scaled. The contractors shall verify all dimensions and other data on site prior to commencement of work. Discrepancies, errors, and omissions are to be reported to Public City Architecture Inc. prior to proceeding with the Work.

Drawings and specifications as instruments of service are the property of Public City Architecture Inc. and when made, must bear their name. All prints to be returned to Public City Architecture Inc. upon request.

Project
Cornish Library Renovation

Drawing
Landscape Details (1 of 2)

Drawn By
TL
Scale
As noted

Reviewed By
LW
Drawing No.
L-501

Date
2017.11.28

Project No.
1503a