


#	REVISION	DATE	BY
2	ADDENDUM 3	2018.01.30	JCR
1	ISSUED FOR CONSTRUCTION	2017.11.28	JCR

**WOLFROM** ENGINEERING LTD  
 CONSULTING ENGINEERS  
 345 WARDLAW AVENUE  
 WINNIPEG, CANADA R3L 0L5  
 (204) 452-0041 FAX: 284-8680  
 E-Mail: info@wolfromeng.com

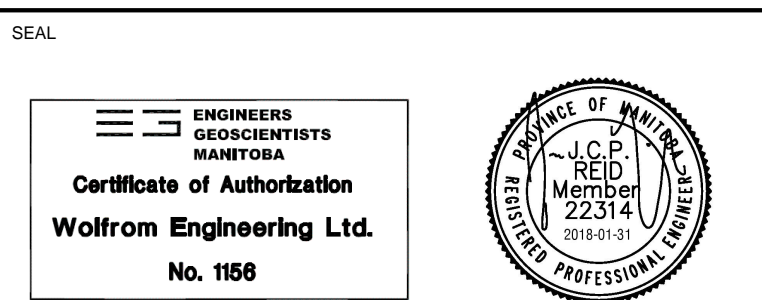

JOB TITLE  
**CORNISH LIBRARY  
 RENOVATION &  
 ADDITION**

DRAWING TITLE  
**SECTIONS & DETAILS**

DRAWN BY	SCALE	DRAWING NO.
MANF	As indicated	<b>S-4</b>
FILE NO.	DATE	REVISION NO. 2
W15151	NOV. 28, 2017	