



ELEMENTARY DIAGRAM:

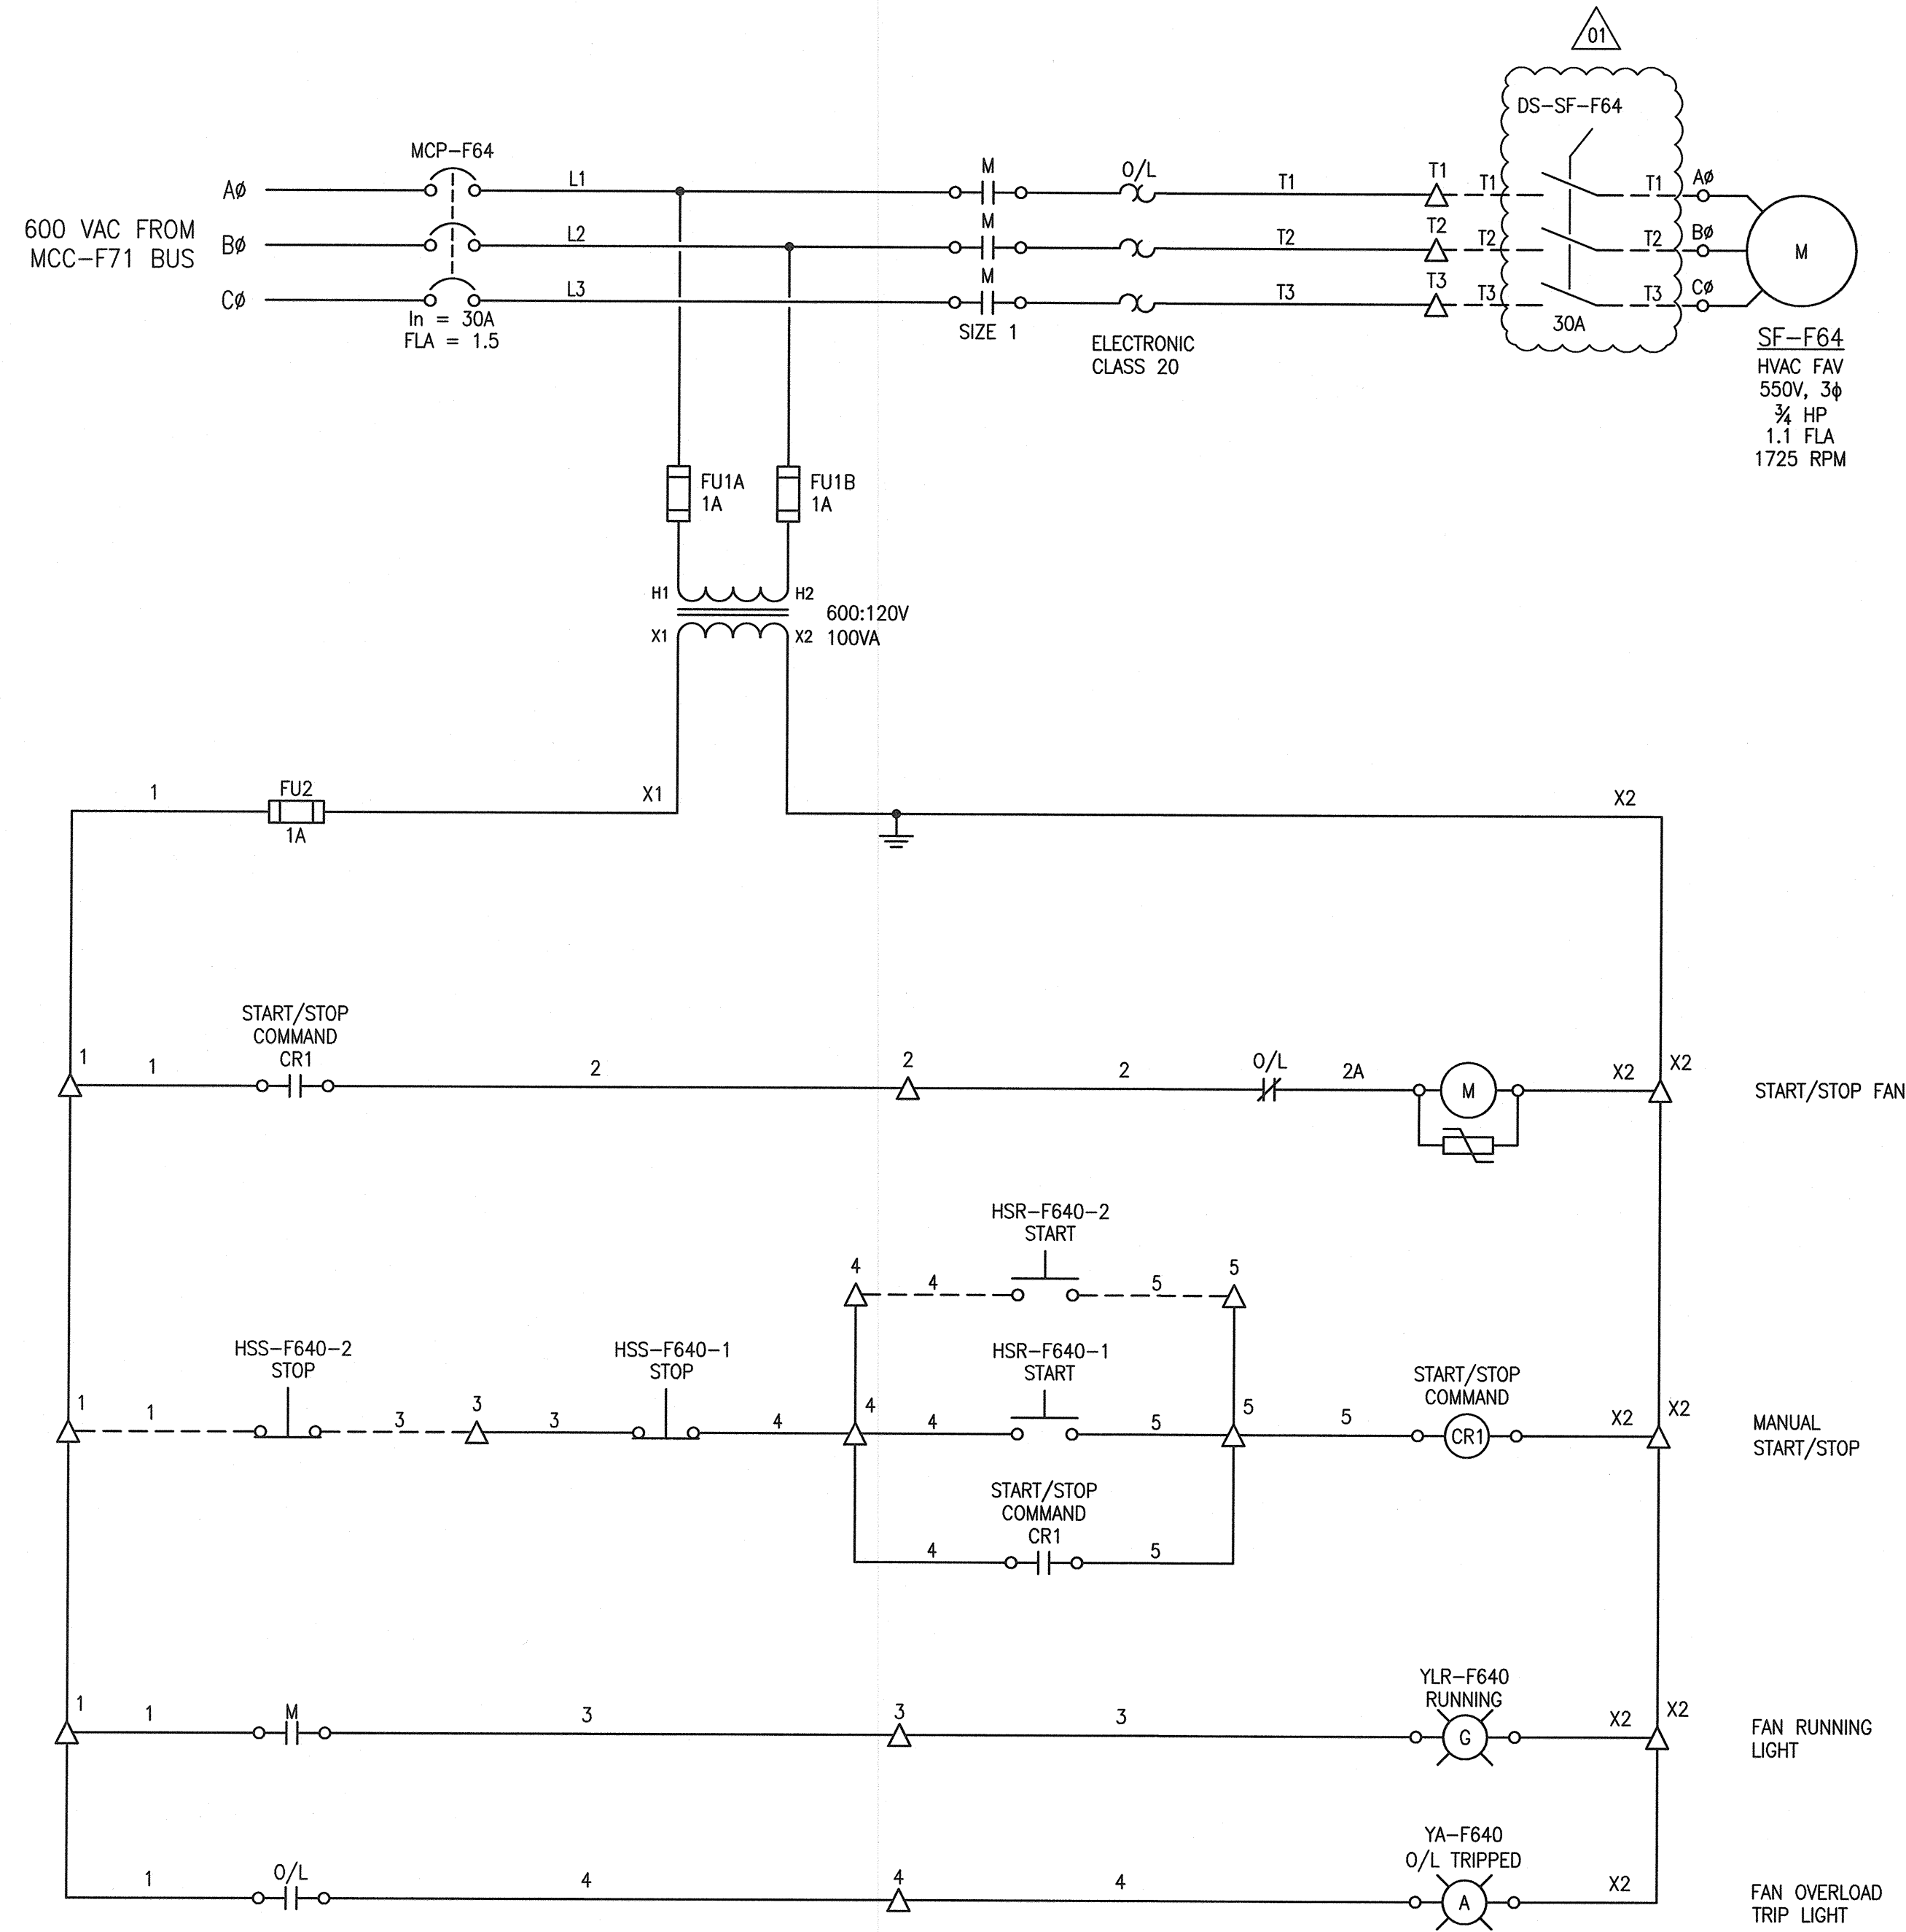

FIELD CONNECTION DIAGRAM:

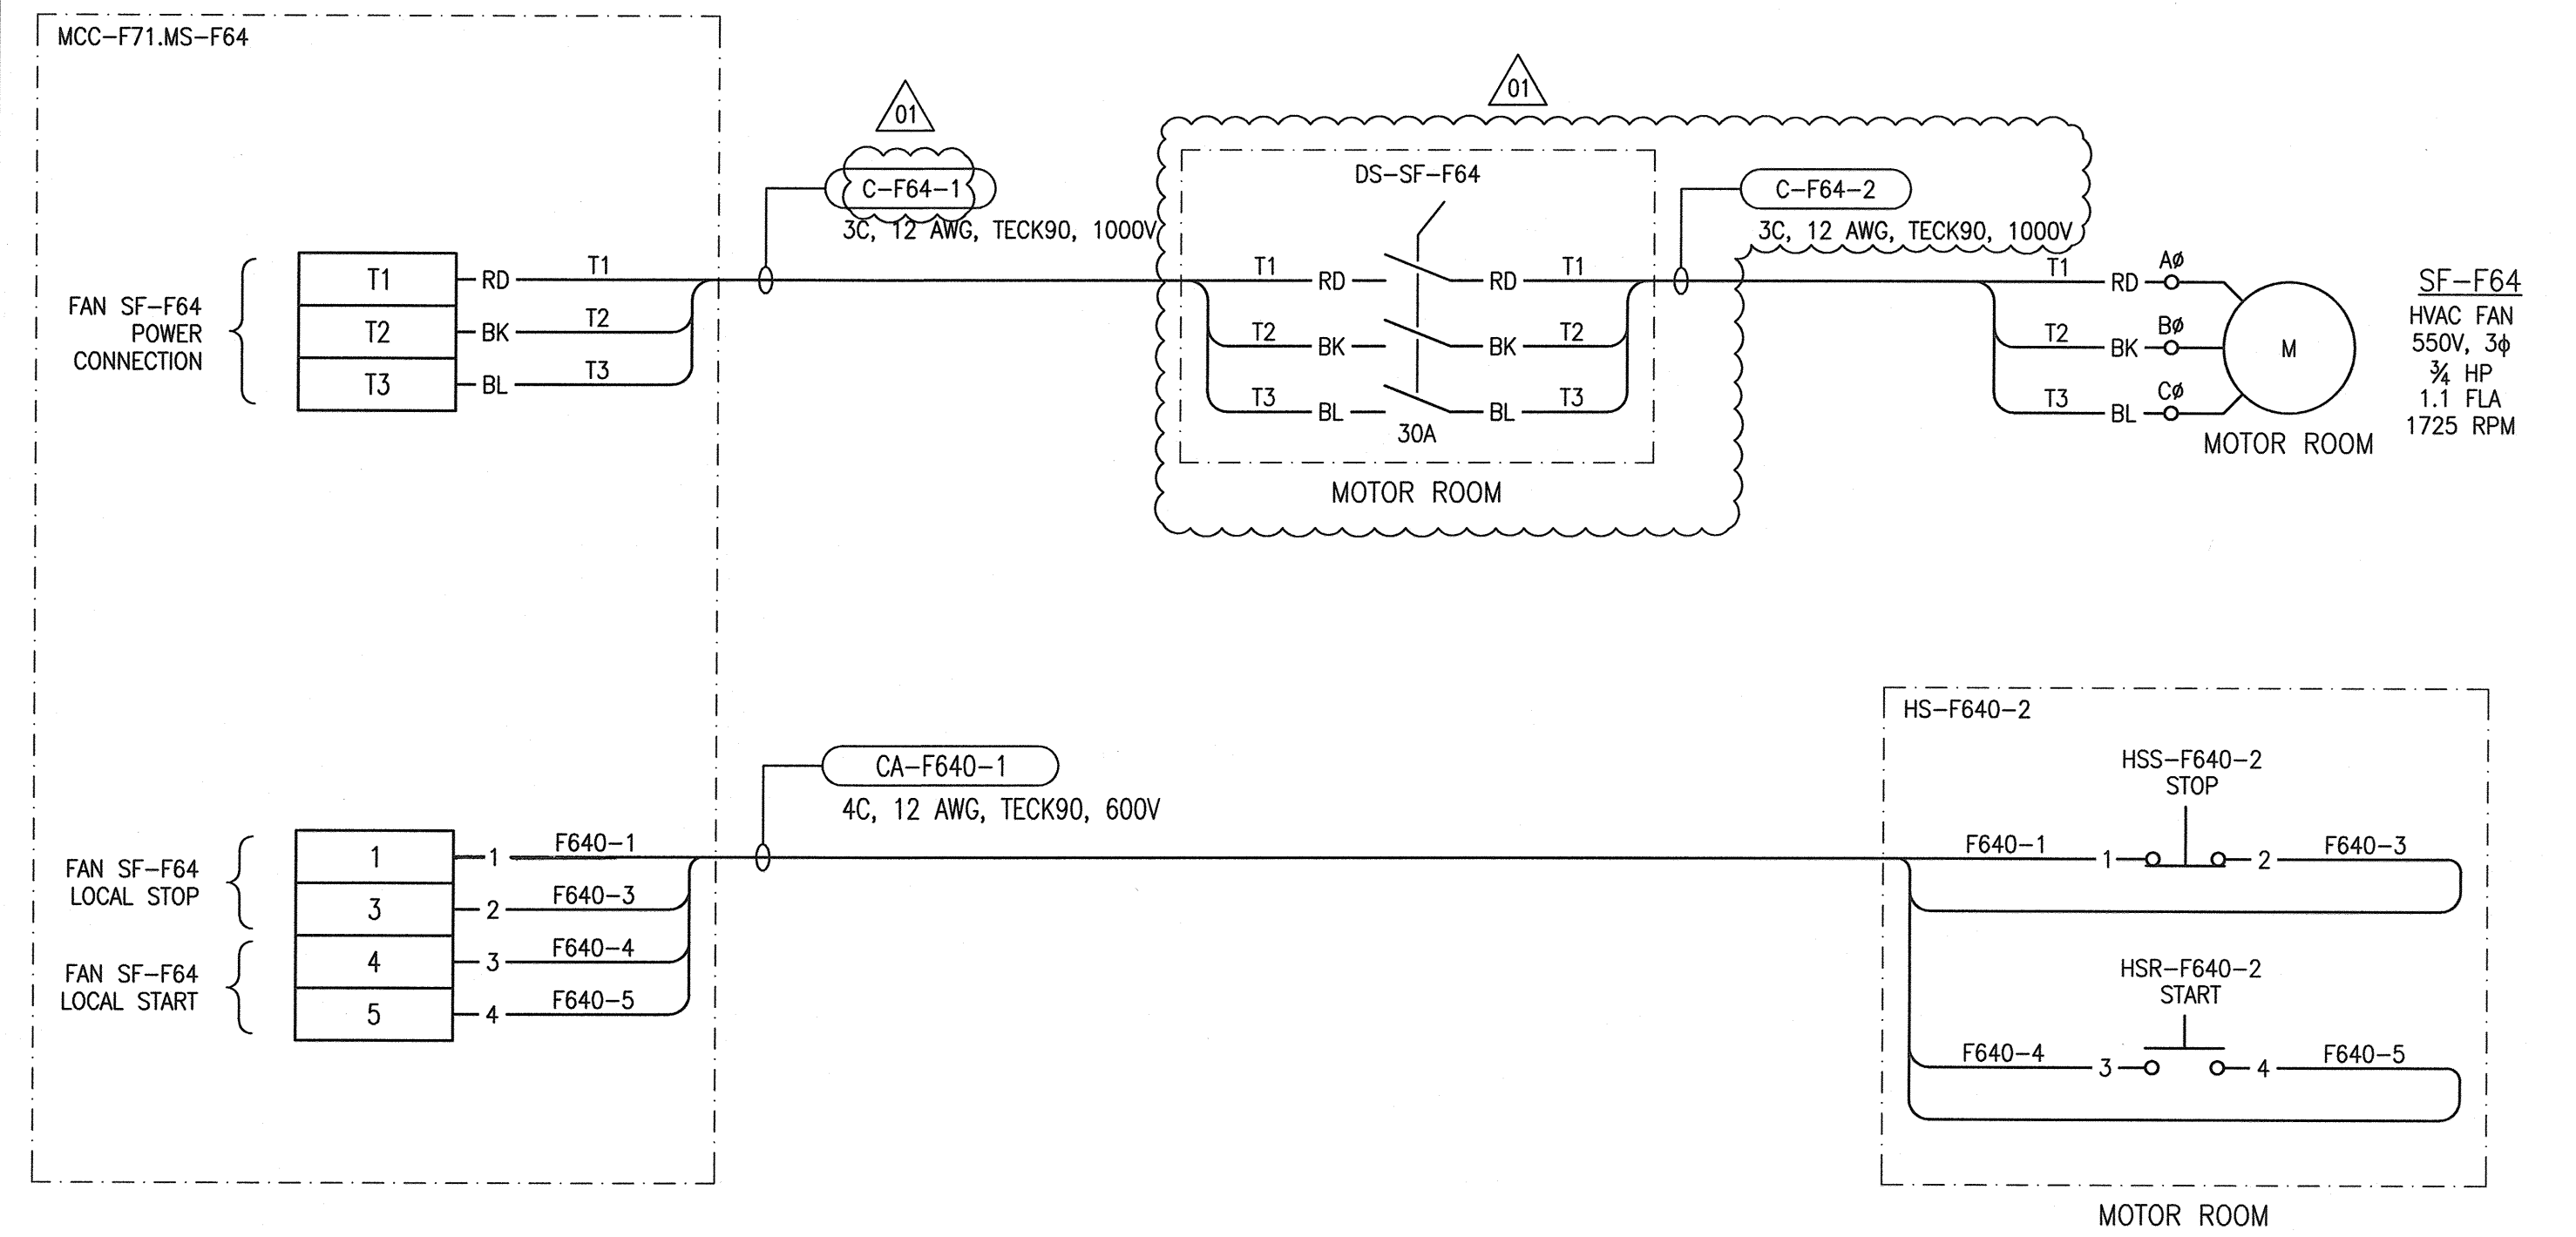

LEGEND:

- INTERNAL WIRING
- - - FIELD (EXTERNAL) WIRING
- △ SOFT STARTER ENCLOSURE TERMINAL

NO.	REVISIONS	DATE	DESIGN	CHECK
01	ADDED LOCAL SWITCHES, ISSUED FOR CONSTRUCTION	2019/01/24	KS	BC
00	ISSUED FOR TENDER AND CONSTRUCTION	2018/12/14	KS	BC

SNC-LAVALIN INC.
148 Nourse Park Way
Winnipeg, MB, Canada R3P 0X7
204-796-8080


DESIGNED BY: K. SAPIAK
CHECKED BY: B. CLEVEN

DRAWN BY: K. SAPIAK
APPROVED BY: B. CLEVEN

SCALE: NTS
ISSUED FOR CONSTRUCTION BY: K. ZUREK
DATE: 2019/01/24

DATE: 2018/08/21

CONSULTANT NO.:

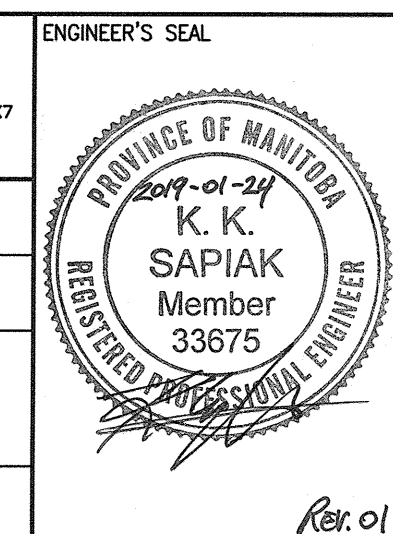

THE CITY OF WINNIPEG
WATER AND WASTE DEPARTMENT

ROLAND FLOOD PUMPING STATION
2019 UPGRADES
MOTOR STARTER SCHEMATIC
AND CONNECTION DIAGRAM
SF-F64 HVAC FAN

CITY DRAWING NUMBER: 1-0179F-E0018
SHEET: 001
REV. SIZE: 01 A1