




1 BUILDING SECTION
SCALE: 1/16"=1'-0"

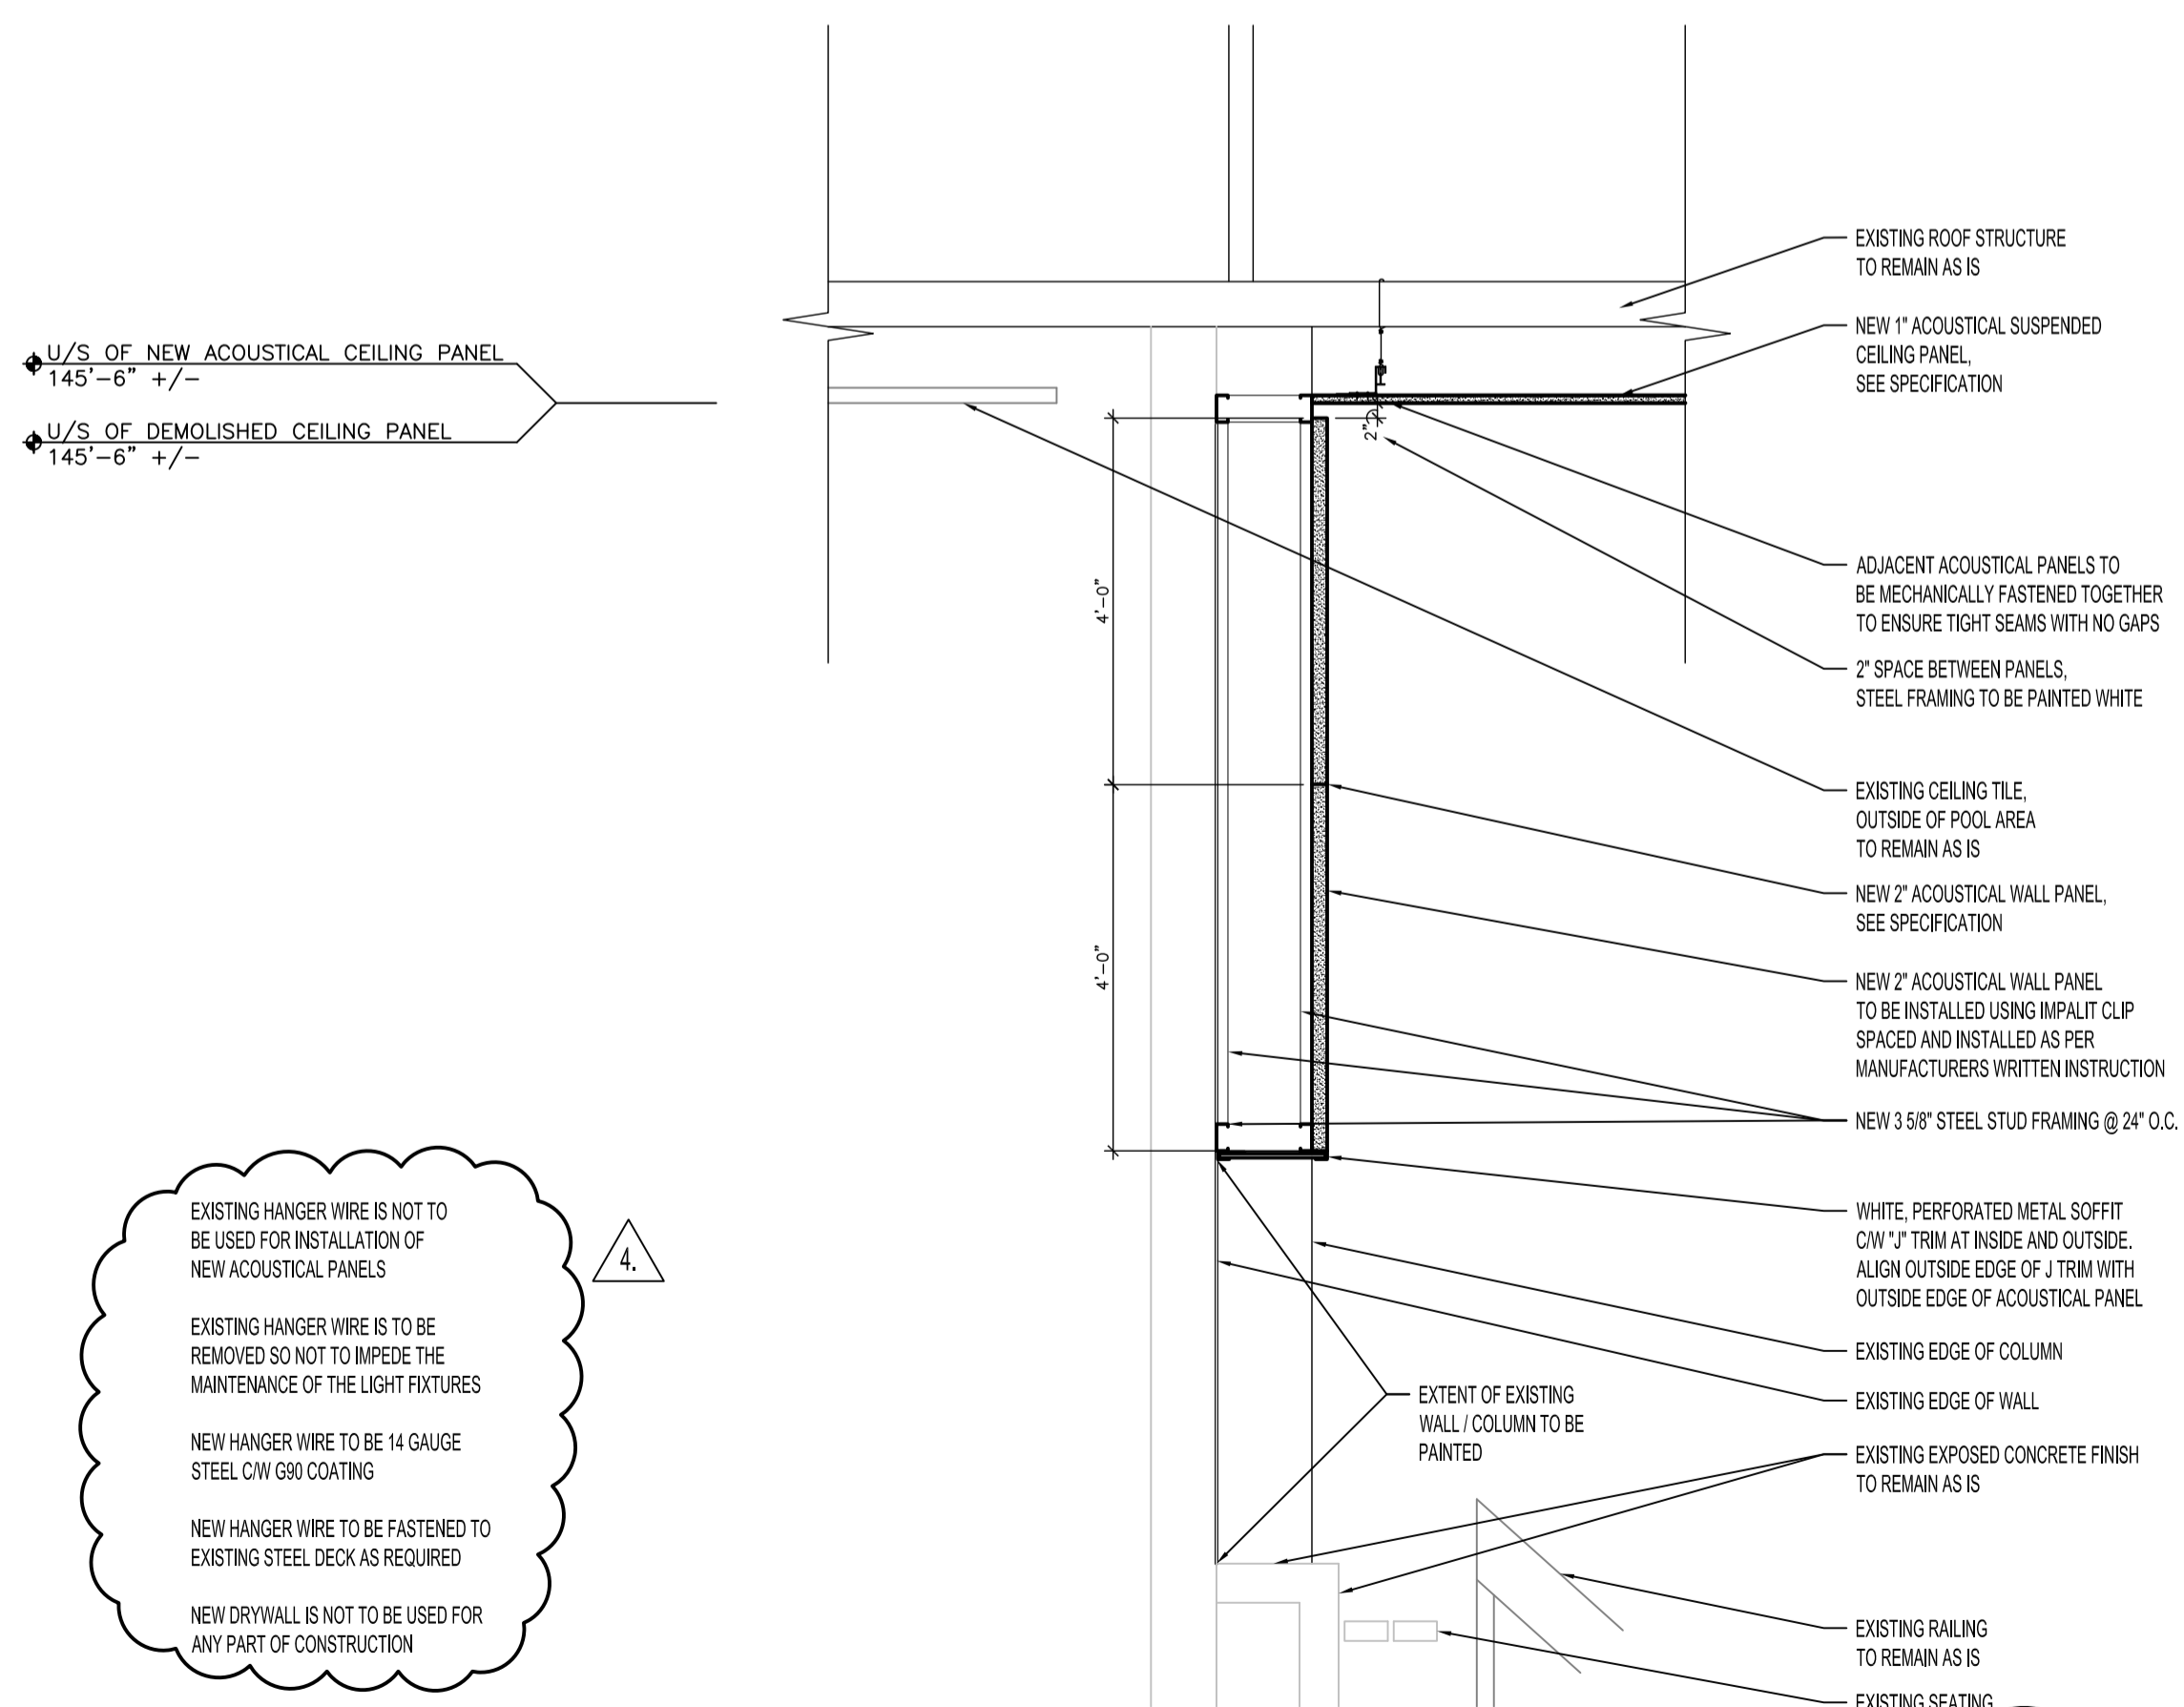

2 ACOUSTICAL WALL PANEL SECTION DETAIL
SCALE: 1/2"=1'-0"

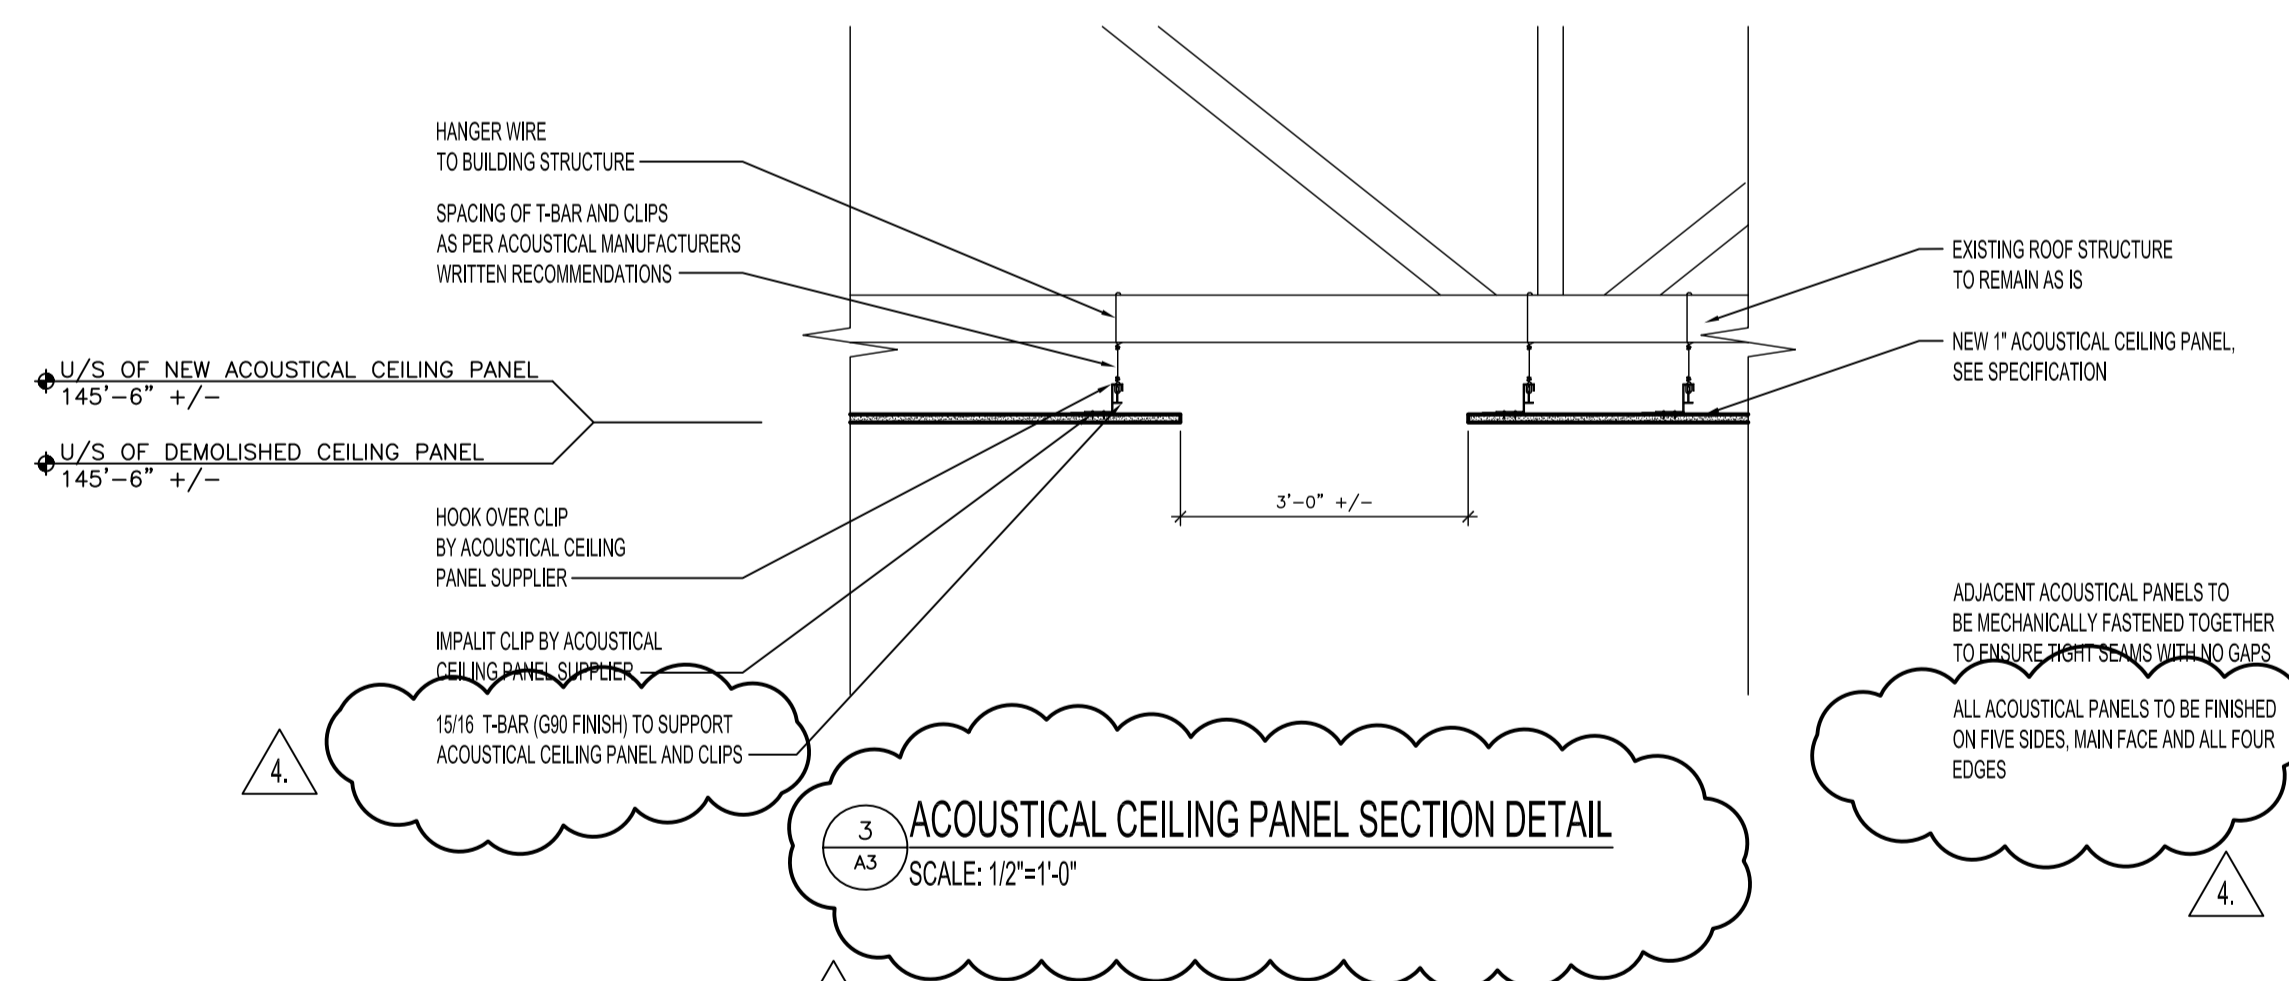

3 ACOUSTICAL CEILING PANEL SECTION DETAIL
SCALE: 1/2"=1'-0"

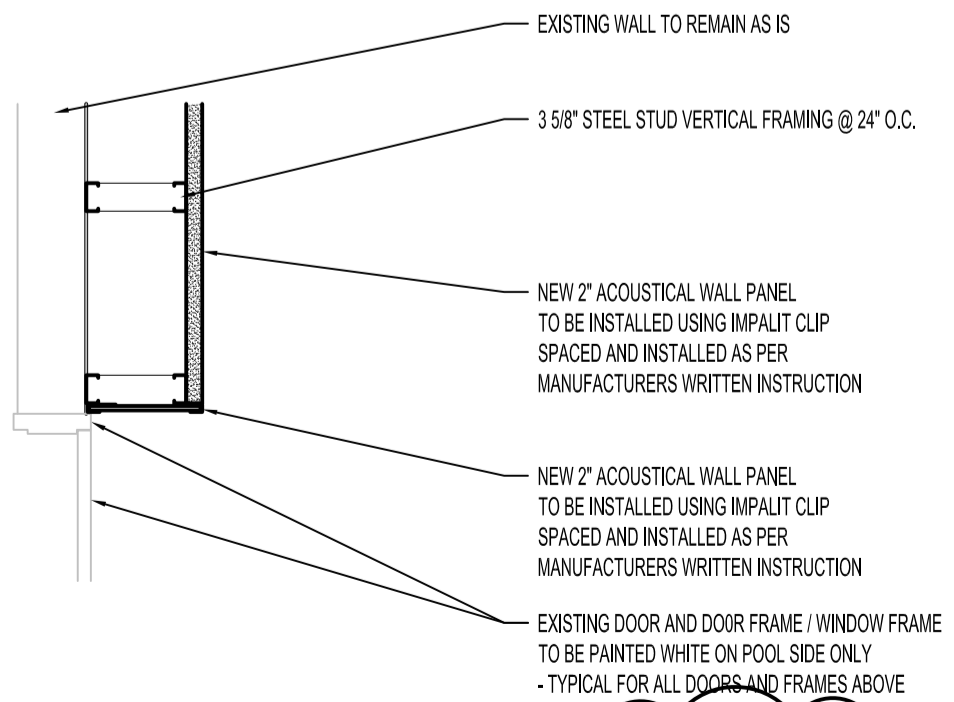


4 DOOR / WINDOW OPENING PLAN DETAIL
SCALE: 1/2"=1'-0"

EXISTING HANGER WIRE IS NOT TO BE USED FOR INSTALLATION OF NEW ACOUSTICAL PANELS
EXISTING HANGER WIRE IS TO BE REMOVED SO NOT TO IMPEDE THE MAINTENANCE OF THE LIGHT FIXTURES
NEW HANGER WIRE TO BE 14 GAUGE STEEL CW G90 COATING
NEW HANGER WIRE TO BE FASTENED TO EXISTING STEEL DECK AS REQUIRED
NEW DRYWALL IS NOT TO BE USED FOR ANY PART OF CONSTRUCTION

ALL ACOUSTICAL PANELS TO BE FINISHED ON FIVE SIDES, MAIN FACE AND ALL FOUR EDGES

ALL ACOUSTICAL PANELS TO BE FINISHED ON FIVE SIDES, MAIN FACE AND ALL FOUR EDGES

NOTES:
THESE DRAWINGS SHALL NOT BE SCALED.
THE CONTRACTOR SHALL VISIT THE SITE AND SATISFY ONESELF ALL DIMENSIONS, DATUM, AND DETAILED INFORMATION SHOWN ARE CORRECT.
THE CONTRACTOR IS TO REVIEW AND COORDINATE ALL ARCHITECTURAL, MECHANICAL, ELECTRICAL AND STRUCTURAL DRAWINGS FOR ADDITIONAL OPENINGS THROUGH FLOORS, WALLS, AND CEILINGS FOR DUCT, PIPE & ELECTRICAL RISERS AND ALL OPENINGS NOT SHOWN ON DRAWINGS.
ALL OPENINGS THROUGH FIRE ASSEMBLIES ARE TO BE FIRE STOPPED AND SEALED WITH ULC APPROVED FIRE STOPPING TO MAINTAIN THE INTEGRITY OF THE FIRE SEPARATION, AND PROVIDE A SMOKE-TIGHT BARRIER.
ALL PRODUCTS AND MATERIALS TO BE USED AND INSTALLED SHALL CONFORM WITH MANUFACTURER'S SPECIFICATIONS & APPLICABLE CODES.
THE CONTRACTOR SHALL BE RESPONSIBLE TO PATCH AND MAKE GOOD ALL EXISTING CONSTRUCTION AFFECTED BY THE REMOVAL OF ALL ITEMS FORMING THE PART OF THE RENOVATION WORK.
WHERE PAINTING OF EXISTING WALLS IS INDICATED, THESE WALLS MUST BE CLEANED OF ANY EXISTING WALL COVERING, PATCHED & PREPARED TO ACCEPT NEW MATERIAL, UNLESS OTHERWISE NOTED.

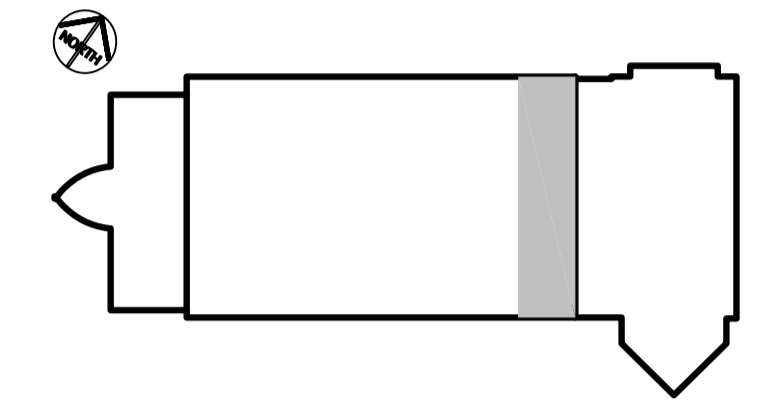

KEY PLAN
SCALE: N.T.S.

No.	REVISION/DESCRIPTION	BY	DATE
4	ISSUED FOR ADDENDUM # 2	DR/KM	18.06.26
3	ISSUED FOR TENDER / CONSTRUCTION	DR/KM	18.06.13
2	ISSUED FOR 99% REVIEW	DR/KM	18.05.31
1	ISSUED FOR 66% REVIEW	DR/KM	18.05.01

DR / KM	CHECKED	MG	DESIGNED	DR / JP	APPROVED	JP
DATE 2018.03.23	USER APPROVAL					

THE CITY OF WINNIPEG
PLANNING, PROPERTY AND DEVELOPMENT DEPARTMENT
MUNICIPAL ACCOMMODATIONS DIVISION
3-65 GARRY STREET, R3C 4K4

PROJECT
PAN AM POOL
CEILING RENOVATION
BID OPPORTUNITY No. 178-2018
25 POSEIDON BAY, WINNIPEG, MB

SHEET TITLE
BUILDING SECTION
SECTION DETAILS

SCALE AS SHOWN PROJECT No: 2017-033 SHEET No: A3