


B SIZE - 279mm x 432mm

LAST SAVE: 2018/05/09 - 10:39am  
 PATH: M:\648185\4ENG\48IC\DD - General DWG\1-0309U-A0011-001-00.dwg

MCC-U72E

CONTROL PANEL CP-U81

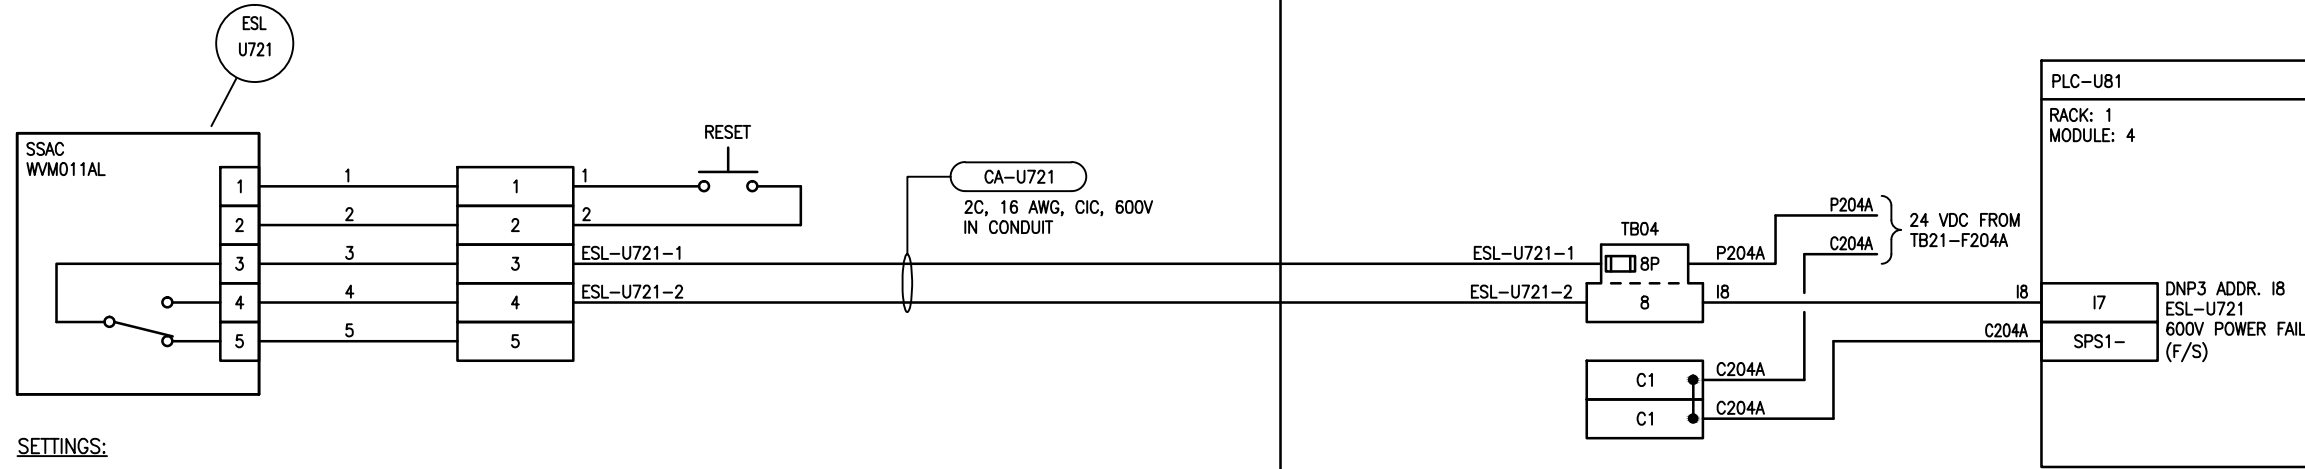

**SETTINGS:**  
 UNBALANCE = 10%  
 LINE VOLTAGE = 600  
 TRIP DELAY = 0.25 sec  
 RESTART DELAY = 0.25 sec  
 SELECTOR = MANUAL RESET



**SNC-LAVALIN INC.**  
 148 Nature Park Way  
 Winnipeg, MB, Canada R3P 0X7  
 204-786-8080

ENGINEER'S SEAL

**PRELIMINARY  
 NOT TO BE  
 USED FOR  
 CONSTRUCTION**



**THE CITY OF WINNIPEG**  
 WATER AND WASTE DEPARTMENT

METRO ROUTE 20 UNDERPASS PUMPING STATION  
 2018 UPGRADES  
 LOOP DIAGRAM  
 600V POWER FAIL  
 ESL-U721



NO.	REVISIONS	DATE	DESIGN	CHECK
00	ISSUED FOR TENDER, BID OPP. 475-2018	2018/05/09	TC	BC

DESIGNED BY: T. CHURCH	CHECKED BY: B. CLEVEN
DRAWN BY: Y. KONIG	APPROVED BY: B. CLEVEN
SCALE: NTS	DATE: 2018/04/10
ISSUED FOR CONSTRUCTION DATE:	
CONSULTANT NO.:	

CITY DRAWING NUMBER 1-0309U-A0011	SHEET 001	REV. 00	SIZE B
--------------------------------------	--------------	------------	-----------