


B SIZE - 279mm x 432mm

LAST SAVE: 2018/05/09 - 10:40am
 PATH: M:\648185\4ENG\48IC\DD - General DWG\1-0309U-A0015-001-00.dwg

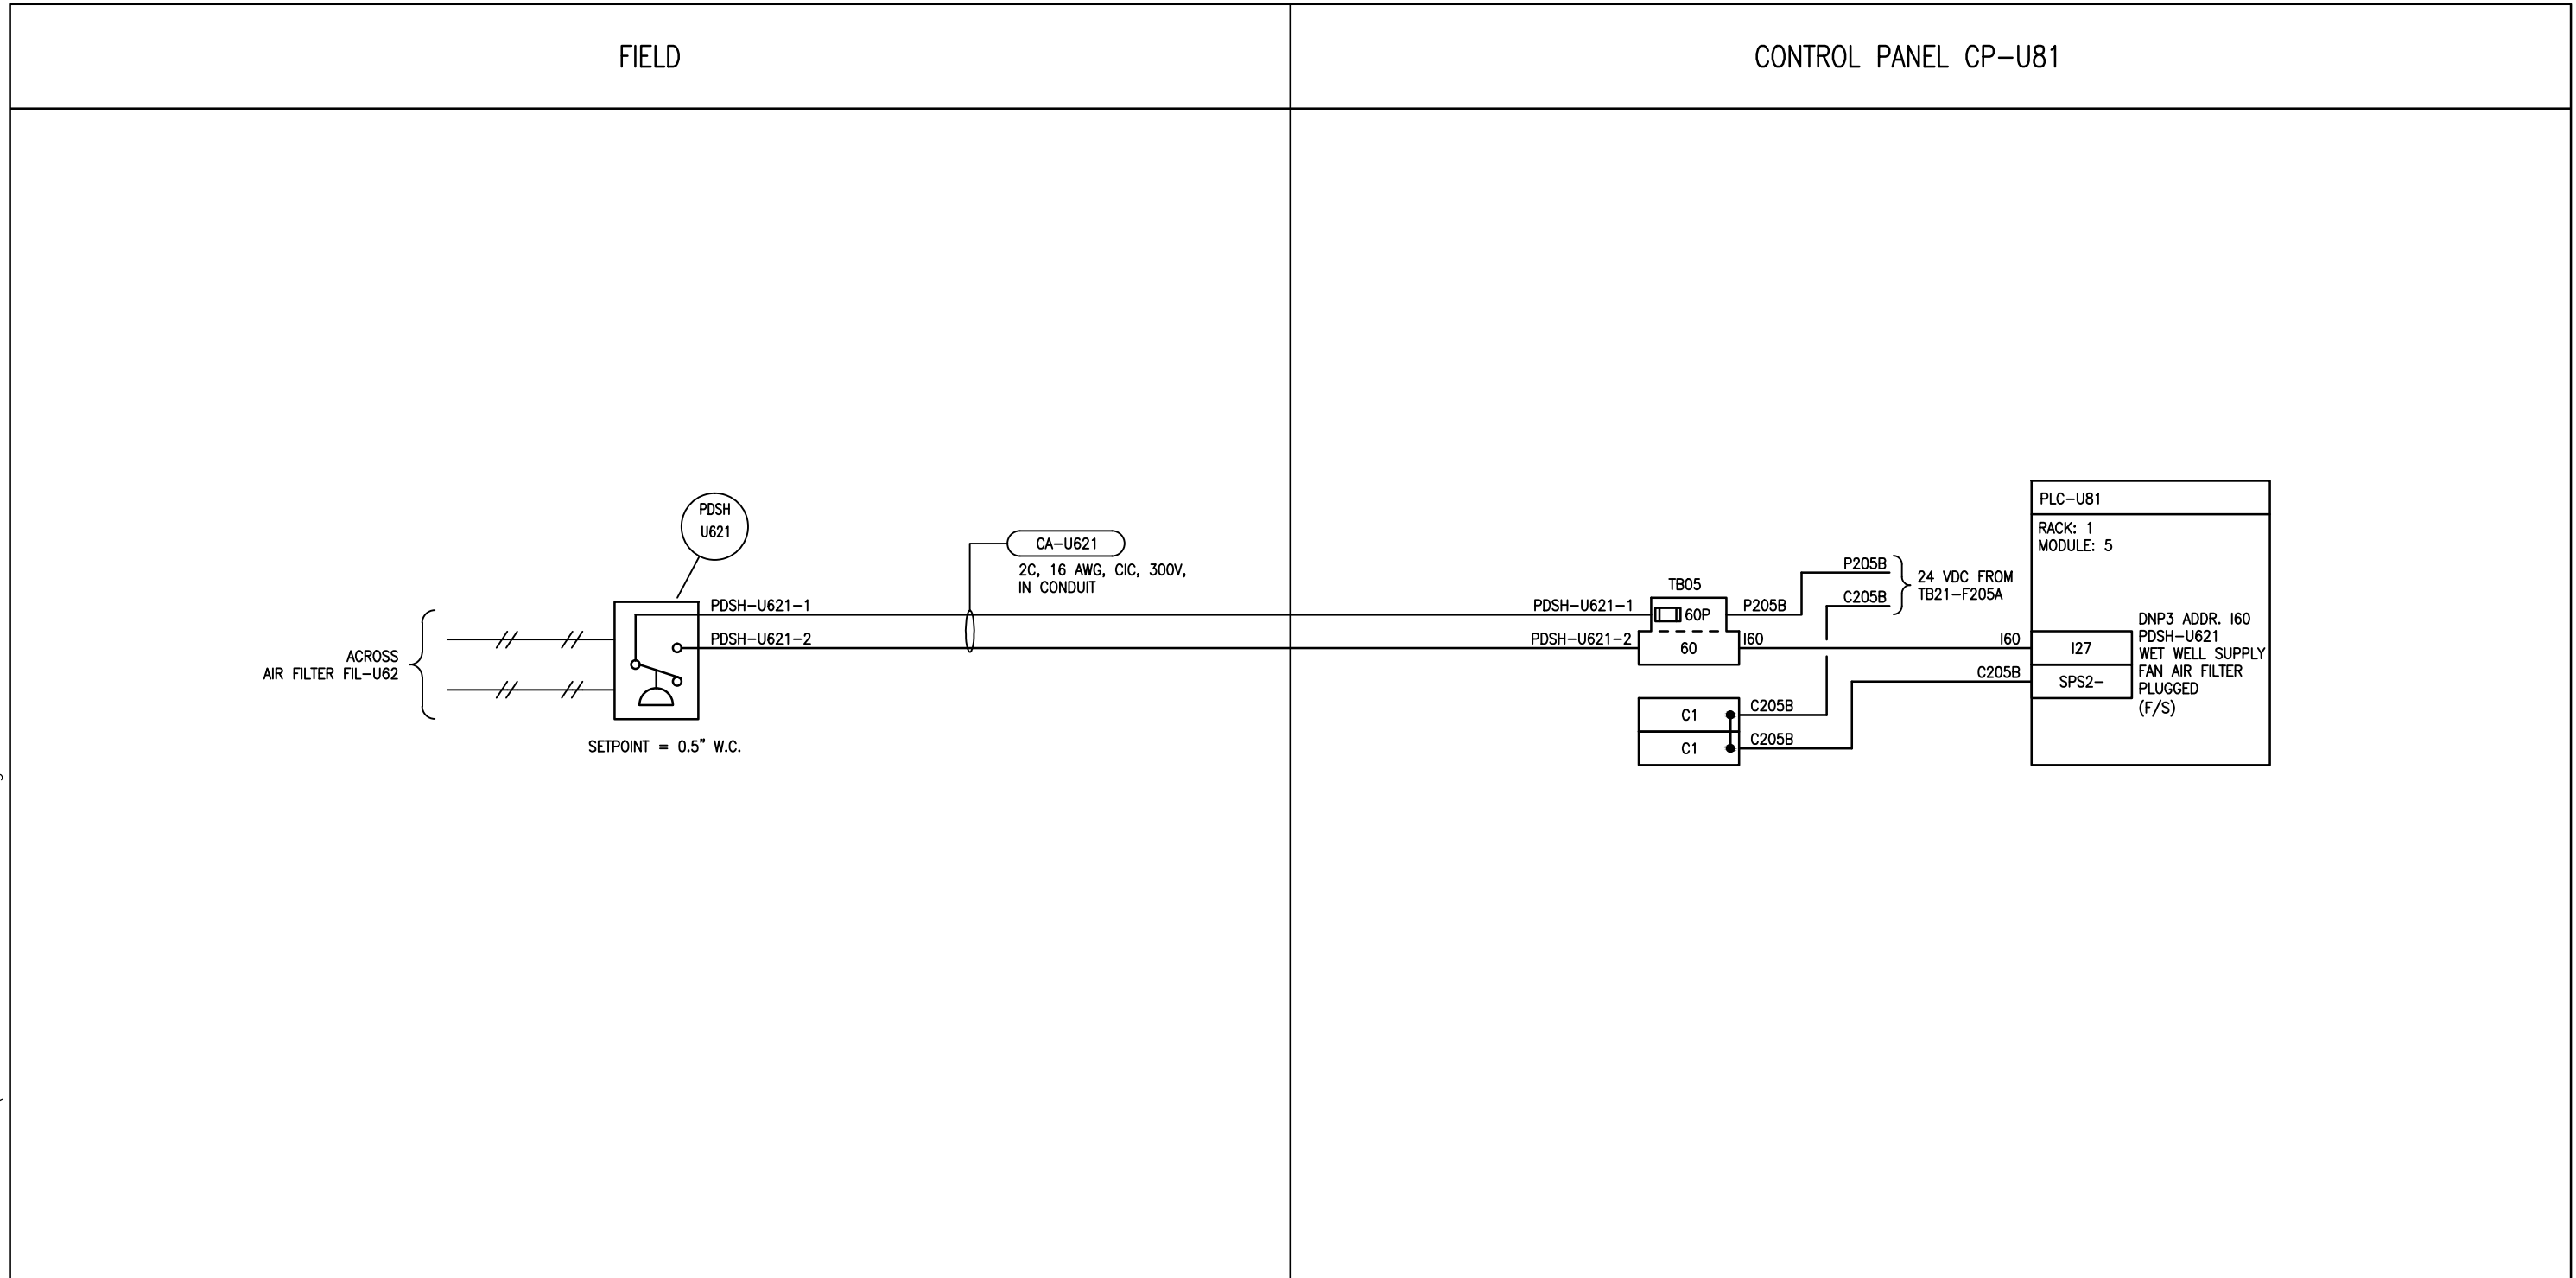

SNC-LAVALIN
 SNC-LAVALIN INC.
 148 Nature Park Way
 Winnipeg, MB, Canada R3P 0X7
 204-786-8080

ENGINEER'S SEAL
**PRELIMINARY
 NOT TO BE
 USED FOR
 CONSTRUCTION**

THE CITY OF WINNIPEG
 WATER AND WASTE DEPARTMENT

METRO ROUTE 20 UNDERPASS PUMPING STATION
 2018 UPGRADES
 LOOP DIAGRAM
 WET WELL SUPPLY FAN AIR FILTER PLUGGED SWITCH
 PDSH-U621

NO.	REVISIONS	DATE	DESIGN	CHECK
00	ISSUED FOR TENDER, BID OPP. 475-2018	2018/05/09	TC	BC

DESIGNED BY: T. CHURCH
 CHECKED BY: B. CLEVEN
 DRAWN BY: Y. KONIG
 APPROVED BY: B. CLEVEN
 SCALE: NTS
 DATE: 2018/04/10
 ISSUED FOR CONSTRUCTION
 BY: DATE:
 CONSULTANT NO.:

CITY DRAWING NUMBER	SHEET	REV.	SIZE
1-0309U-A0015	001	00	B