


LAST SAVE: 2018/05/09 - 10:43am
 PATH: M:\648185\4ENG\48IC\DD - General DWG\1-0309U-A0023-001-00.dwg
 B SIZE - 279mm x 432mm



NOTES

- DUCT HEATER HCE-U61 IS EQUIPPED WITH AN INTEGRAL AIR PROVING SWITCH (NOT SHOWN).

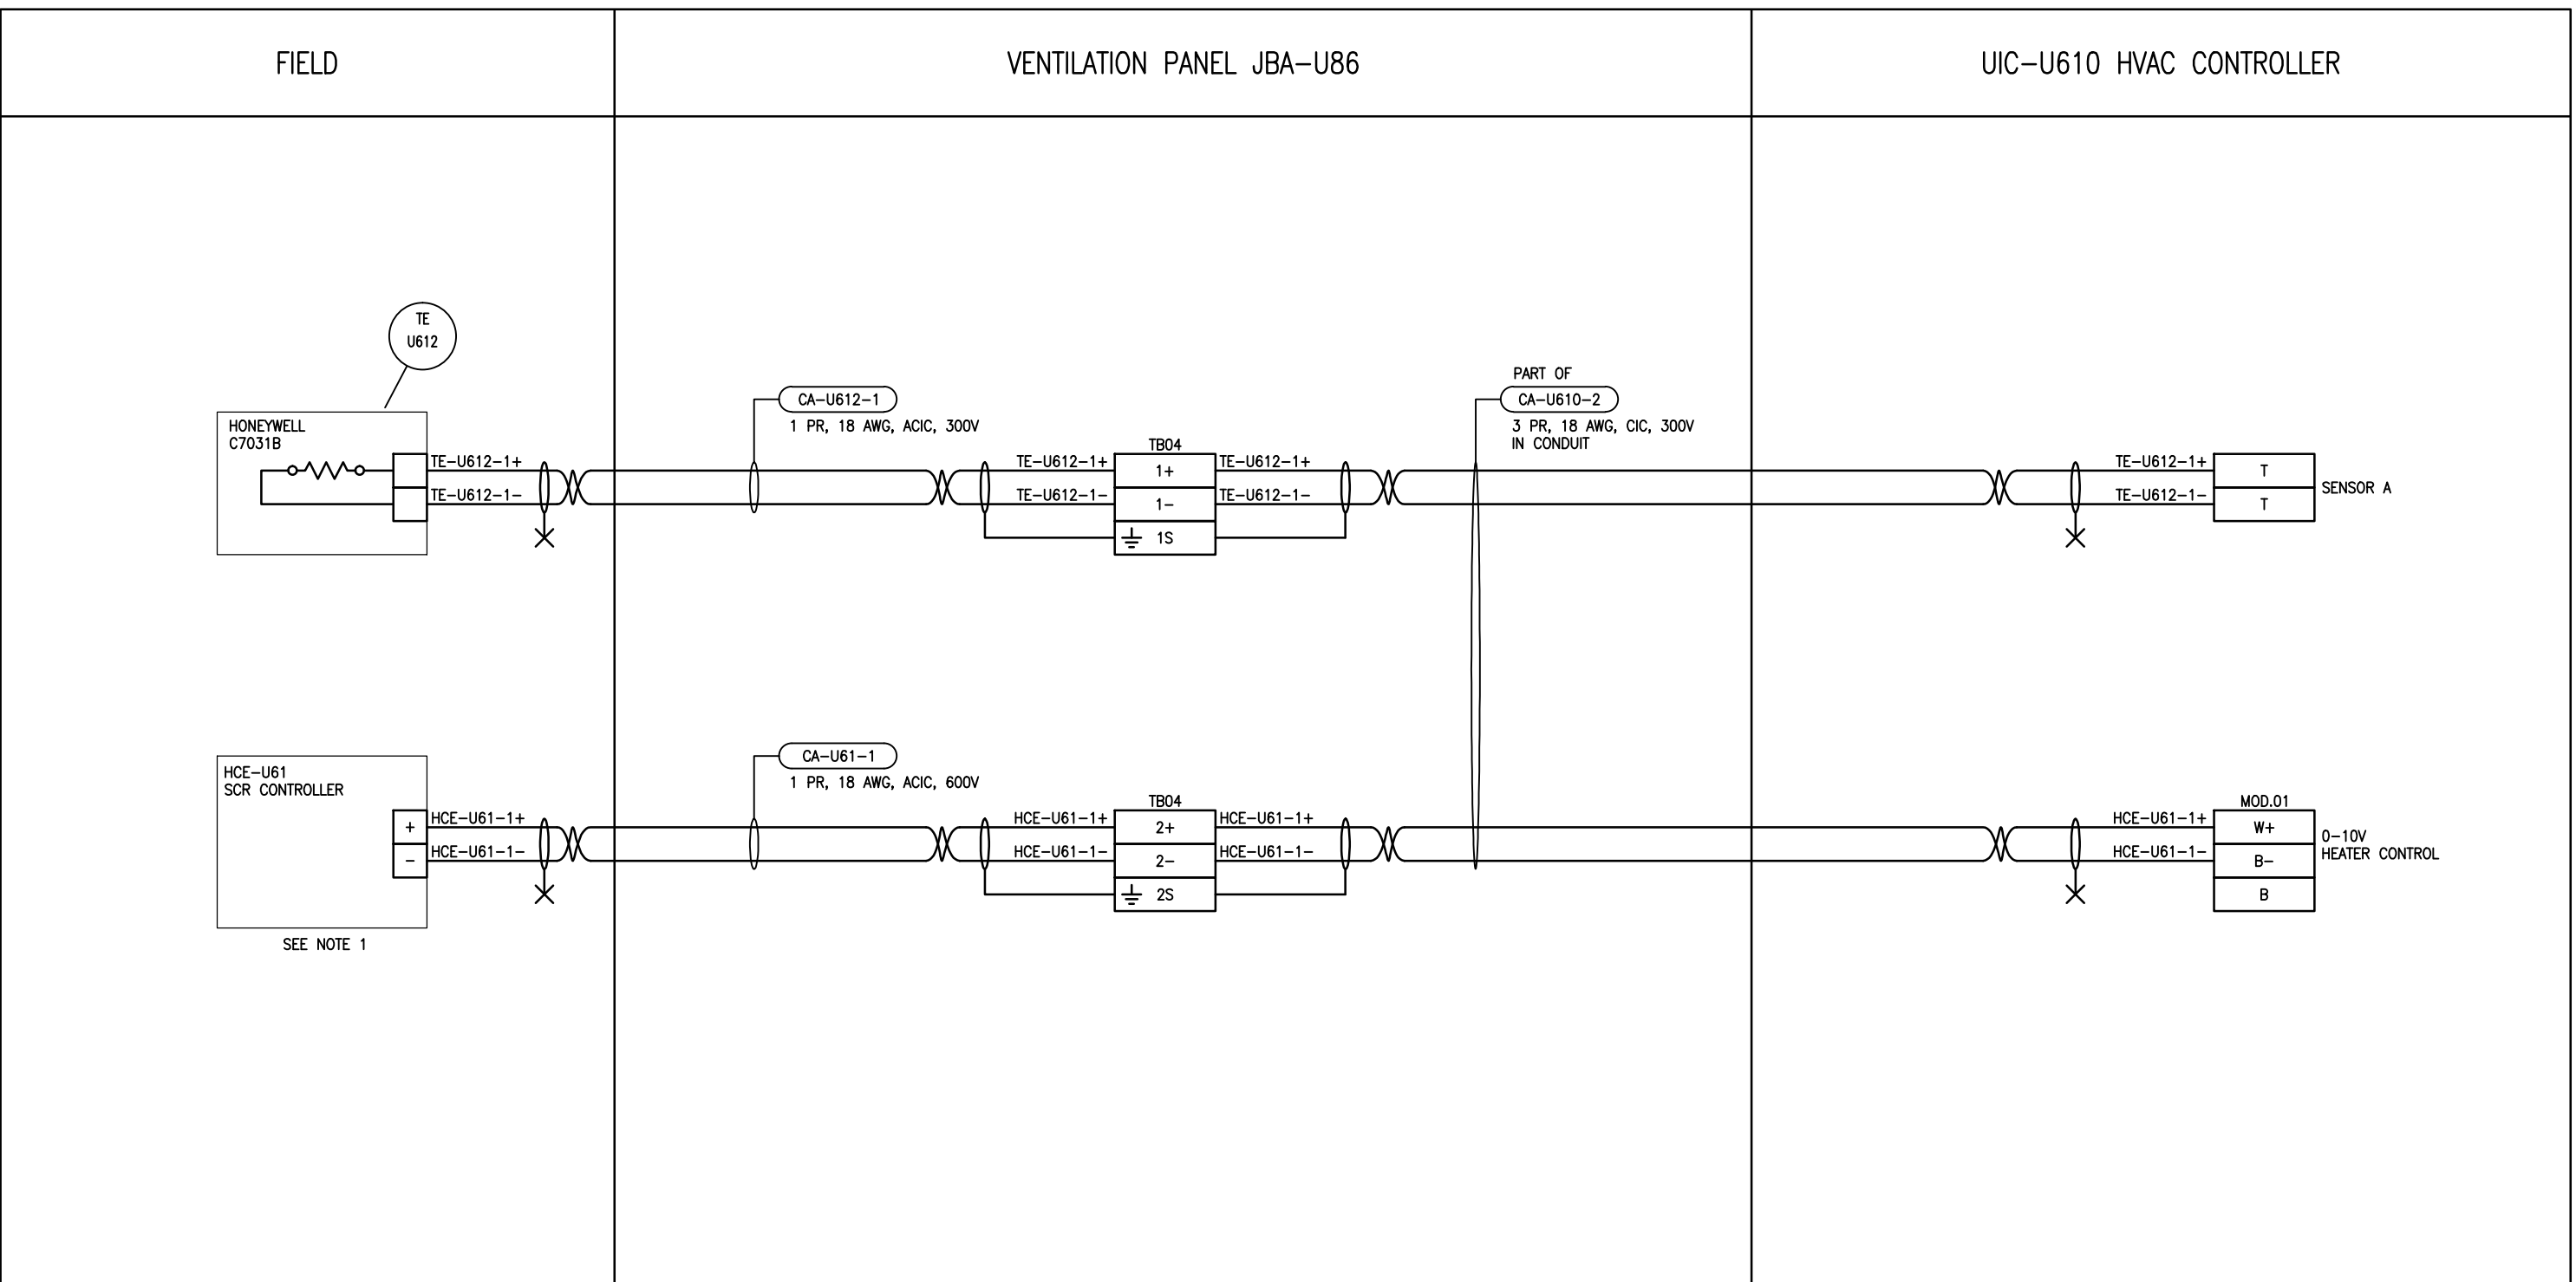

SNC-LAVALIN
 SNC-LAVALIN INC.
 148 Nature Park Way
 Winnipeg, MB, Canada R3P 0X7
 204-786-8080

NO.	REVISIONS	DATE	DESIGN	CHECK
00	ISSUED FOR TENDER, BID OPP. 475-2018	2018/05/09	TC	BC

DESIGNED BY: T. CHURCH	CHECKED BY: B. CLEVEN
DRAWN BY: Y. KONIG	APPROVED BY: B. CLEVEN
SCALE: NTS	DATE: 2018/04/10
ISSUED FOR CONSTRUCTION DATE:	
CONSULTANT NO.:	

ENGINEER'S SEAL

**PRELIMINARY
NOT TO BE
USED FOR
CONSTRUCTION**

THE CITY OF WINNIPEG
 WATER AND WASTE DEPARTMENT

METRO ROUTE 20 UNDERPASS PUMPING STATION
 2018 UPGRADES
 LOOP DIAGRAM
 MAIN FLOOR DUCT TEMPERATURE SENSOR AND DUCT HEATER
 TE-U612, HCE-U61

CITY DRAWING NUMBER	SHEET	REV.	SIZE
1-0309U-A0023	001	00	B