


LAST SAVE: 2018/05/09 - 2:03pm
 PATH: M:\674683\ENGR\481\CADD - General DWG\1-0310U-A0034-001-2A.dwg

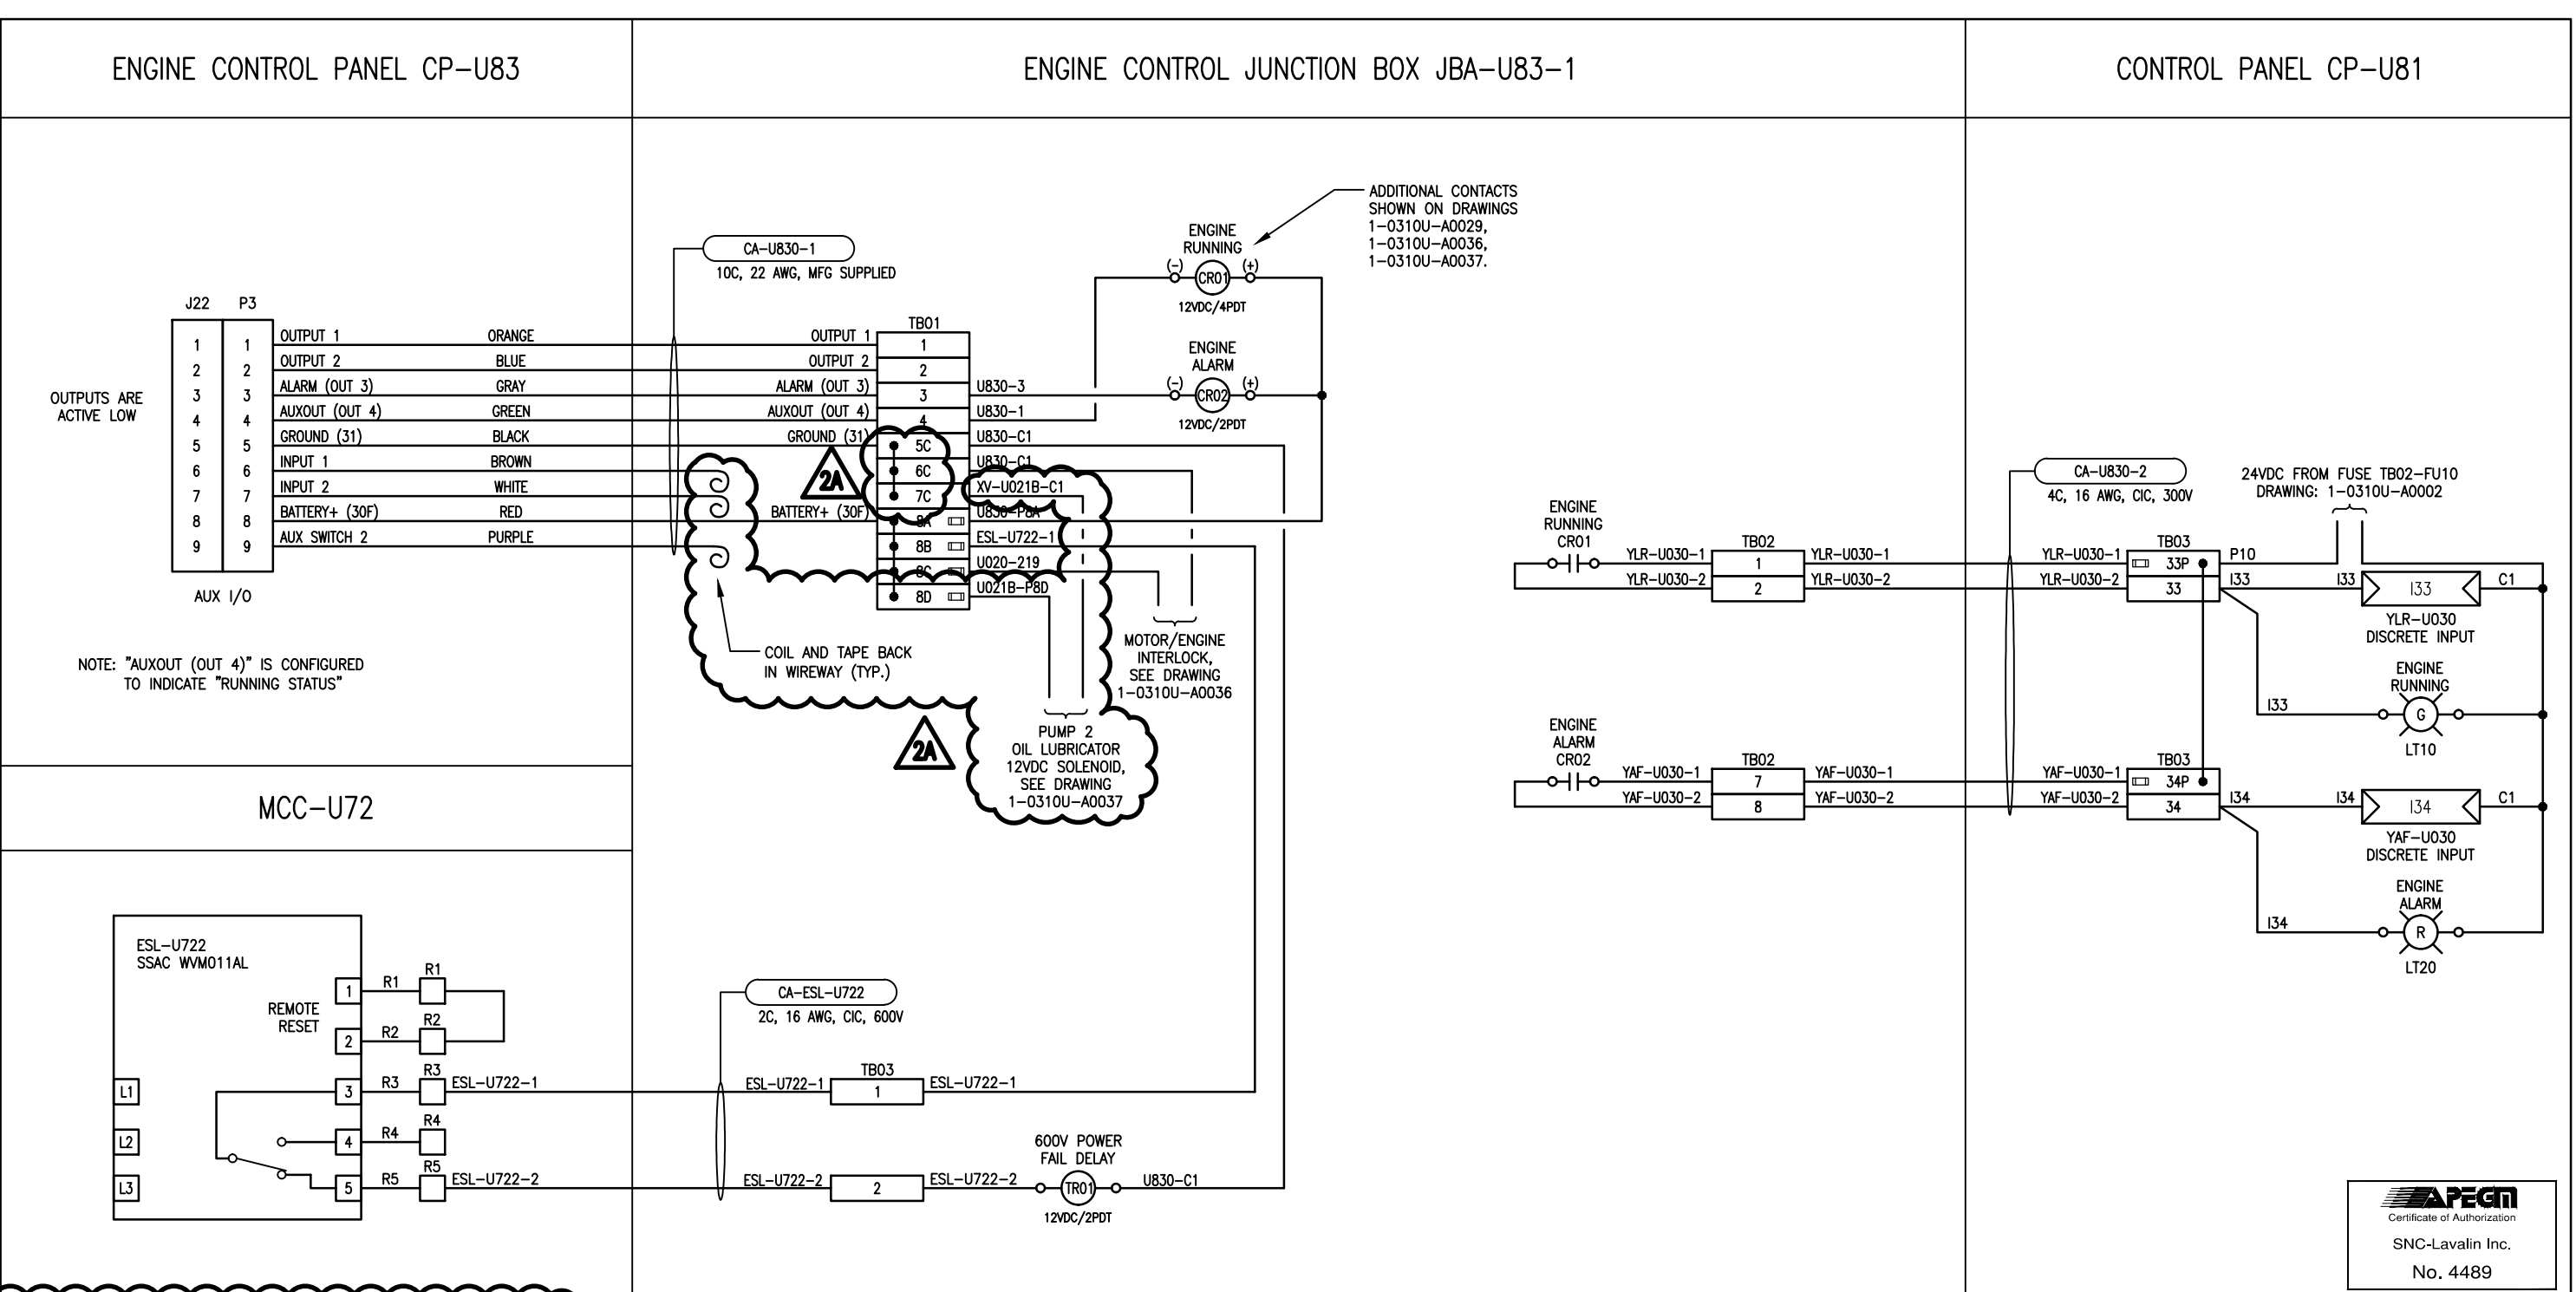

- REV 2A CHANGES:**
- CONTRACTOR TO COIL BACK AND TAPE WIRES AS SHOWN.
 - PROVIDE NEW TERMINAL TAGS 5C, 6C, 7C, AND 8D.
 - PROVIDE NEW FUSED TERMINAL, PHOENIX 3046142, PROVIDE NEW FUSE CONNECTOR, PHOENIX 3036806, PROVIDE NEW FUSE AND 2 AMP FUSE FOR TERMINAL 8D. EXISTING FEED-THRU TERMINAL '9' TO BE REPLACED WITH FUSED TERMINAL 8D.
 - PROVIDE NEW TERMINAL PLUG-IN BRIDGE, PHOENIX 3030365 FOR:
 - (A) BETWEEN 5C, 6C, AND 7C.
 - (B) BETWEEN 8A, 8B, 8C, AND 8D.
 - PROVIDE NEW BLUE TEW WIRING FROM TERMINAL 8D TO EXISTING RELAY CRO1. SEE DRAWING 1-0310U-A0037.

NO.	REVISIONS	DATE	DESIGN	CHECK
2A	ISSUED FOR TENDER, BID OPP. 475-2018	2017/10/06	BJC	FA
2B	ISSUED FOR CONSTRUCTION	2016/09/29	BJC	FA
01	REVISED INTERNAL WIRING	2016/09/12	BJC	FA
00	ISSUED FOR TENDER, BID OPP. 767-2016	2016/08/23	BJC	FA

SNC-LAVALIN INC.
 148 Nature Park Way
 Winnipeg, MB, Canada R3P 0X7
 204-786-8080

DESIGNED BY: B. CLEVEN
 CHECKED BY: F. ATAEI
 DRAWN BY: Y. KONIG
 APPROVED BY: I. PARKINSON
 SCALE: NTS
 DATE: 2016/07/05
 ISSUED FOR CONSTRUCTION
 DATE: 2016-08-29
 BY: K. ZUREK
 CONSULTANT NO.:

ENGINEER'S SEAL

PRELIMINARY
 NOT TO BE
 USED FOR
 CONSTRUCTION

THE CITY OF WINNIPEG
 WATER AND WASTE DEPARTMENT

ROUTE 90 UNDERPASS PUMPING STATION
 2016 UPGRADES
 LOOP DIAGRAM
 ENGINE ENG-U03 STATUS AND CONTROL

CITY DRAWING NUMBER	SHEET	REV.	SIZE
1-0310U-A0034	001	2A	B

