




LAST SAVE: 2018/05/09 - 2:06pm
 PATH: M:\634683\4ENG\481_C\DD - General DWG\1-0310U-A0037-001-00.dwg
 B SIZE - 279mm x 432mm

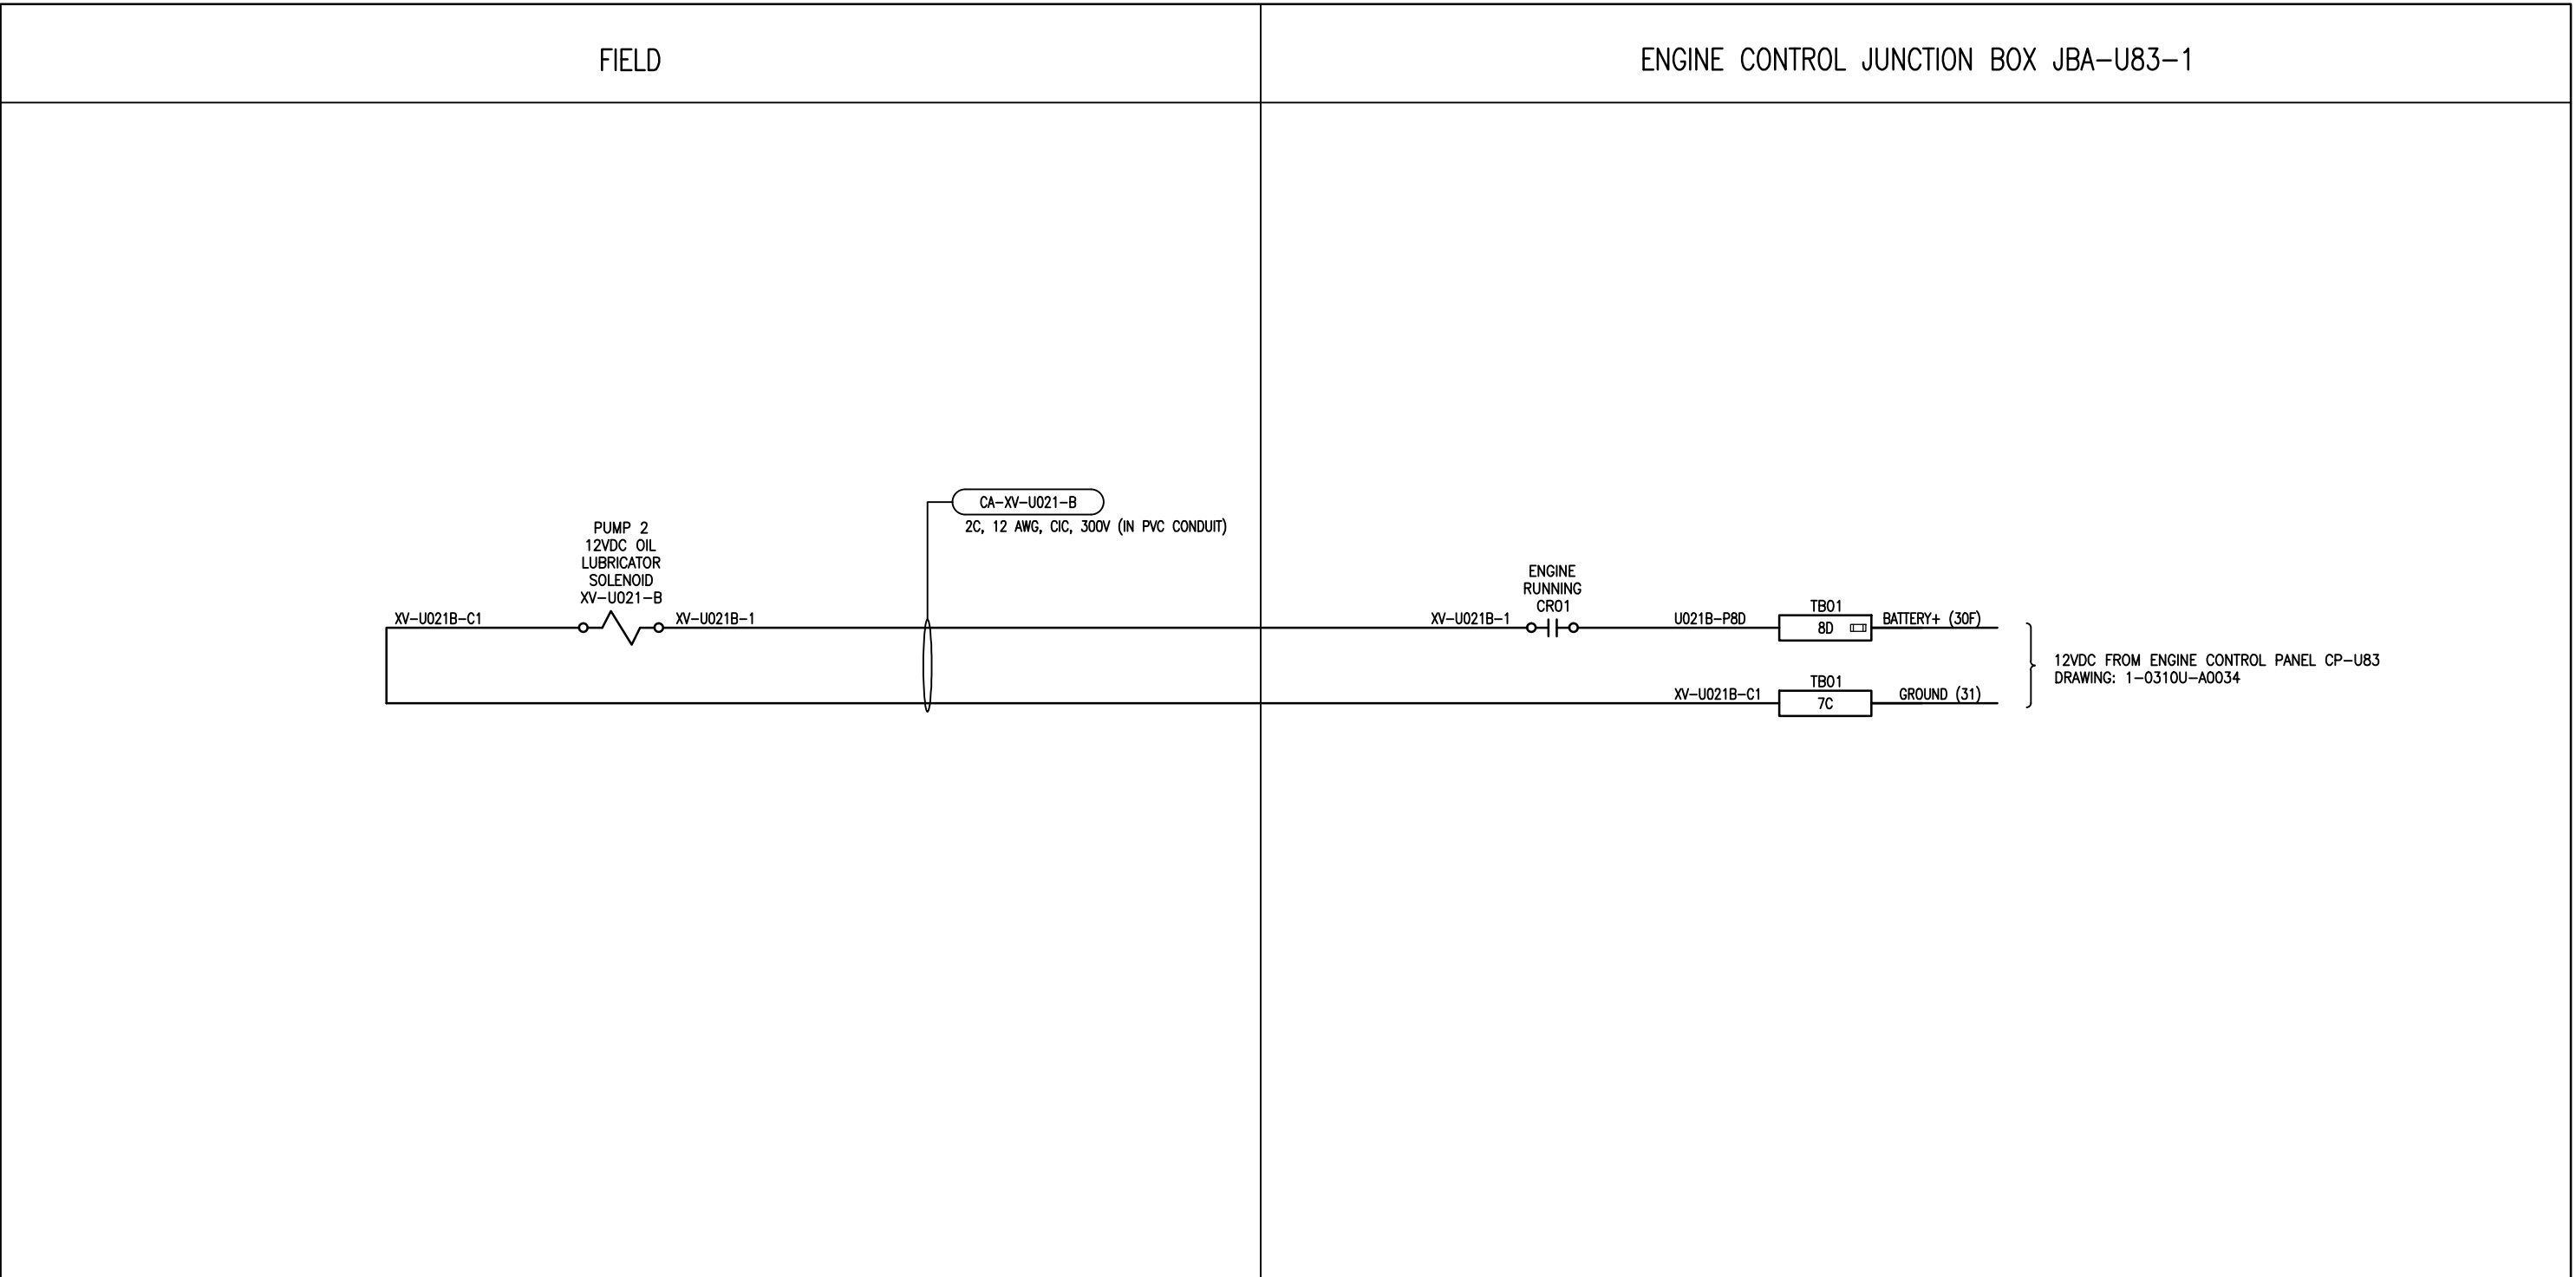


 Certificate of Authorization
 SNC-Lavalin Inc.
 No. 4489


				
00	ISSUED FOR TENDER, BID OPP. 475-2018	2018/05/09	BJC	FA
NO.	REVISIONS	DATE	DESIGN	CHECK

SNC-LAVALIN INC.
 148 Nature Park Way
 Winnipeg, MB, Canada R3P 0X7
 204-786-8080

DESIGNED BY: B. CLEVEN	CHECKED BY: F. ATAEI
DRAWN BY: Y. KONIG	APPROVED BY: B. CLEVEN
SCALE: NTS	DATE: 2017/10/06
ISSUED FOR CONSTRUCTION	
BY: _____ DATE: _____	
CONSULTANT NO.:	

ENGINEER'S SEAL

PRELIMINARY
 NOT TO BE
 USED FOR
 CONSTRUCTION


THE CITY OF WINNIPEG
 WATER AND WASTE DEPARTMENT

ROUTE 90 UNDERPASS PUMPING STATION
 2016 UPGRADES
 LOOP DIAGRAM
 PUMP 2 OIL LUBRICATOR 12VDC SOLENOID
 XV-U021-B

CITY DRAWING NUMBER	SHEET	REV.	SIZE
1-0310U-A0037	001	00	B