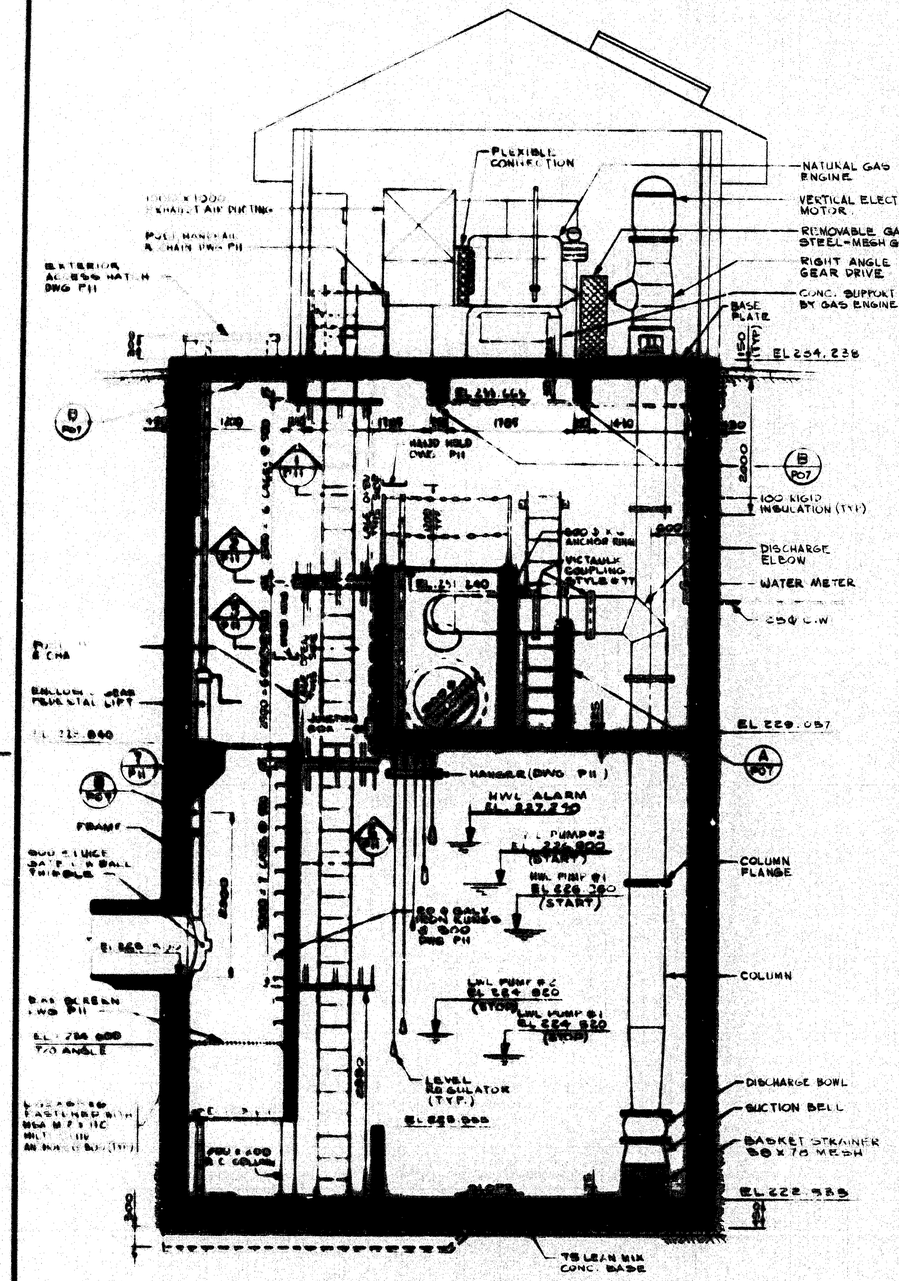

SECTION 1 (P06)
SCALE 1:40

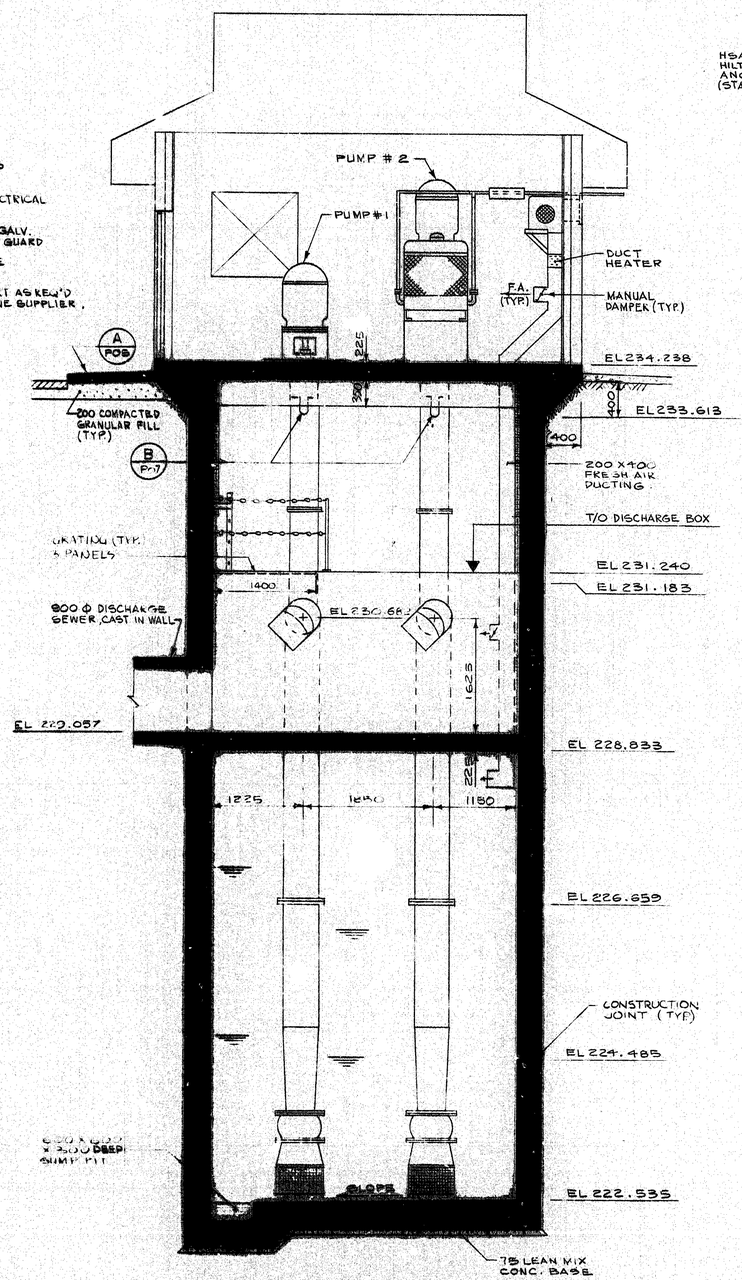

SECTION 2 (P06)
SCALE 1:40

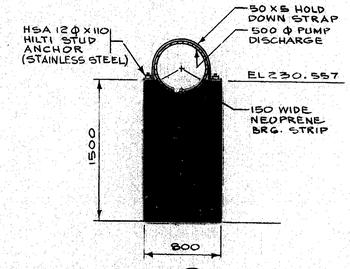

DETAIL A (P07)
CONCRETE SADDLE SUPPORT
SCALE 1:30

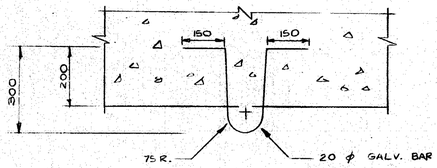

DETAIL B (P07)
SCALE 1:10
LIFT HOOK (GALV.)
(8 THUS)

NOTES
1. CONCRETE NOTES DWG. P06

0.5 0 1 2 3m
1:40

0.5 0 1 2m
1:30

0 01 02 03 04 05 0.75m
1:10

REVISED AS CONSTRUCTED
DATE 84.12.7 BY
CHECKED BY G. Mourant P.Eng.

B-5515-7
METRIC
WHOLE NUMBERS INDICATE MILLIMETRES
DECIMALIZED NUMBERS INDICATE METRES

NO	REVISIONS	DATE	APP
1	REV TO AS BUILT	NOV 84	LM

PROVINCE OF MANITOBA
G.W.J. MOURANT
10/6/82
REGISTERED ENGINEER
ENGINEER'S SEAL

INTERDISCIPLINARY ENGINEERING COMPANY
PROFESSIONAL ENGINEERS
WINNIPEG MANITOBA

DESIGNED BY: GJM	DRAWN BY: Ross L
CHECKED BY: AC, MM	DATE: 21-05-82
APPROVED BY: A. Ulyncha	DATE: 10/6/82

THE CITY OF WINNIPEG
WORKS & OPERATIONS DIVISION
STREETS & TRANSPORTATION DEPARTMENT

ROUTE 90 UNDERPASS
PUMP STATION
SECTIONS

AUTHORIZED BY: STREETS & WORKS ENGINEER	DATE: 1982-10-08
ACCEPTED BY:	DATE: 82 10 08
SCALE: AS SHOWN	DRAWING NO. U226-83-P07