


NOTES:

- THESE DRAWINGS SHALL NOT BE SCALED.
- THE CONTRACTOR SHALL VISIT THE SITE AND VERIFY ONESELF ALL DIMENSIONS, DATUM, AND DETAILED INFORMATION SHOWN ARE CORRECT.
- ALL PRODUCTS AND MATERIALS TO BE USED AND INSTALLED SHALL CONFORM WITH MANUFACTURER'S SPECIFICATIONS & APPLICABLE CODES.
- THE CONTRACTOR SHALL BE RESPONSIBLE TO PATCH AND MAKE GOOD ALL EXISTING CONSTRUCTION AFFECTED BY THE REMOVAL OF ALL ITEMS FORMING THE PART OF THE RENOVATION WORK.
- USE SPECIFIED BACKFILL IN ALL TRENCHES RUNNING BELOW ALL STRUCTURES, PAVING, WALKWAYS ETC.
- ALL EXISTING ROADS, SIDEWALKS, FENCING, PAVING & APPROACHES TO REMAIN TO BE PROTECTED DURING CONSTRUCTION TO THE CITY OF WINNIPEG STANDARDS AT THE CONTRACTORS OWN COSTS.
- FILL ALL HOLES & LOW AREAS TO DESIGN SUB-GRADE W/ COMPACTED FILL (SUITABLE TO SURFACE FINISH). FOR PAVED AREAS USE COMPACTED GRANULAR BASE (REFER TO SPECIFICATIONS).

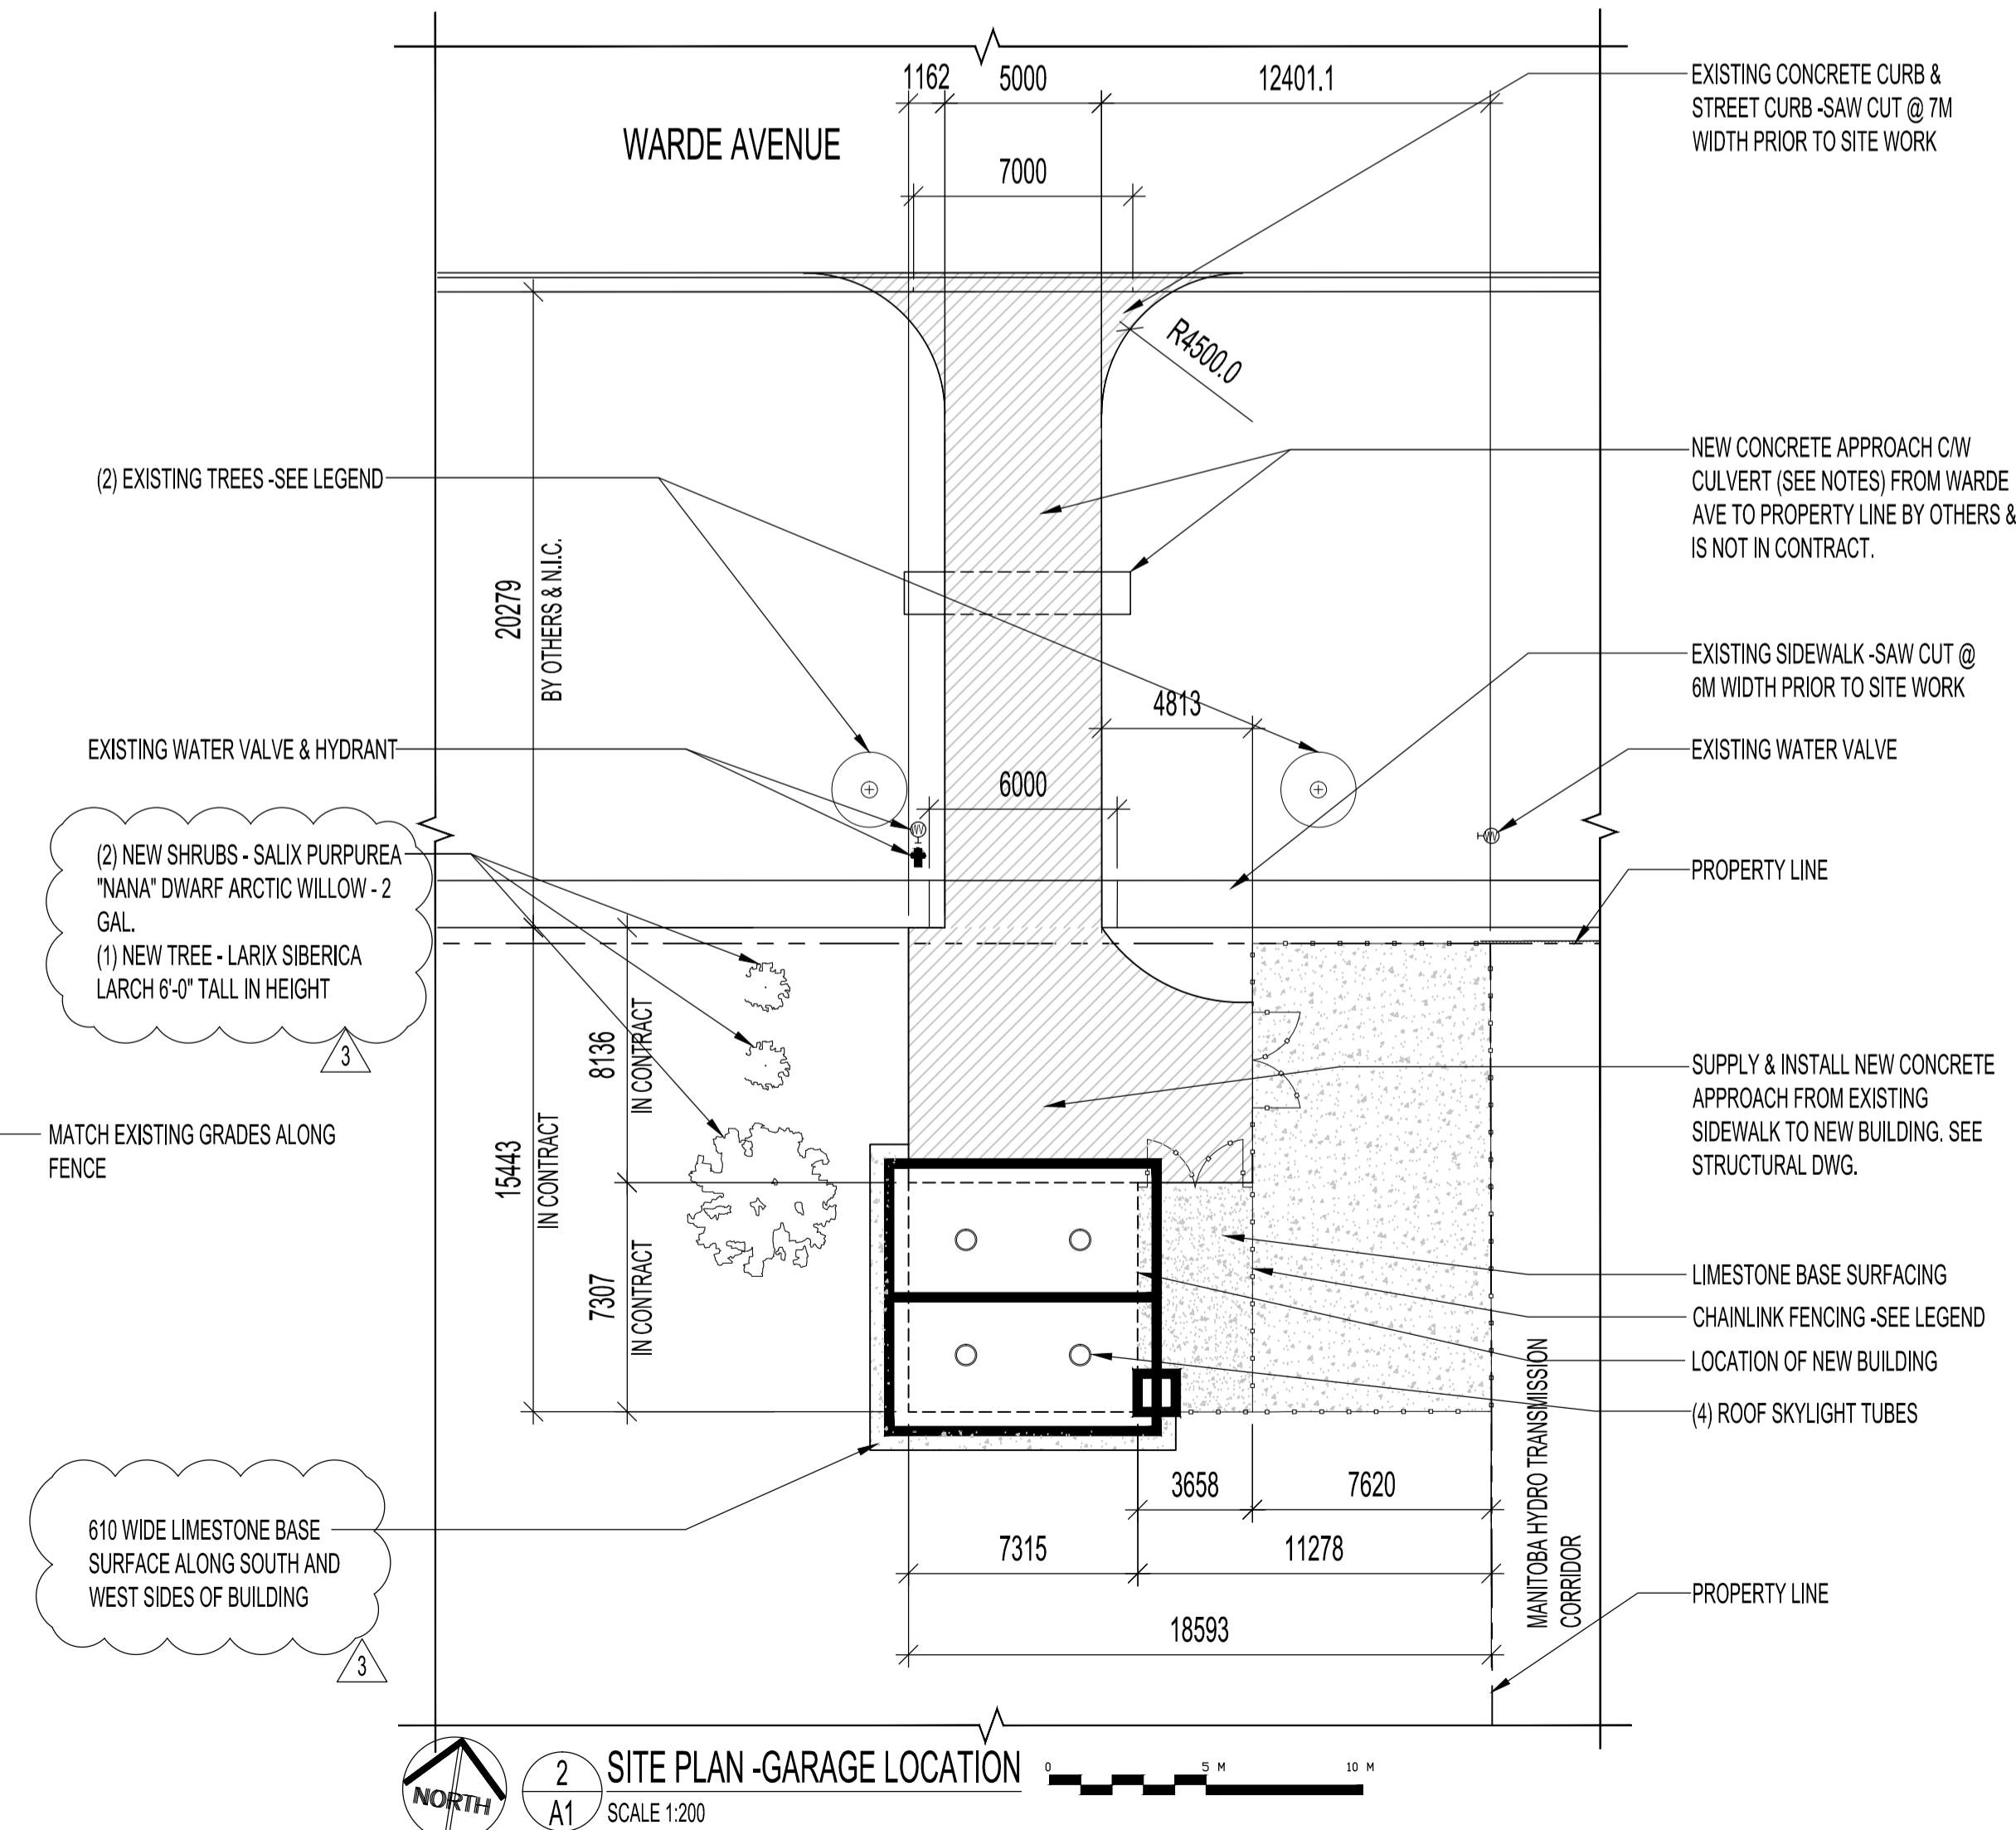

3 GENERAL REVISIONS JAW 2018.6.20

2 MODIFY BUILDING LOCATION AND APPROACH JAW 2018.05.04

ISSUED FOR CONSTRUCTION MMK 2016.01.27

No.	REVISION/DESCRIPTION	BY	DATE
3	GENERAL REVISIONS	JAW	2018.6.20
2	MODIFY BUILDING LOCATION AND APPROACH	JAW	2018.05.04

DATE	USER	CHECKED	DESIGNED	APPROVED
2016.01.04	MMK			

THE CITY OF WINNIPEG  
PLANNING, PROPERTY AND  
DEVELOPMENT DEPARTMENT  
MUNICIPAL ACCOMMODATIONS DIVISION  
3-65 GARRY STREET, R3C 4K4

PROJECT  
PUBLIC WORKS  
PARKS & OPEN SPACE DIVISION  
NEW PARKS GARAGE  
2050 WARDE AVENUE

SHEET TITLE  
SITE & BUILDING PLANS

SCALE	PROJECT No:	SHEET No:
AS SHOWN	2014-128	A1/L1 - R3