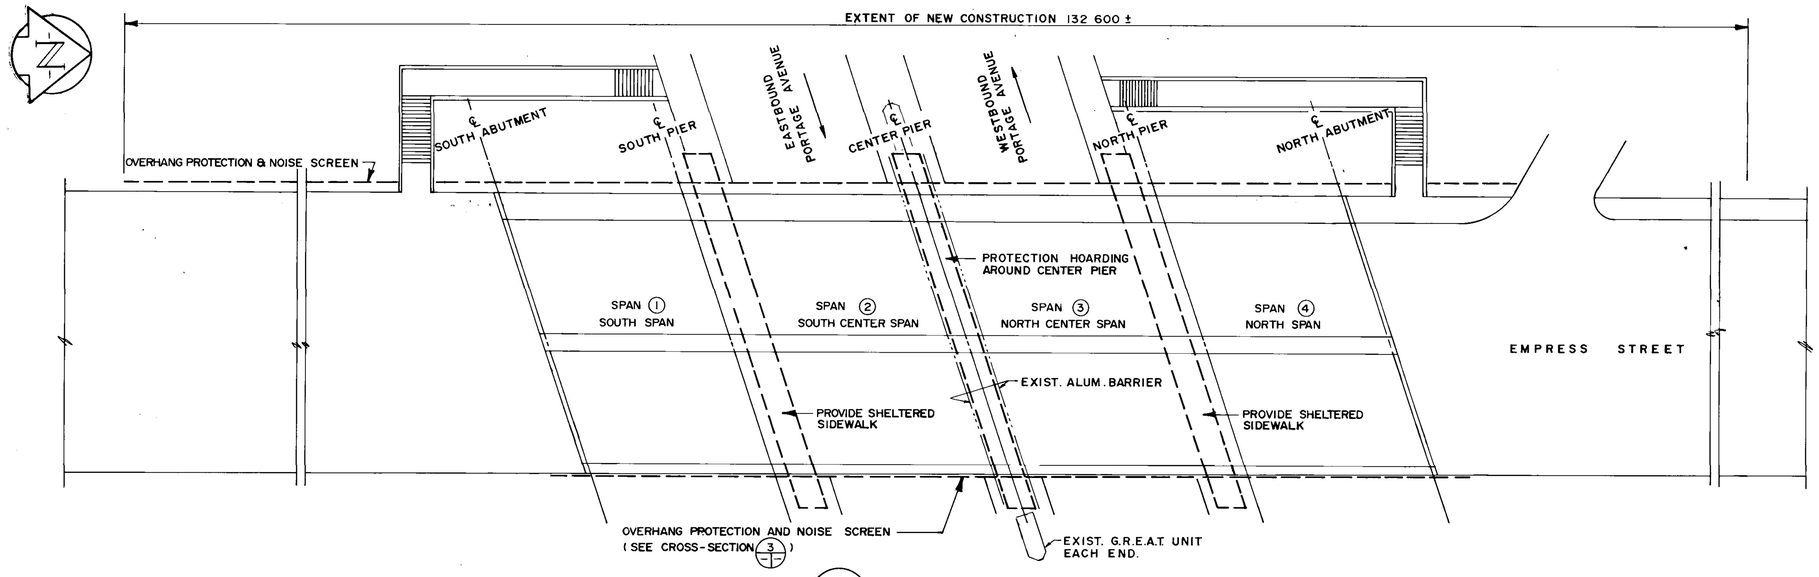

1 PLAN OF EXISTING BRIDGE
1 : 200

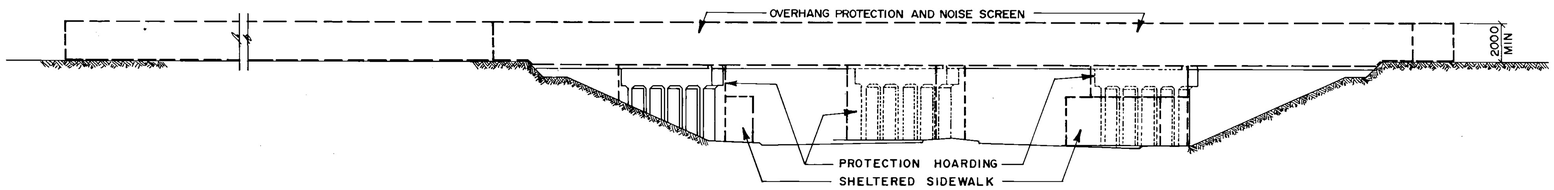

2 ELEVATION (LOOKING WEST)
1 : 200

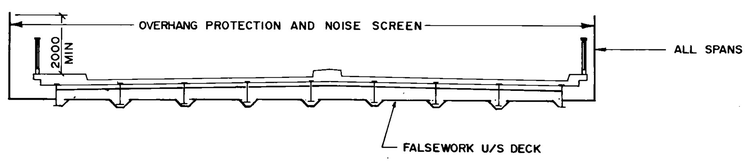

3 CROSS SECTION (LOOKING NORTH)
1 : 100

NOTE: 1. ALL OVERHANGING PROTECTION, NOISE SCREENS AND FALSEWORK U/S DECK, PIER HOARDING AND SHELTERED SIDEWALK SHALL BE IN PLACE FOR ENTIRE LENGTH OF CONSTRUCTION.

2. SHOP DRAWINGS OF ALL TEMPORARY NOISE AND PROTECTION SCREENS AND FALSEWORK U/S DECK SHALL BE SUBMITTED TO THE CONTRACT ADMINISTRATOR FOR APPROVAL AT LEAST 10 WORKING DAYS PRIOR TO INSTALLATION.

3. THE TEMPORARY NOISE AND PROTECTION SCREENS AND FALSEWORK U/S DECK SHALL BE DESIGNED BY A PROFESSIONAL ENGINEER REGISTERED IN THE PROVINCE OF MANITOBA.

B-5903-5

AS-BUILT
DATE 91.02.26 BY
CHECKED BY

LOCATION APPROVED
UNDERGROUND STRUCTURES
N/A
SUPV. U/G STRUCTURES COMMITTEE DATE

NOTE:
LOCATION OF UNDERGROUND STRUCTURES AS SHOWN ARE BASED ON THE BEST INFORMATION AVAILABLE BUT NO GUARANTEE IS GIVEN THAT ALL EXISTING UTILITIES ARE SHOWN OR THAT THE GIVEN LOCATIONS ARE EXACT. CONFIRMATION OF EXISTENCE AND EXACT LOCATION OF ALL SERVICES MUST BE OBTAINED FROM THE INDIVIDUAL UTILITIES BEFORE PROCEEDING WITH CONSTRUCTION

B.M.
ELEV.

NO	REVISIONS	DATE	BY
1	REVISED AS CONSTRUCTED	90-12-14	FPC

WARDROP ENGINEERING INC.

DESIGNED BY	JC & FPC	CHECKED BY	
DRAWN BY	LG	APPROVED BY	
HOR. SCALE: VERTICAL	AS NOTED	AUTHORIZED BY / DATE	90 02 23
		ACCEPTED BY / DATE	90 02 23
DATE	JAN. 15, 1990		

AUTHORIZED BY: B. NAUMKO / STREETS & BRIDGES ENGINEER
ACCEPTED BY: G.R. SMITH / BRIDGE ENGINEER

ENGINEER'S SEAL: PROVINCE OF MANITOBA — C. D. STEWART — 90/02/20 — REGISTERED ENGINEER

CONSULTANT DRAWING-NO. 890007-02-00

THE CITY OF WINNIPEG
WORKS AND OPERATIONS DIVISION
STREETS AND TRANSPORTATION DEPARTMENT

EMPRESS STREET OVERPASS
STRUCTURE REHABILITATION, STRENGTHENING AND RELATED WORKS

TEMPORARY NOISE AND PROTECTION SCREEN REQUIREMENTS

CITY DRAWING NUMBER
B100-90-05