


B SIZE - 279mm x 432mm

LAST SAVE: 2018/08/27 - 8:58am
 PATH: P:\Projects\2018\18-0107-007\Dwg\Elec\1-0102-AILD-P309-002.dwg

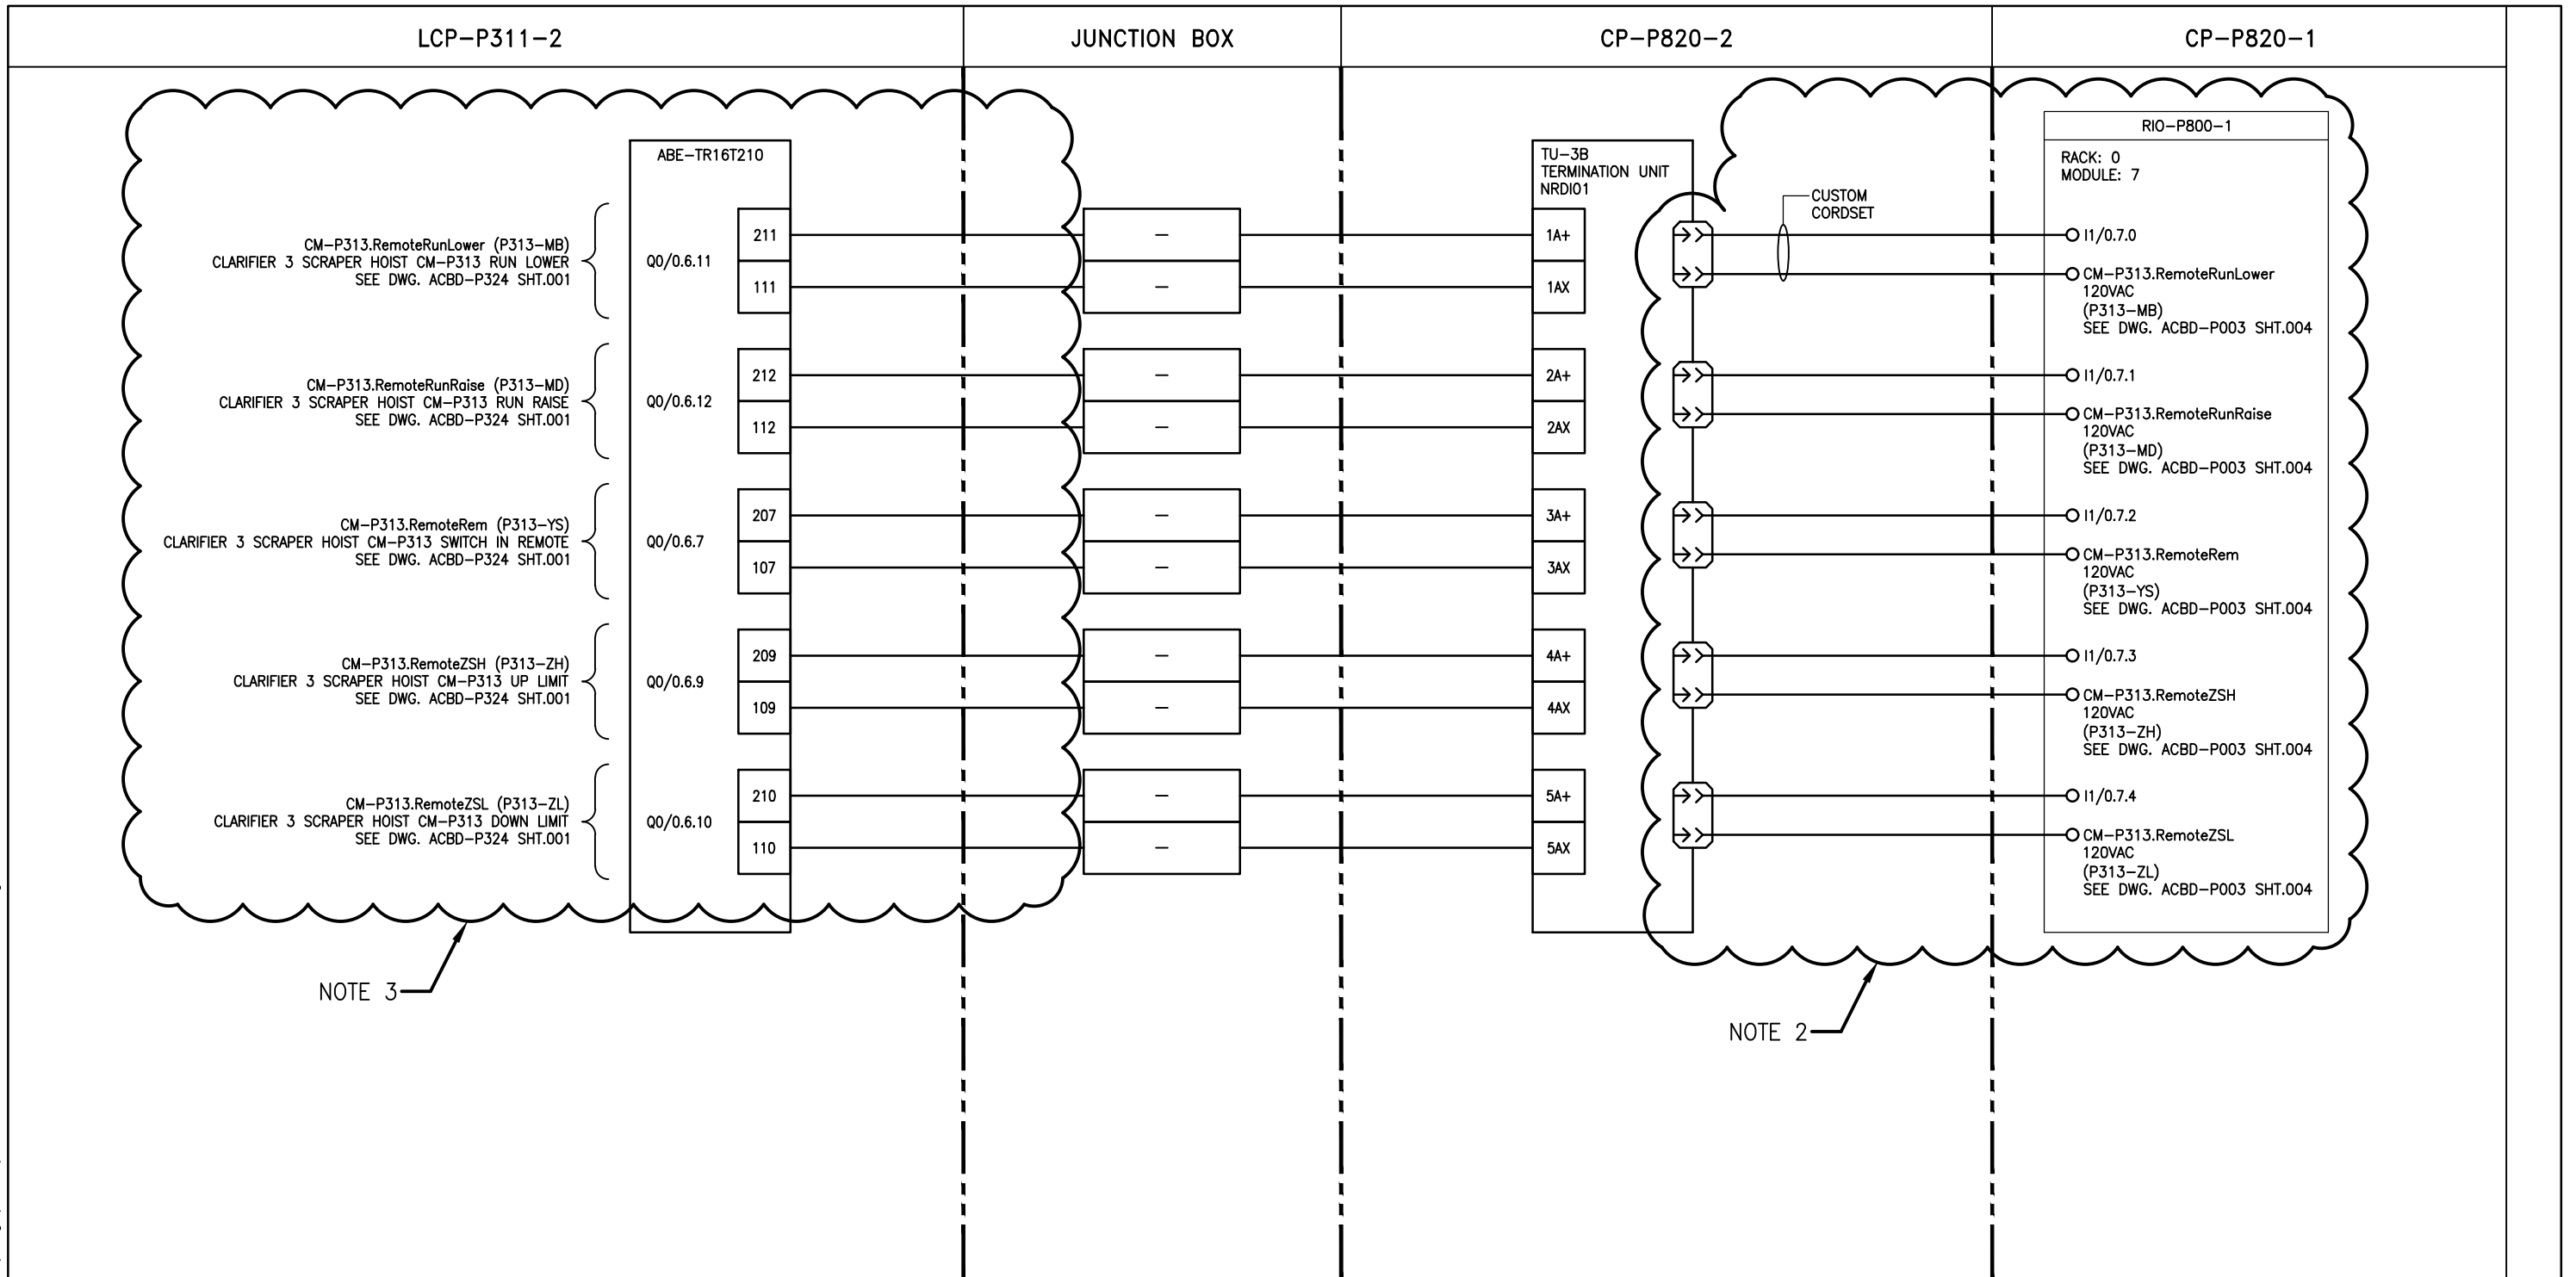

NOTE 3

NOTE 2

NOTES

1. PREVIOUS IDENTIFIERS ARE SHOWN IN PARENTHESES.
2. SCOPE OF WORK NOT A PART OF 682-2018 CONTRACT.
3. SCOPE OF WORK INCLUDED WITHIN 682-2018 CONTRACT.



NO.	REVISIONS	DATE	DESIGN	CHECK
00	ISSUED FOR CONSTRUCTION - 682-2018	2018/08/27	DDW	JAB



DESIGNED BY: D. WILSON	CHECKED BY: J. BOUCHARD
DRAWN BY: D. SHABATAEV	APPROVED BY: D. WILSON
SCALE: NTS	DATE: 2018/07/20
ISSUED FOR CONSTRUCTION	
BY: B. STATION	DATE: 2018/08/27
CONSULTANT NO.: 1-0102-AILD-P309-002	

ENGINEER'S SEAL



THE CITY OF WINNIPEG
 WATER AND WASTE DEPARTMENT

**SOUTH END WATER POLLUTION CONTROL CENTRE
 TRAVELLING BRIDGES REFURBISHMENT
 AUTOMATION - LOOP DIAGRAM
 RIO-P311 OUTPUTS / RIO-P800-1 INPUTS
 PRIMARY CLARIFIER 3 TRAVELLING BRIDGE INTERCONNECTION**

CITY DRAWING NUMBER	SHEET	REV.	SIZE
1-0102-AILD-P309	002	00	B