


B-17 Fire Station 17

1501 Church Avenue

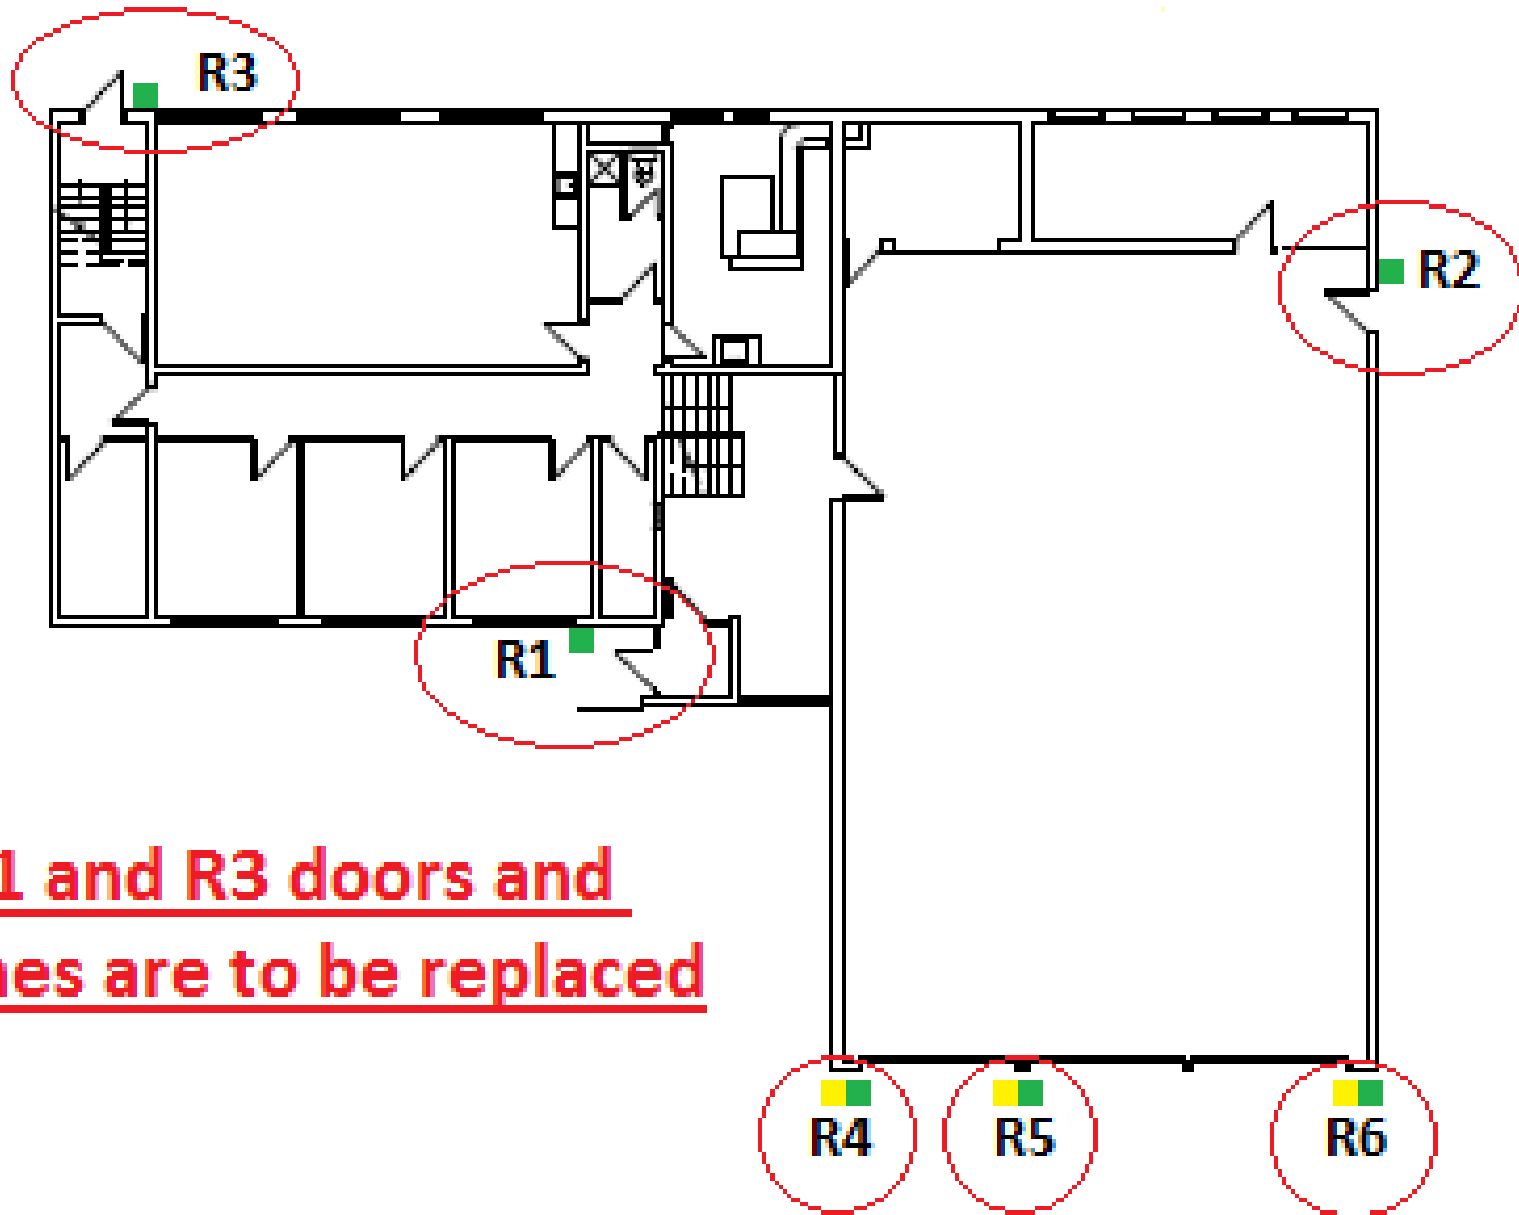

R1 and R3 doors and frames are to be replaced