

- NOTES:**
1. THIS DRAWING SUPERSEDES PART OF DRAWING Q-MCP-189.
 2. THIS DRAWING WAS GENERATED FROM EXISTING CITY OF WINNIPEG DOCUMENTATION, AND WAS NOT SITE VERIFIED IN DETAIL.
 3. THIS DRAWING WAS RENUMBERED FROM DRAWING 1-0640M-E0006, REVISION 01.
 4. CLOUDED PORTIONS OF THIS DRAWING INDICATE WORK TO BE COMPLETED. EITHER REMOVALS OF ADDITION AS INDICATED. REFER TO DEMOLITION AND CONSTRUCTION NOTES.



1-0640C-E0007	ELECTRICAL EQUIPMENT PLAN, CHLORINE BUILDING
1-0640M-E0032	SINGLE LINE DIAGRAM, MCC-M710
1-0640M-E0001	ELECTRICAL SINGLE LINE DIAGRAM LEGEND & DETAILS
DRAWING NUMBER	REFERENCE DRAWINGS

NO.	REVISIONS	DATE	DESIGN	CHECK
03	ISSUED FOR TENDER AND CONSTRUCTION	2019/10/18	VE	KS
02	ISSUED FOR CITY USE	2011/11/01	BC	CJR
01	REVISED DRAWING NUMBER	2008/02/13	AEO	-
00	ISSUED FOR CITY USE	2007/08/28	YM	-

SNC-LAVALIN INC.
 148 Nature Park Way
 Winnipeg, MB, Canada R3P 0X7
 204-786-8080

DESIGNED BY: EXISTING
 CHECKED BY: CJR


DRAWN BY: CJR
 APPROVED BY: CJR

SCALE: NTS
 ISSUED FOR CONSTRUCTION

DATE: 2005/11/21
 BY: A. WEISS

DATE: 2019/10/18

CONSULTANT NO.: 113292-0005-47DD-0301

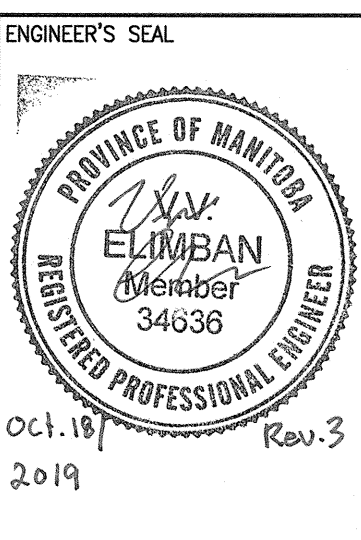

THE CITY OF WINNIPEG
 WATER AND WASTE DEPARTMENT

MCPHILLIPS PUMPING STATION

ELECTRICAL SINGLE LINE DIAGRAM
RESERVOIR VALVE HOUSE

CITY DRAWING NUMBER: 1-0640R-E0001
 SHEET: 001
 REV.: 03
 SIZE: A1