


HARDWARE GROUP SCHEDULE	
GROUP 1 (UTILITY)	
3	HINGES
1	DOOR CLOSER
1	LOCKSET (STOREROOM LOCK)
1	FLOOR STOP
1	SMOKE SEAL

PROJECT STANDARD HARDWARE:
SCHLAGE DECORATIVE TRIM
LEVER TYPE
BRUSHED NICKEL FINISH
INCLUDING HINGES

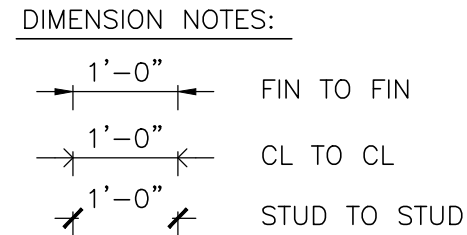

DOOR SCHEDULE LEGEND	
RH	- RIGHT HAND
LHR	- LEFT HAND REVERSE
PT	- PAINT
S	- STANDARD
HM	- HOLLOW METAL


WALLS:	
P1	(1) LAYER 1/2" DW 2"x4" STUDS (1) LAYER 1/2" DW
P2	(1) LAYER 1/2" DW 2"x4" STUDS BATT INSULATION (1) LAYER 1/2" DW
P3	(1) LAYER 1/2" DW 2"x6" STUDS BATT INSULATION (1) LAYER 1/2" DW
P4	1.0 HR. FRR. WALL NBC W1a (1) LAYER 5/8" TYPE "X" DW 2"x 4" STUDS MINERAL BATT INSULATION (1) LAYER 5/8" TYPE "X" GWB EXTEND WALL TO U/S ROOF

DOOR SCHEDULE														
DOOR NO	TO ROOM	SIZE	DOOR				FRAME				HDW GROUP	FIRE RATING	GRILLES	COMMENTS
			SWING	TYPE	MATL	FINISH	PROFILE	TYPE	MATL	FINISH				
D01	MECHANICAL ROOM	3'-0" x 7'-0"	RH	D1	HM	PT	S	F1	HM	PT	1	0.75H		


REMOVE DW NEW WASHROOM SIDE, ADD STRAPPING TO EXISTING STUDS TO CREATE 6" PLUMBING SPACE, BATT.COVER WITH NEW DW AND FINISH

NOTE 1: SEE ELEVATION-SHEET A2.7 LAV SECTION

NOTE 2: REMOVE EXISTING WALL FAN INSTALL NEW AS PER MECHANICAL, PATCH AND REPAIR WALLS(INTERIOR/EXTERIOR AS NEEDED).

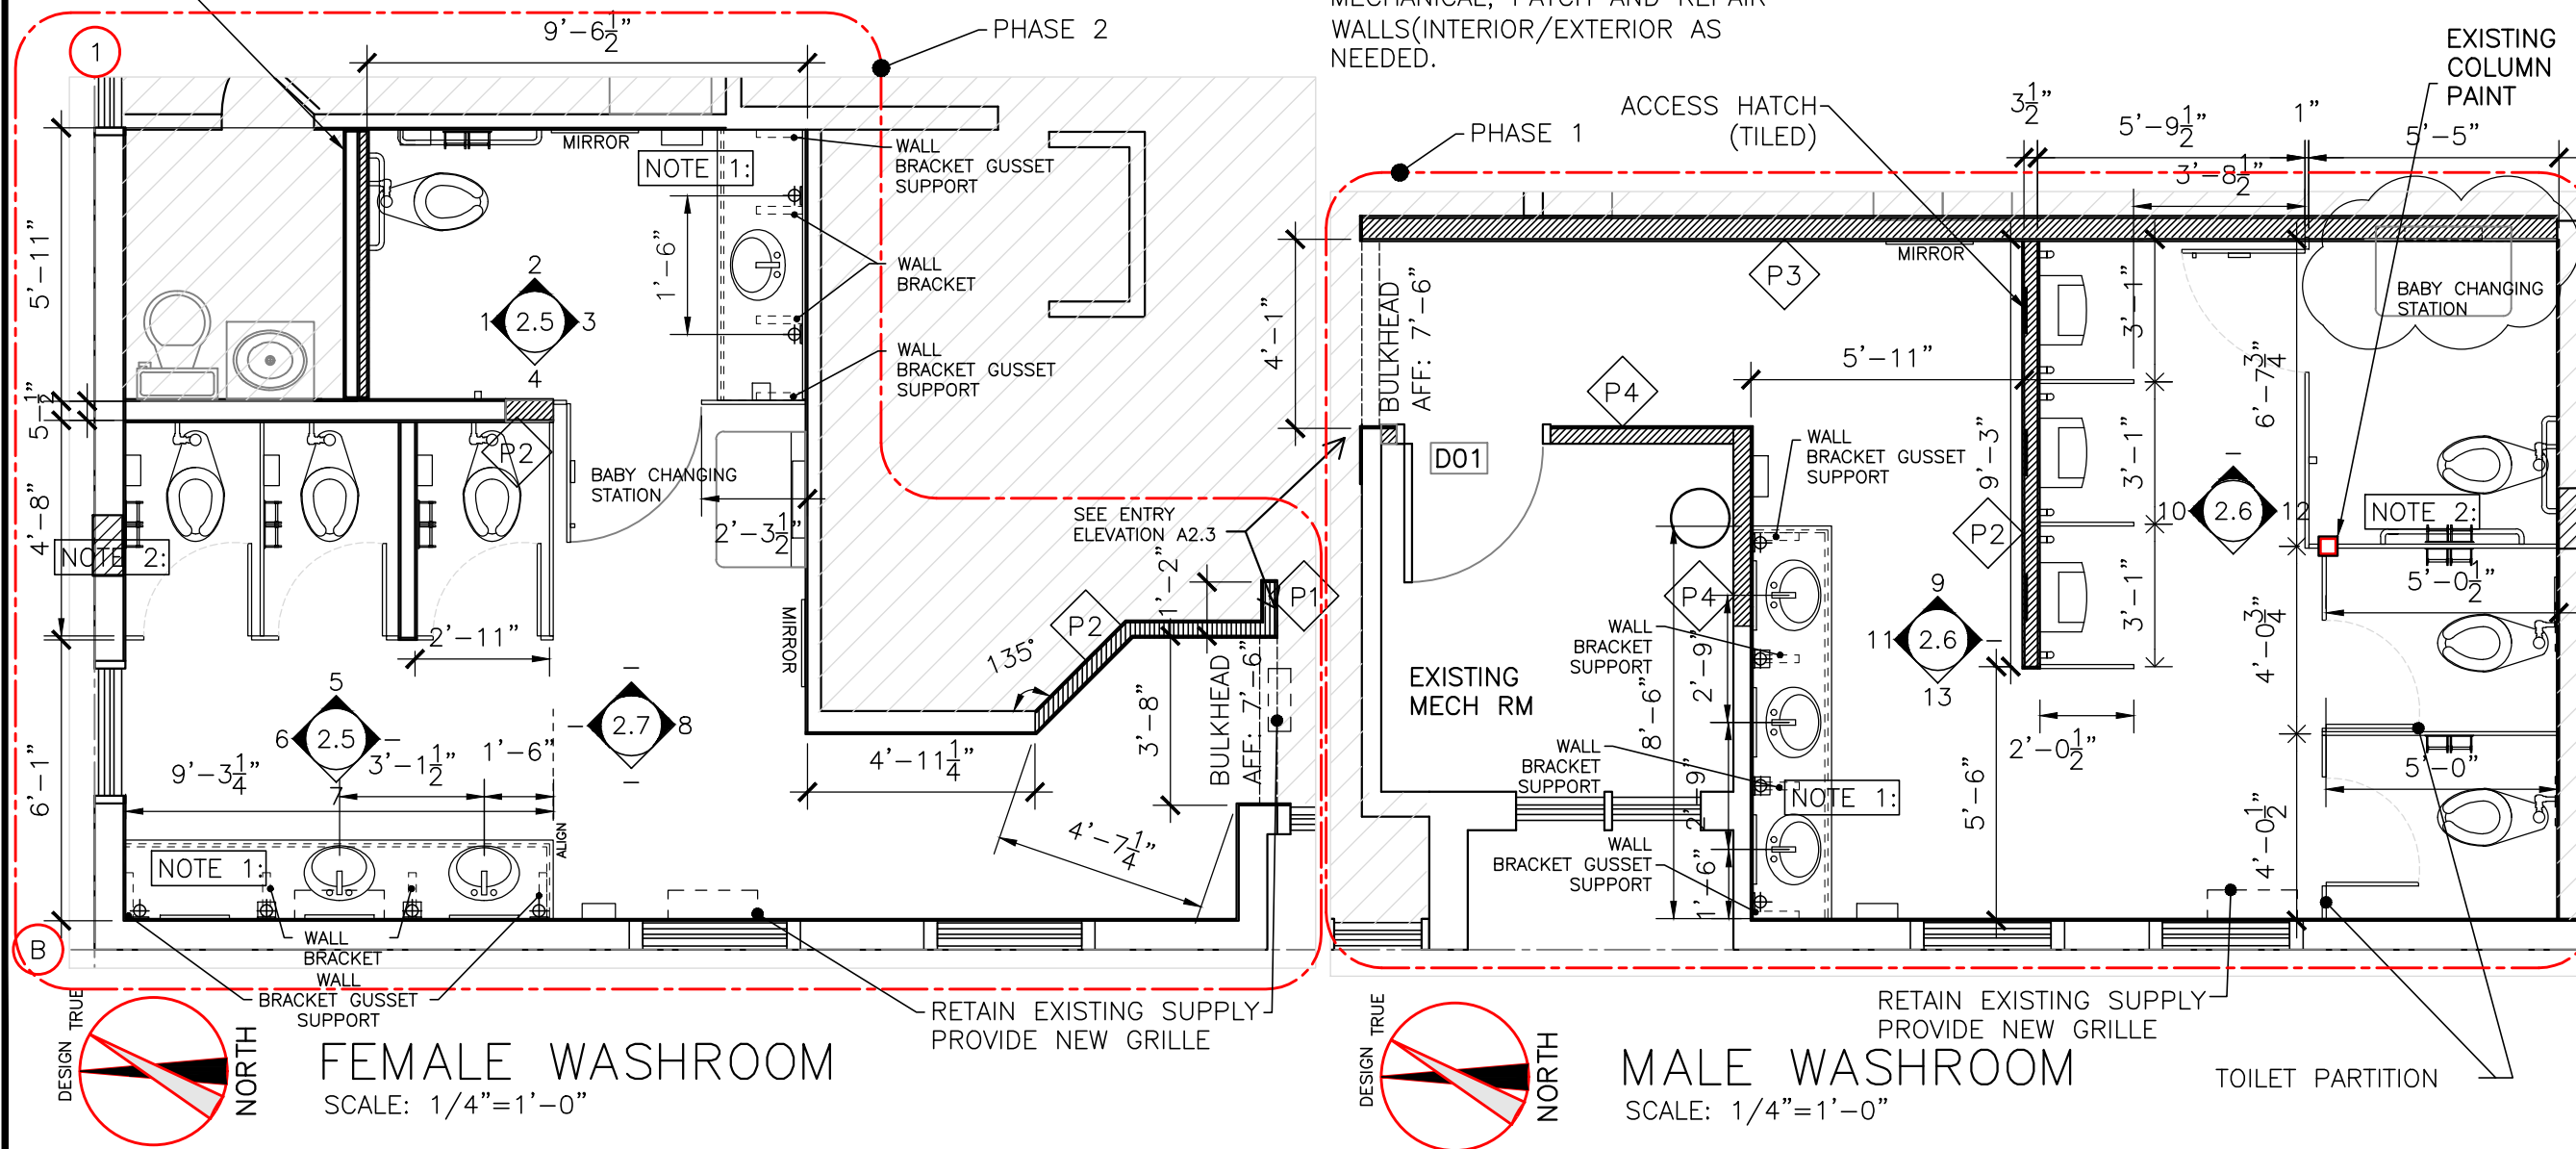

REV	DESCRIPTION	DATE	BY
02	ISSUED FOR REV.2	NOV 7 2019	VJ
01	ISSUED FOR REV.1	OCT 31 2019	AR
0	ISSUED FOR CONSTRUCTION	OCT 11 2019	AR

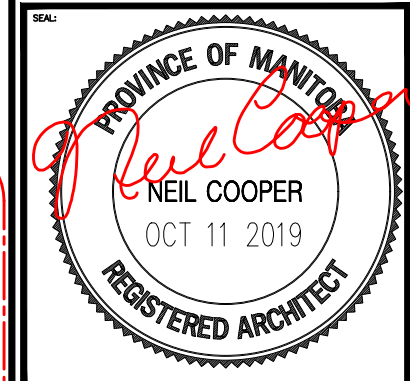

THIS DRAWING MUST NOT BE SCALED.
THE GENERAL CONTRACTOR SHALL VERIFY ALL DIMENSIONS, DATUMS AND LEVELS PRIOR TO COMMENCEMENT OF WORK AND IS HELD RESPONSIBLE FOR REPORTING ANY DISCREPANCY OR OMISSION TO NEIL COOPER ARCHITECT IMMEDIATELY.
THIS DRAWING IS THE EXCLUSIVE PROPERTY OF NEIL COOPER ARCHITECT AND CAN BE REPRODUCED ONLY WITH THE PERMISSION OF NEIL COOPER ARCHITECT, IN WHICH CASE THE REPRODUCTION MUST BEAR THEIR NAME AS THE ARCHITECTURAL FIRM.

DRAWING: PROPOSED FLOOR PLAN
PROJECT: Interior Reno - Washroom
KILDONAN PARK CLUBHOUSE
2015 Main Street, WPG MB

Neil Cooper Architect
109-374 River Avenue, Winnipeg, Manitoba R3L 0E4

TENDER 1123-2019			
DRAWN BY: AR	CHECKED BY: NC	SHEET NO: A2.3R2	REV NO:
DATE: MAY 23 2019	SCALE: As Noted		
FILE: 19058/Cont Doc/Cont Dwg/Arch/A2.1.dwg			