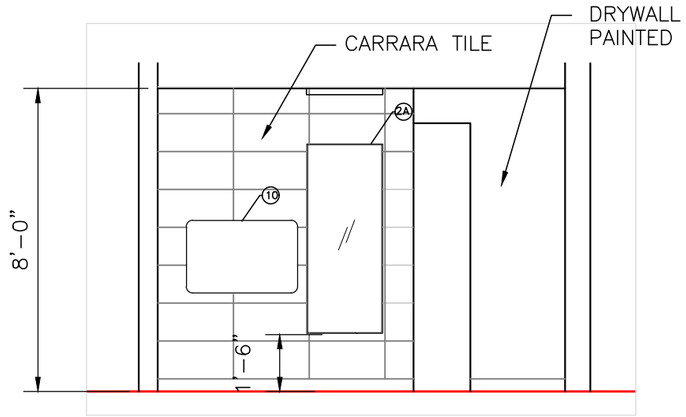

ELEV 8

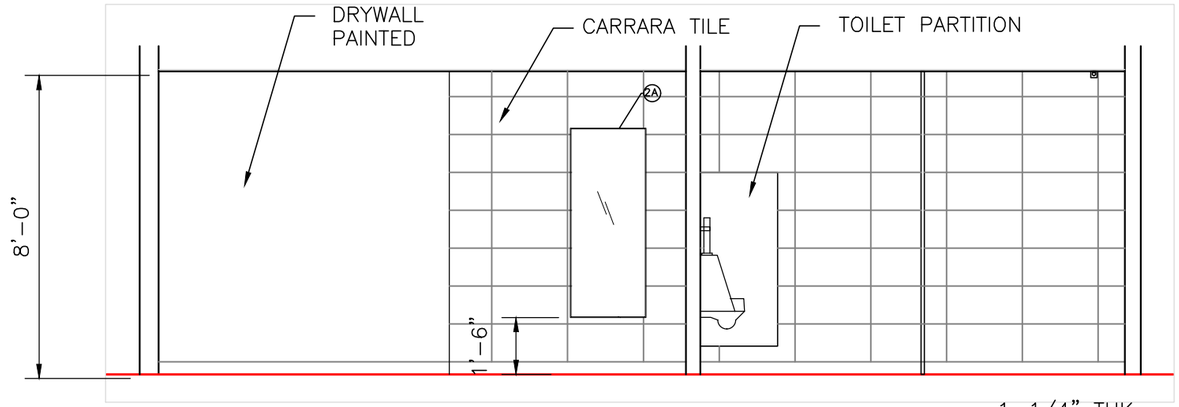

ELEV 9

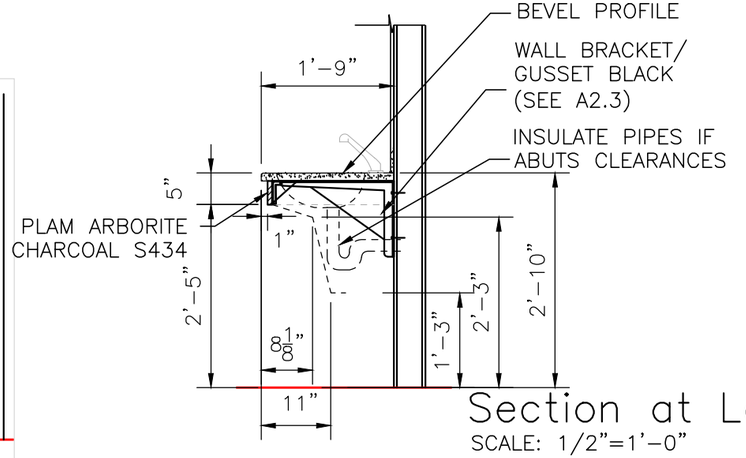

Section at Lav

SCALE: 1/2"=1'-0"

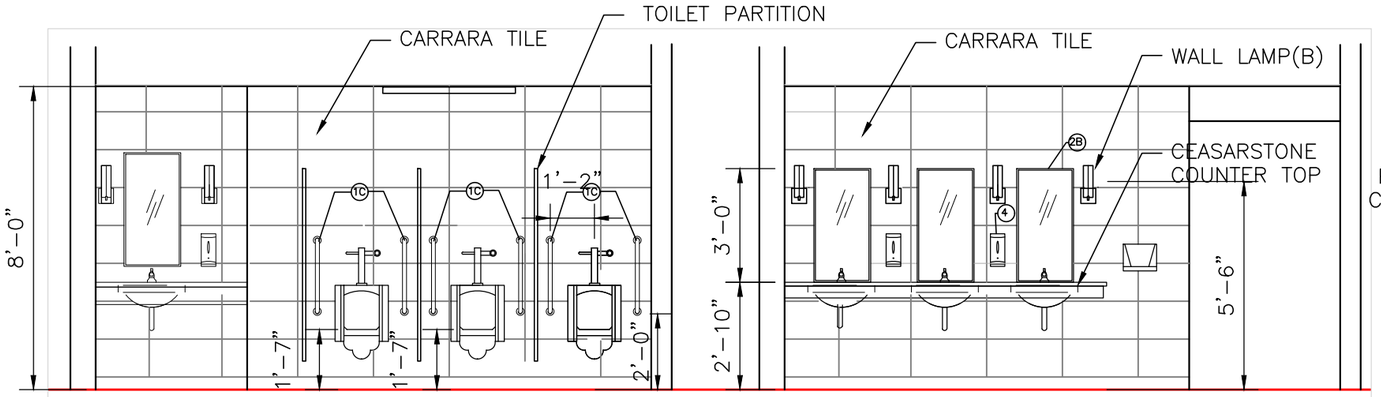

ELEV 10

ELEV 11

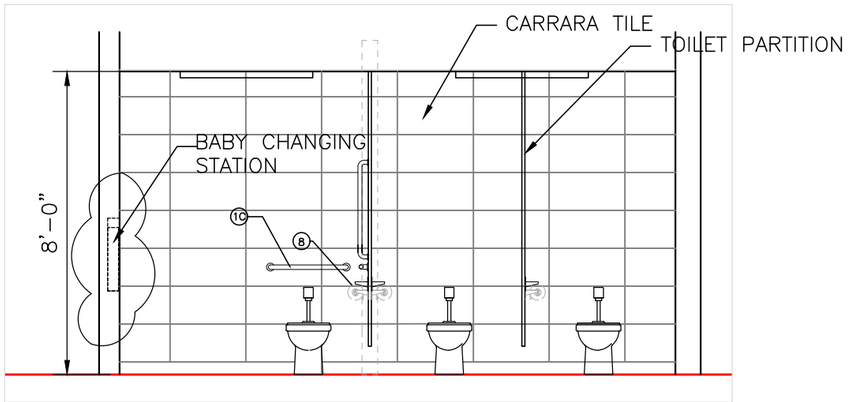

ELEV 12

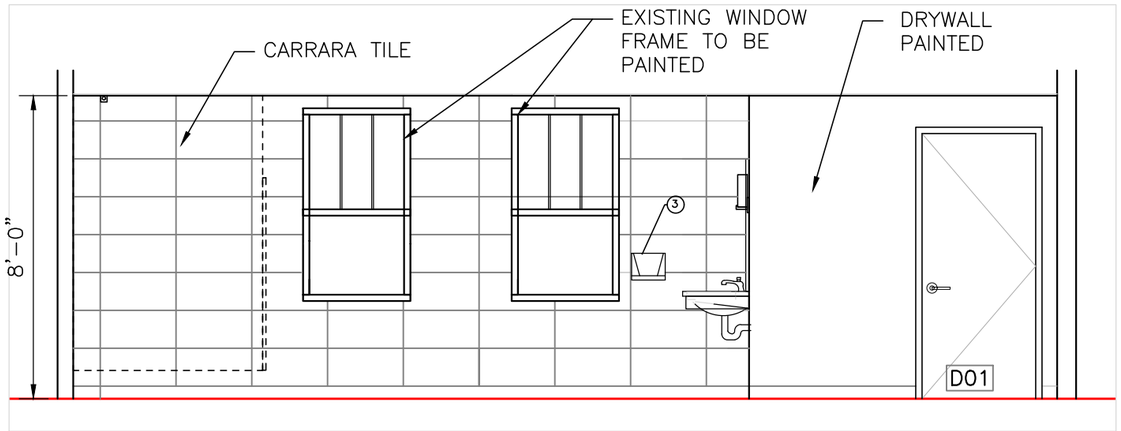

ELEV 13

Interior Elevation

SCALE: 1/4"=1'-0"

REV	DESCRIPTION	DATE	BY
02	ISSUED FOR REV2	NOV 7, 2019	VJ
01	ISSUED FOR REV1	OCT 31 2019	AR
0	ISSUED FOR CONSTRUCTION	OCT 8 2019	AR

SEAL:

PROVINCE OF MANITOBA
NEIL COOPER
OCT 11 2019
REGISTERED ARCHITECT

THIS DRAWING MUST NOT BE SCALED.

THE GENERAL CONTRACTOR SHALL VERIFY ALL DIMENSIONS, DATUMS AND LEVELS PRIOR TO COMMENCEMENT OF WORK AND IS HELD RESPONSIBLE FOR REPORTING ANY DISCREPANCY OR OMISSION TO NEIL COOPER ARCHITECT IMMEDIATELY.

THIS DRAWING IS THE EXCLUSIVE PROPERTY OF NEIL COOPER ARCHITECT AND CAN BE REPRODUCED ONLY WITH THE PERMISSION OF NEIL COOPER ARCHITECT, IN WHICH CASE THE REPRODUCTION MUST BEAR THEIR NAME AS THE ARCHITECTURAL FIRM.

DRAWING:

INTERIOR ELEVATION

PROJECT:

Interior Reno – Washroom

KILDONAN PARK CLUBHOUSE

2015 Main Street, WPG MB

Neil Cooper Architect

109-374 River Avenue, Winnipeg, Manitoba R3L 0E4

TENDER 1123-2019

DRAWN BY:	CHECKED BY:	SHEET NO:	REV NO:
AR	NC	A2.7	R2

DATE: MAY 23 2019

SCALE: As Noted

FILE: 19058/Cont Doc/Cont Dwg/Arch/A2.1.dwg