

О. Ρ.

Β.

C.

D.

E.

F

G.

Η.

Ι.

J.


Μ.

REQUIREMENTS.

AS REQUIRED.

EQUIPMENT TO OWNER.

EXTENT OF KNOWN CONSTRUCTION INFORMATION. ALL EXISTING VOICE/DATA DEVICES, CCTV CAMERAS, OVERHEAD PAGING SPEAKERS AND INTRUSION DETECTION DEVICES TO BE Q.

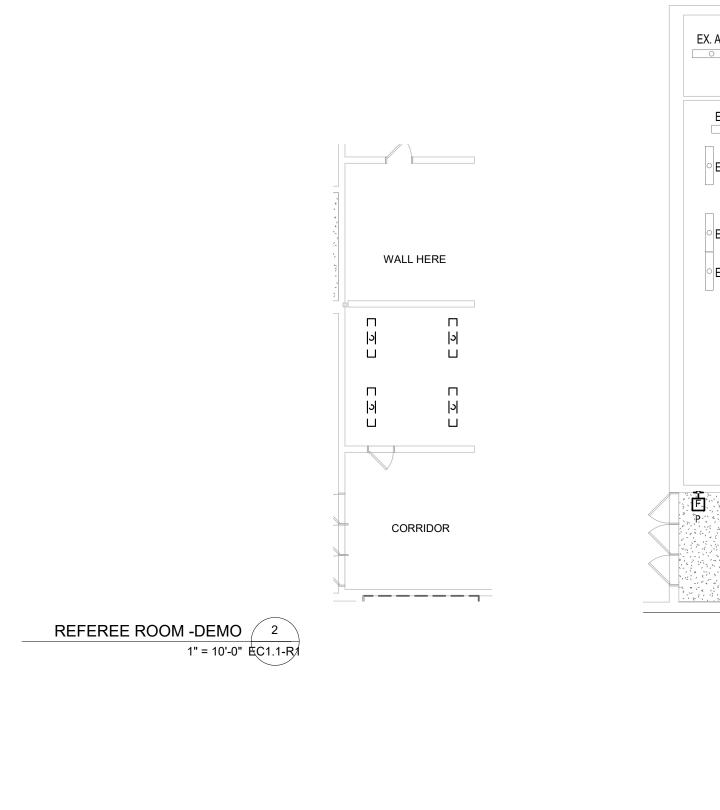

KEY NOTES

- EXISTING PANELS C AND D ON UPPER LEVEL. REMOVE PANELS AND REPLACE WITH JUNCTION BOXES. RELOCATE PANELS TO LOWER LEVEL AS SHOWN ON RENOVATION PLAN.
- EXISTING PANEL ON LOWER LEVEL. 600/480V TRANSFORMER TO BE REPLACED. SECONDARY 3 OUTPUT BELOW RATED DUE TO DEGRADED WINDING INSULATION.
- DEMOLISH REMOTE HEAD. EXTEND RACEWAY AND WIRES TO SUIT EMERGENCY LIGHTING RENOVATION LAYOUT.
- CANUCK LOCKER ROOM BRANCH PANEL. REMOVE "EXIT STYLE" EXIT SIGN AND REPLACE WITH RUNNING MAN EXIT SIGN.



Rev. No. Date

Revision Notes


- 0 19-11-06 Issued for Construction
- 1 19-12-09 Issued with ADD1ME



Certificate of Authorization

Epp Siepman Engineering Inc. No. 4035

This is a print of a document that has been electronically authenticated with technology authorized by the APEGM. The original is in electronic form.

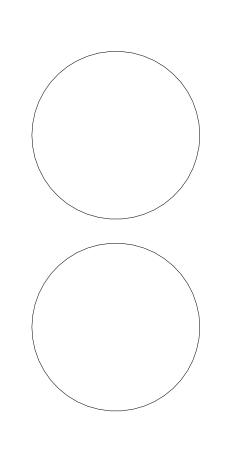

This drawing must not be scaled. The contractors shall verify all dimensions and other data on site prior to commencement of work. Discrepancies, errors, and omissions are to be reported to Public City Architecture Inc. prior to proceeding with the Work.

Drawings and specifications as instruments of service are the property of Public City Architecture Inc.; the copyright in the same being reserved.

No reproduction or revision to these drawings may be made without the permission of Public City Architecture Inc., and when made, must bear their name. All prints to be returned to Public City Architecture Inc. upon request.

Project ST. JAMES CIVIC CENTRE

Drawing

ARENA ELECTRICAL PLAN -DEMOLITION

Sheet.	EC1.1-R
Sheet [.]	
Date:	11/06/19
As indicated	1176-2019
Scale:	Tender No:
JA	MP
Drawn By:	Review By: