KEY NOTES

- NEW HWS AND HWR PIPING FROM NEW BOILER ROOM TO DISTRIBUTE WITHIN BASEMENT. CONNECT TO ALL WALL FIN AND RISERS FROM MAIN FLOOR.
- ALL CONTROL VALVING TO MAIN FLOOR WALL FINS AND RADIANT PANELS TO BE LOCATED IN BASEMENT CEILING SPACE FOR ACCESSIBILITY.
- EXISTING POOL HEAT EXCHANGER WITHIN POOL WATER TREATMENT
- NEW HEATING SUPPLY AND RETURN RISERS DOWN FROM ABOVE. TIE INTO EXISTING PIPING SERVING EXISTING POOL HEAT EXCHANGER.

Public City Architecture Inc 11-600 Clifton Street Winnipeg, Manitoba

R3G 2X6 204 475 9323

publiccityarchitecture.com


Revision Notes

0 19-11-06 Issued for Construction 1 19-12-09 Issued with ADD1ME



Certificate of Authorization Epp Siepman Engineering Inc.

This is a print of a document that has been electronically authenticated with technology authorized by the APEGM. The original is in electronic form.

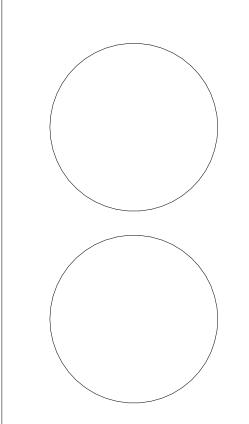

This drawing must not be scaled. The contractors shall verify all dimensions and other data on site prior to commencement of work. Discrepancies, errors, and omissions are to be reported to Public City Architecture Inc. prior to proceeding with the Work.

Drawings and specifications as instruments of service are the property of Public City Architecture Inc.; the copyright in the same being reserved. No reproduction or revision to these drawings may be made without the permission of Public City Architecture Inc., and when made, must bear their name. All prints to be returned to Public City Architecture Inc. upon request.

ST. JAMES CIVIC CENTRE

Sheet:

BASEMENT RENOVATION -HYDRONIC PLAN

Drawn By: Review By: EB JS Tender No: Scale: 3/32" = 1'-0" 1176-2019 11/06/19 Date:

MY2.3-R1

