

LEVEL 1 - HYDRONIC RENOVATION 1
3/32" = 1'-0" MY2.4-R1

PUBLICCIT

Public City Architecture Inc 11-600 Clifton Street Winnipeg, Manitoba R3G 2X6 204 475 9323 publiccityarchitecture.com

Rev. No. Date Revision Notes

0 19-11-06 Issued for Construction 3 19-12-20 Issued with ADD3ME




Certificate of Authorization

Epp Siepman Engineering Inc.

This is a print of a document that has been electronically authenticated with technology authorized by the APEGM. The original is in electronic form.

No. 4035

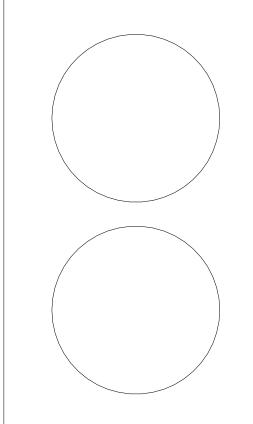

This drawing must not be scaled. The contractors shall verify all dimensions and other data on site prior to commencement of work. Discrepancies, errors, and omissions are to be reported to Public City Architecture Inc. prior to proceeding with the Work.

Drawings and specifications as instruments of service are the property of Public City Architecture Inc.; the copyright in the same being reserved.

No reproduction or revision to these drawings may be made without the permission of Public City Architecture Inc., and when made, must bear their name. All prints to be returned to Public City

Architecture Inc. upon request.

Proiec

ST. JAMES CIVIC CENTRE

)rawing

Sheet:

LEVEL 1 RENOVATION HYDRONIC PLAN

 Drawn By:
 Review By:

 EB
 JS

 Scale:
 Tender No:

 3/32" = 1'-0"
 1176-2019

 Date:
 11/06/19

MY2.4-R1