

KEY NOTES

3/32" = 1'-0" MP2.5-R/

NEW DOMESTIC HOT WATER AND RECIRC PIPING TO SERVE ZAMBONI ROOM. ROUTE UP FROM BELOW WITHIN CHASE AND THROUGH WALL TO ARENA AT HIGH LEVEL. REFER TO BASEMENT AND LEVEL 1 PLAN FOR CONTINUATION.

ROUTE ZAMBONI HOT WATER PIPE AT HIGH LEVEL ABOVE BLEACHER

PROVIDE NEW ROOF DRAIN TO SUIT NEW ROOF. COORDINATE WITH ARCHITECTURAL.

NEW ZAMBONI HOT WATER AND RECIRCULATION PIPING TO ROUTE DOWN THROUGH BLEACHERS TO BELOW. COORDINATE CORING WITH

DOMESTIC HOT WATER AND RECIRC DOWN THROUGH FLOOR TO BELOW-REFER TO LEVEL 1 FOR CONTINUATION. EXISTING ROOF DRAINS TO REMAIN NEW GAS PIPING ON ROOF FROM EXISTING SERVICE. EXISTING SERVICE AND METER LOCATED AT GRADE ON EXTERIOR OF BUILDING.

ROUTE PIPING THROUGH EXTERIOR WALL INTO BOILER ROOM. ROUTE AND CONNECT TO NEW GAS FIRED EQUIPMENT.



Public City Architecture Inc 11-600 Clifton Street Winnipeg, Manitoba R3G 2X6 204 475 9323 publiccityarchitecture.com

> Rev. No. Date Revision Notes


0 19-11-06 Issued for Construction 5 20-01-06 Issued with ADD6M



Certificate of Authorization Epp Siepman Engineering Inc.

This is a print of a document that has been electronically authenticated with technology authorized by the APEGM. The original is in electronic form.

No. 4035

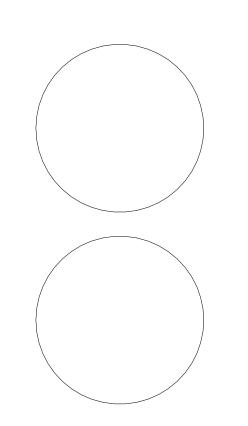

This drawing must not be scaled. The contractors shall verify all dimensions and other data on site prior to commencement of work. Discrepancies, errors, and omissions are to be reported to Public City Architecture Inc. prior to proceeding with the Work.

Drawings and specifications as instruments of service are the property of Public City Architecture Inc.; the copyright in the same being reserved.

No reproduction or revision to these drawings may be made without the permission of Public City Architecture Inc., and when made, must bear their name. All prints to be returned to Public City Architecture Inc. upon request.

ST. JAMES CIVIC CENTRE

LEVEL 2 RENOVATION -PLUMBING PLAN Drawn By: Review By:

Tender No: 3/32" = 1'-0" 1176-2019 11/06/19 Date:

MP2.5-R1