


APPENDIX D

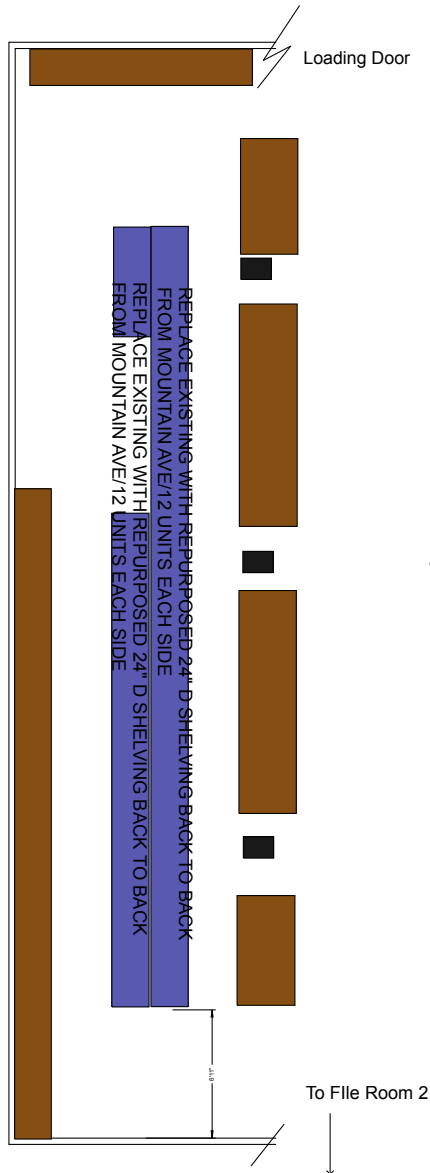

**REST OF SHELVING IN FILE ROOM 3
TO REMAIN EXISTING**

Notes: Additional 24 Surplus Shelving Units not
reinstalled in File room 3 to be taken to storage
area at 50 Myrtle Ave

50 MYRTLE FILE ROOM 3 REPURPOSED SHELVING LAYOUT NOT TO SCALE

DRAWING LEGEND

BROWN = EXISTING SHELVING TO REMAIN "AS IS"
BLUE = REPURPOSED BACK TO BACK 24"D SHELVING FROM MOUNTAIN AVE

ADDITIONAL NEW SHELVES TO BE PURCHASED
BLUE: One extra shelf per shelving unit



TITLE

OFFICE

REP

ALL DESIGNS REPRESENTED BY
DRAWING ARE CONFIDENTIAL AND
SHOULD NOT BE DISCLOSED
WITHOUT WRITTEN PERMISSION
FROM TAB.