



ENTRANCE TOWER PLAN

(NOTE: FOR DETAILS SEE DWG. E2.)

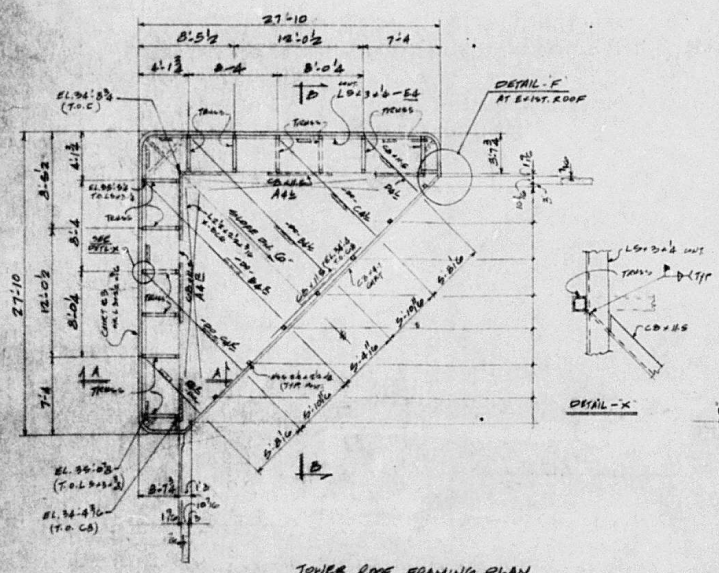

TOWER ROOF FRAMING PLAN

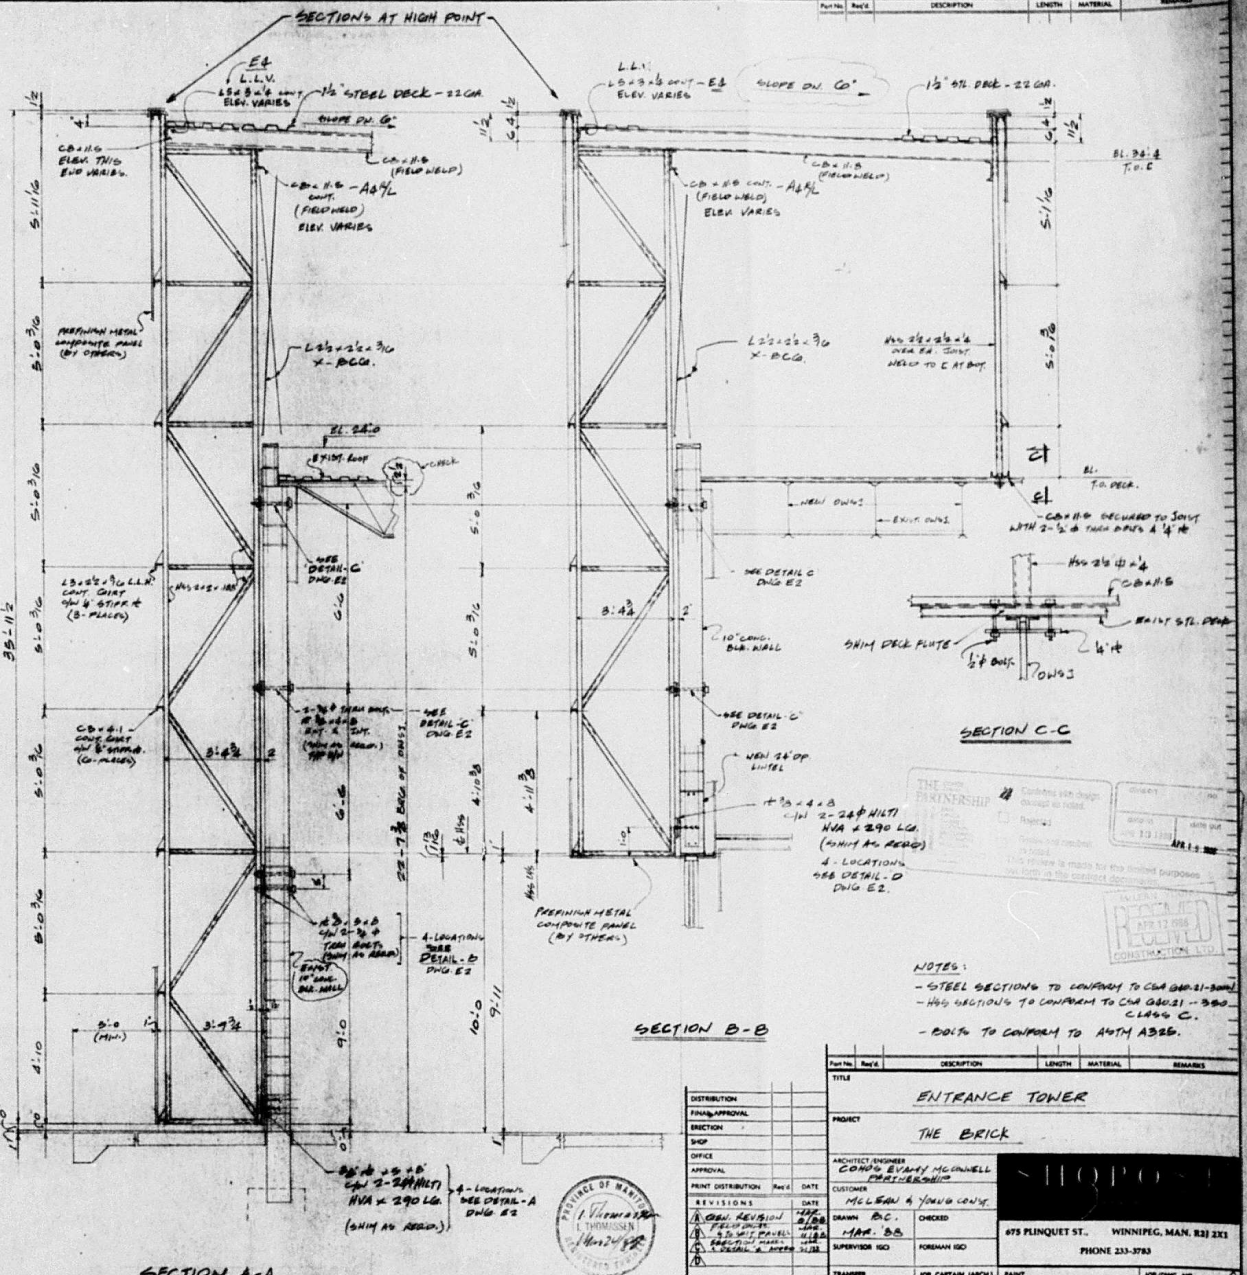


SECTION A-A

SECTION B-B

SECTION C-C

- NOTES:
  - HSS SECTIONS TO CONFORM TO CSA G40.21 - 300 CLASS C.
  - BOLTS TO CONFORM TO ASTM A325.

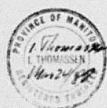

DISTRIBUTION	DATE	DESCRIPTION	LENGTH	MATERIAL	REMARKS
PRINT APPROVAL					
REVISIONS					
DATE					
BY					
FOR					
DATE					
BY					
FOR					
DATE					
BY					
FOR					

TITLE	DESCRIPTION	LENGTH	MATERIAL	REMARKS
ENTRANCE TOWER				
THE BRICK				
CHECKED				
SUPERVISOR ICD	FOREMAN ICD			
TRANSFER	JOB CAPTAIN (ARG)	PART		JOB/DWG. NO. B3014-E1

675 PLINQUET ST. WINNIPEG, MAN. R3J 2X1

PHONE 233-3783