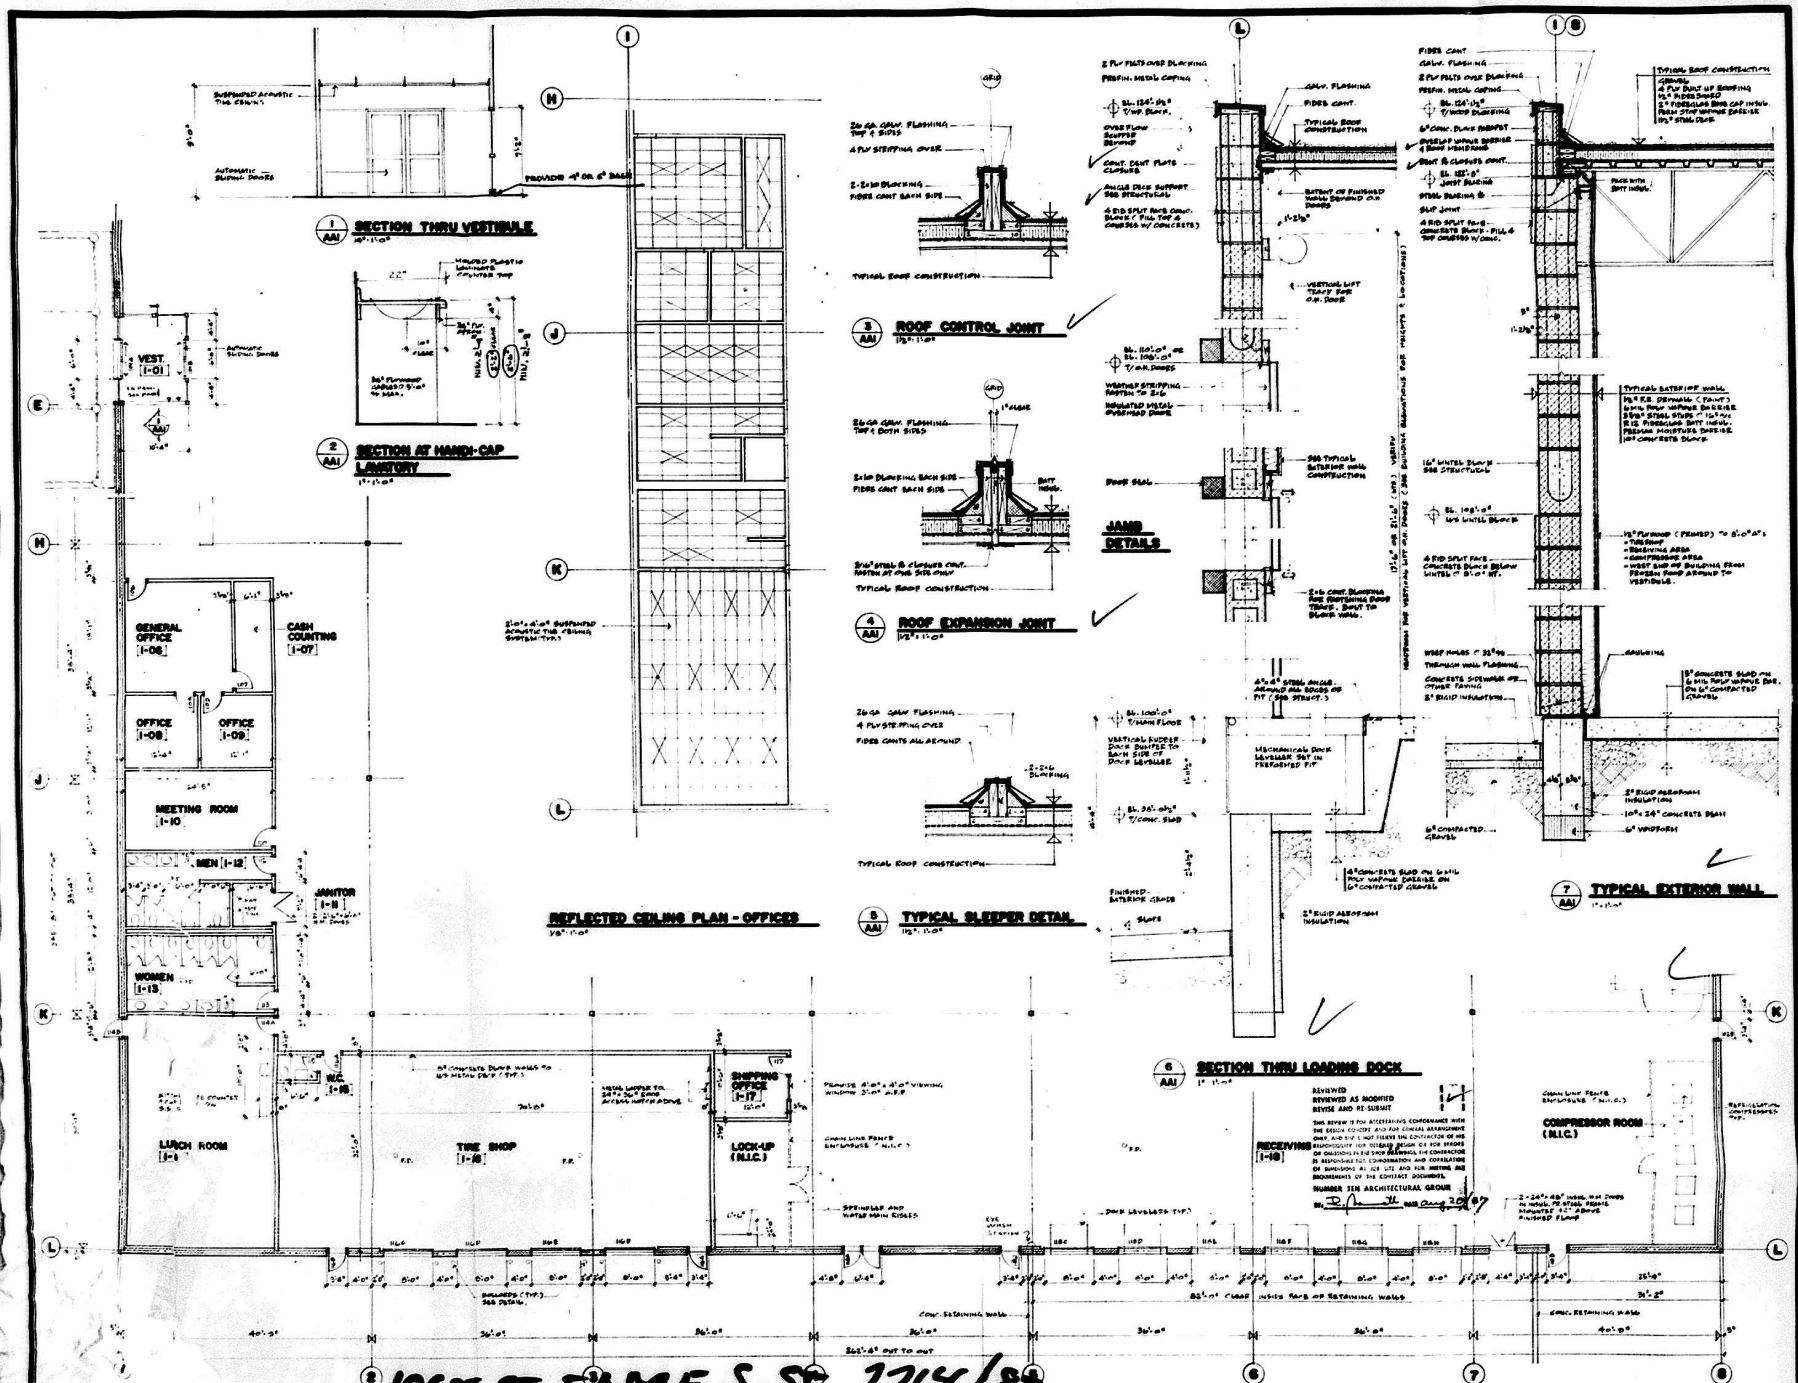

NOTES:
GENERAL CONTRACTOR SHALL VERIFY ALL DIMENSIONS, ELEVATIONS, DETAILS AND CONDITIONS, AND REPORT ANY DISCREPANCIES TO ARCHITECT


DRAWING TITLE
PARTIAL FLOOR PLAN & MISC. DETAILS

SCALE: NOTED
DATE: APRIL 1987
FILE NO.:
REVISIONS NO.
DRAWING NO.: AA1

RECEIVED AUG 10 1987