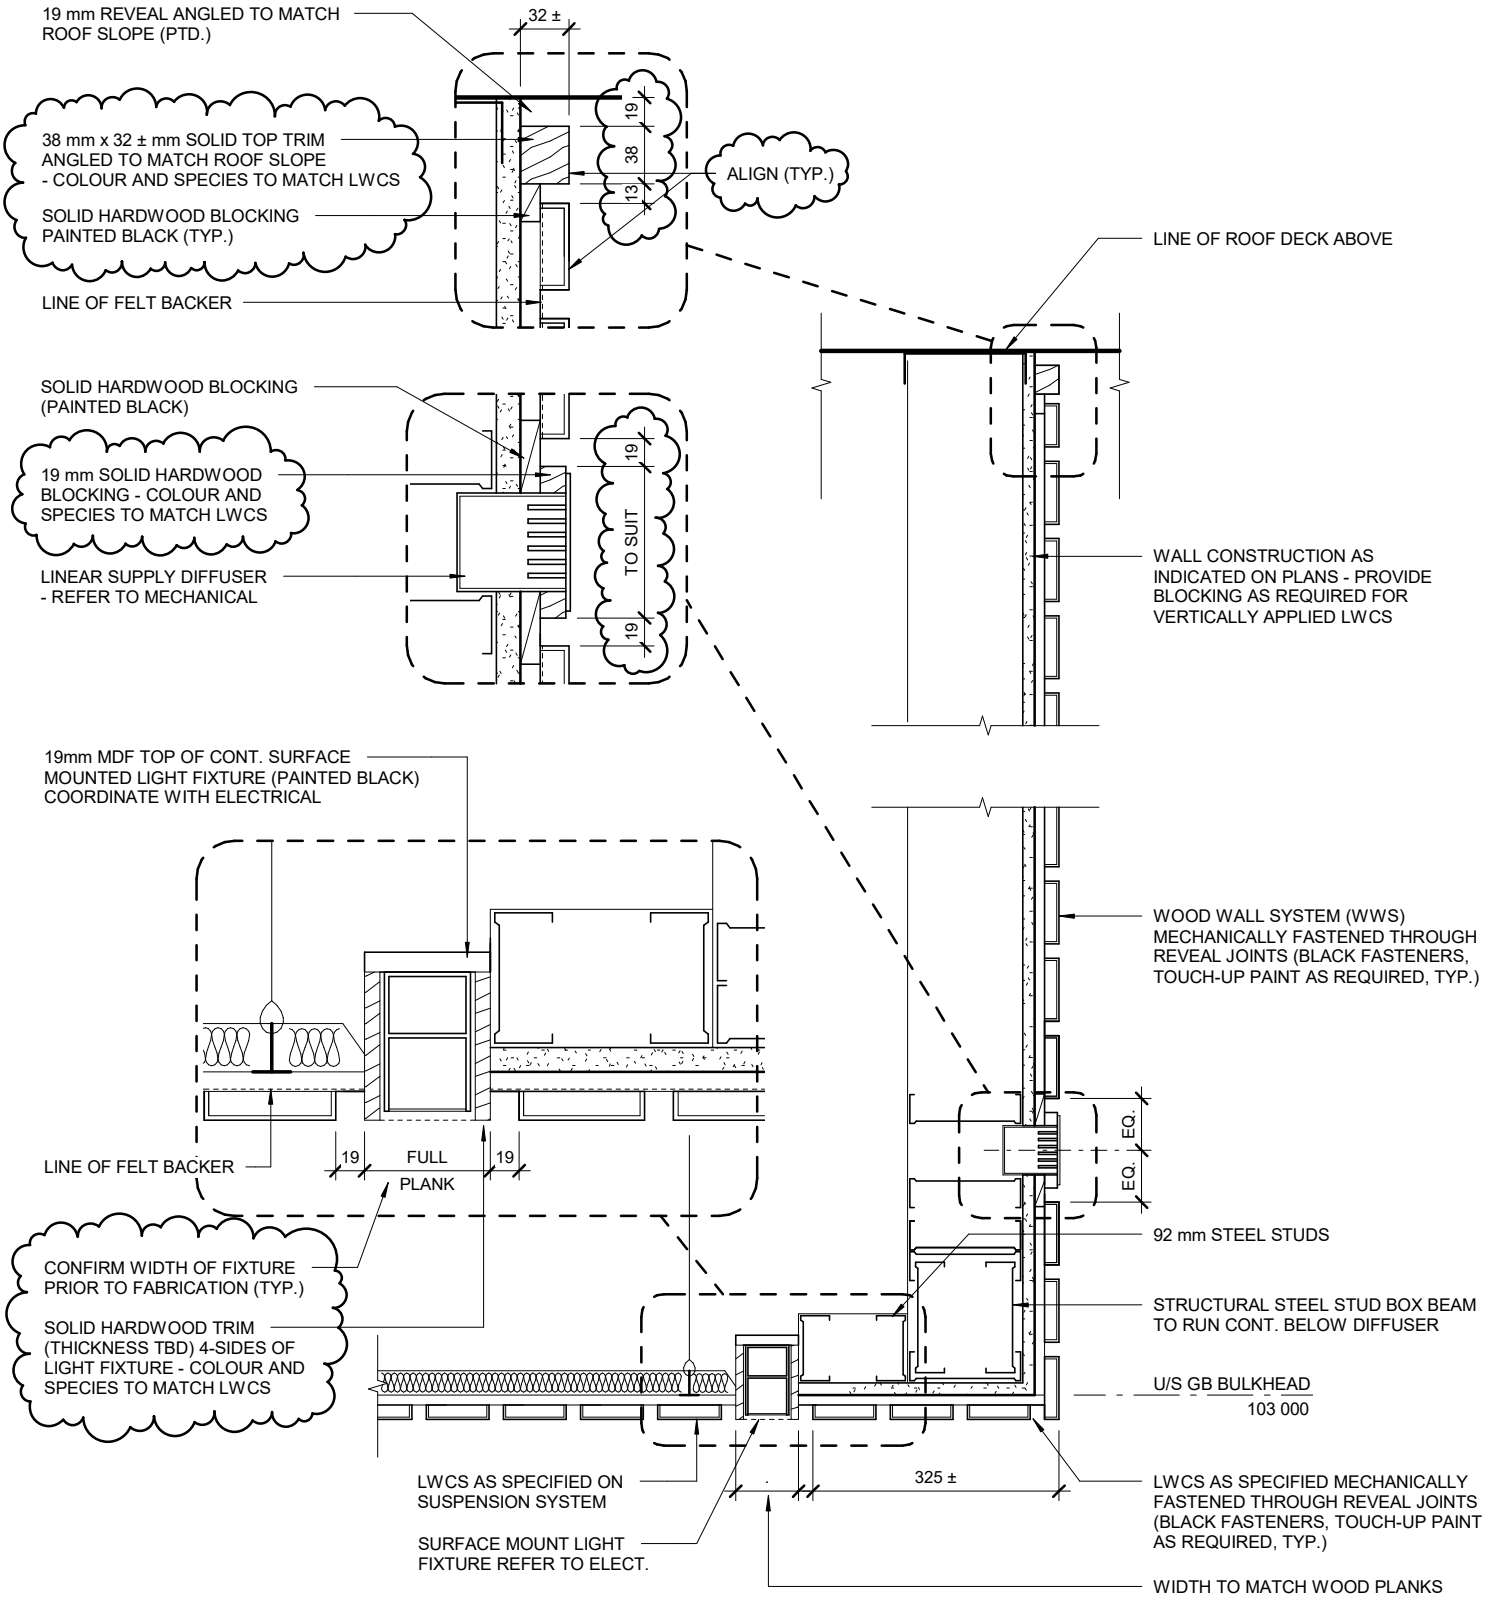

LWCS CEILING & FEATURE WALL

SCALE 1 : 10

LM Architectural Group
500-136 Market Ave
Winnipeg Manitoba
Canada R3B 0P4
t: (204) 942.0681
f: (204) 943.8676
www.lm-architects.com

PROJECT:

Bill and Helen Norrie Library

Project Address: 15 Poseidon Bay, Winnipeg, MB.

Refer to drawing:

DRAWN BY: DN DATE: 08.08.19

Addendum No. 01

AP8.16R1

COMM. NO.: 1847

Plotted on: 8/8/2019 4:11:20 PM C:\Users\H.WEST\Documents\1847_BHN Library_H.West.rvt