


B SIZE - 279mm x 432mm

DIGESTER 11 ROOF

FIELD

CP-D10 DIGESTER GALLERY PLC PANEL

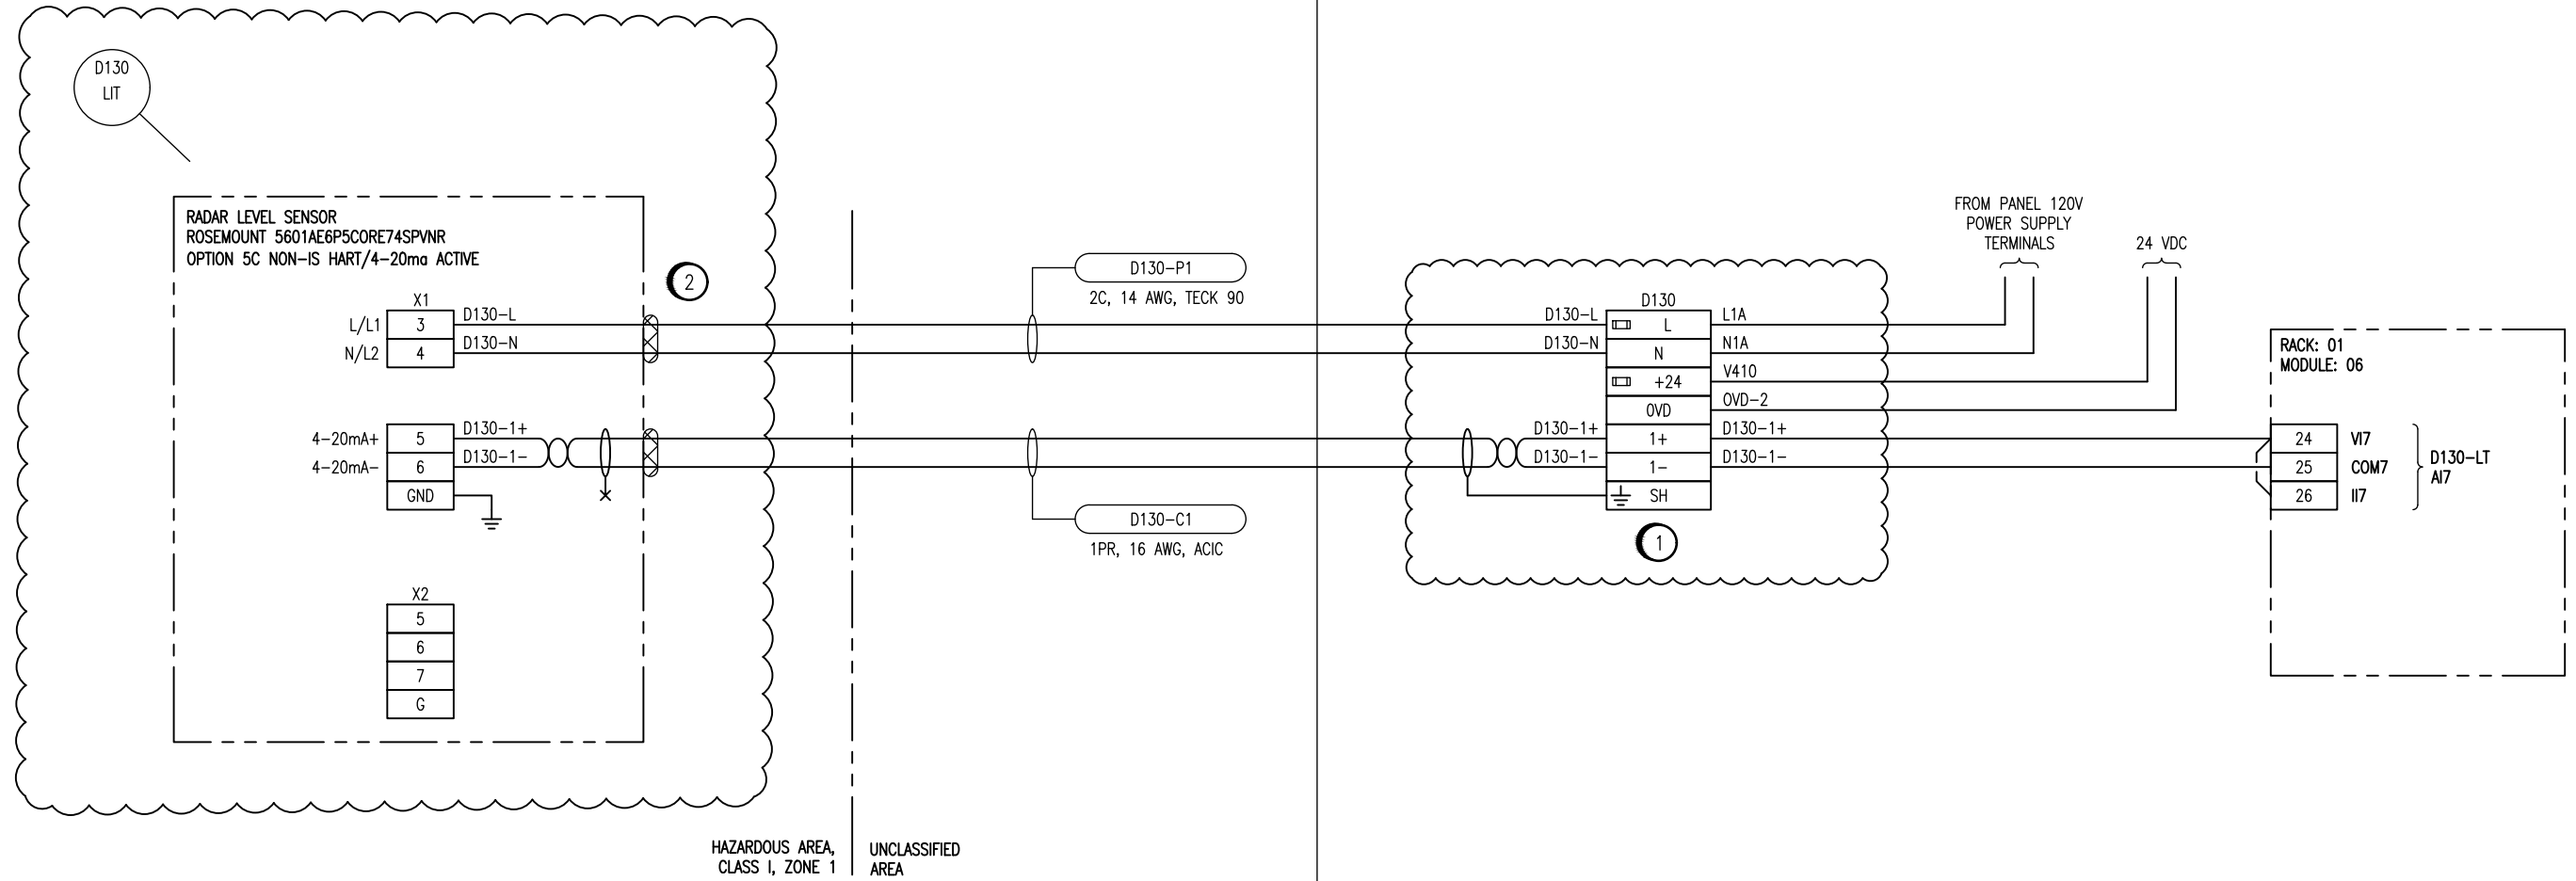

LEGEND

HAZARDOUS RATED SEAL

FUSE SCHEDULE	
D130-L	500 mA GMA

CONSTRUCTION NOTES:	
1	REVISE PANEL WIRING AS SHOWN.
2	INSTALL NEW ELECTRICAL CONNECTIONS AS REQUIRED FOR THE HAZARDOUS LOCATION INCLUDING CABLE SEALS.

SHEET 25 OF 44

- NOTES:
 1. THIS DRAWING SUPERSEDES SHOP DRAWING 14384C-D130.
 2. SEE 1-0101D-A0114-001 FOR LOCATION.



NO.	REVISIONS	DATE	DESIGN	CHECK
00	ISSUED FOR CONSTRUCTION	2019-08-01	CJR	CJR

DESIGNED BY: C. REIMER	CHECKED BY: C. REIMER
DRAWN BY: C. REIMER	APPROVED BY: C. REIMER
SCALE: NTS	DATE: 2019-05-17
ISSUED FOR CONSTRUCTION	
BY: K. SCHIMKE	DATE: 2019-08-01
BID OPPORTUNITY NO.: 630-2019	

ENGINEER'S SEAL

THE CITY OF WINNIPEG
WATER AND WASTE DEPARTMENT

NORTH END SEWAGE TREATMENT PLANT
DIGESTERS
LOOP DIAGRAM
D130-LIT
DIGESTER 11 FOAM LEVEL

CITY DRAWING NUMBER	SHEET	REV.	SIZE
1-0101D-A0116	001	00	B