


B SIZE - 279mm x 432mm

EAST GAS ROOM

FIELD

CP-D10 DIGESTER GALLERY PLC PANEL

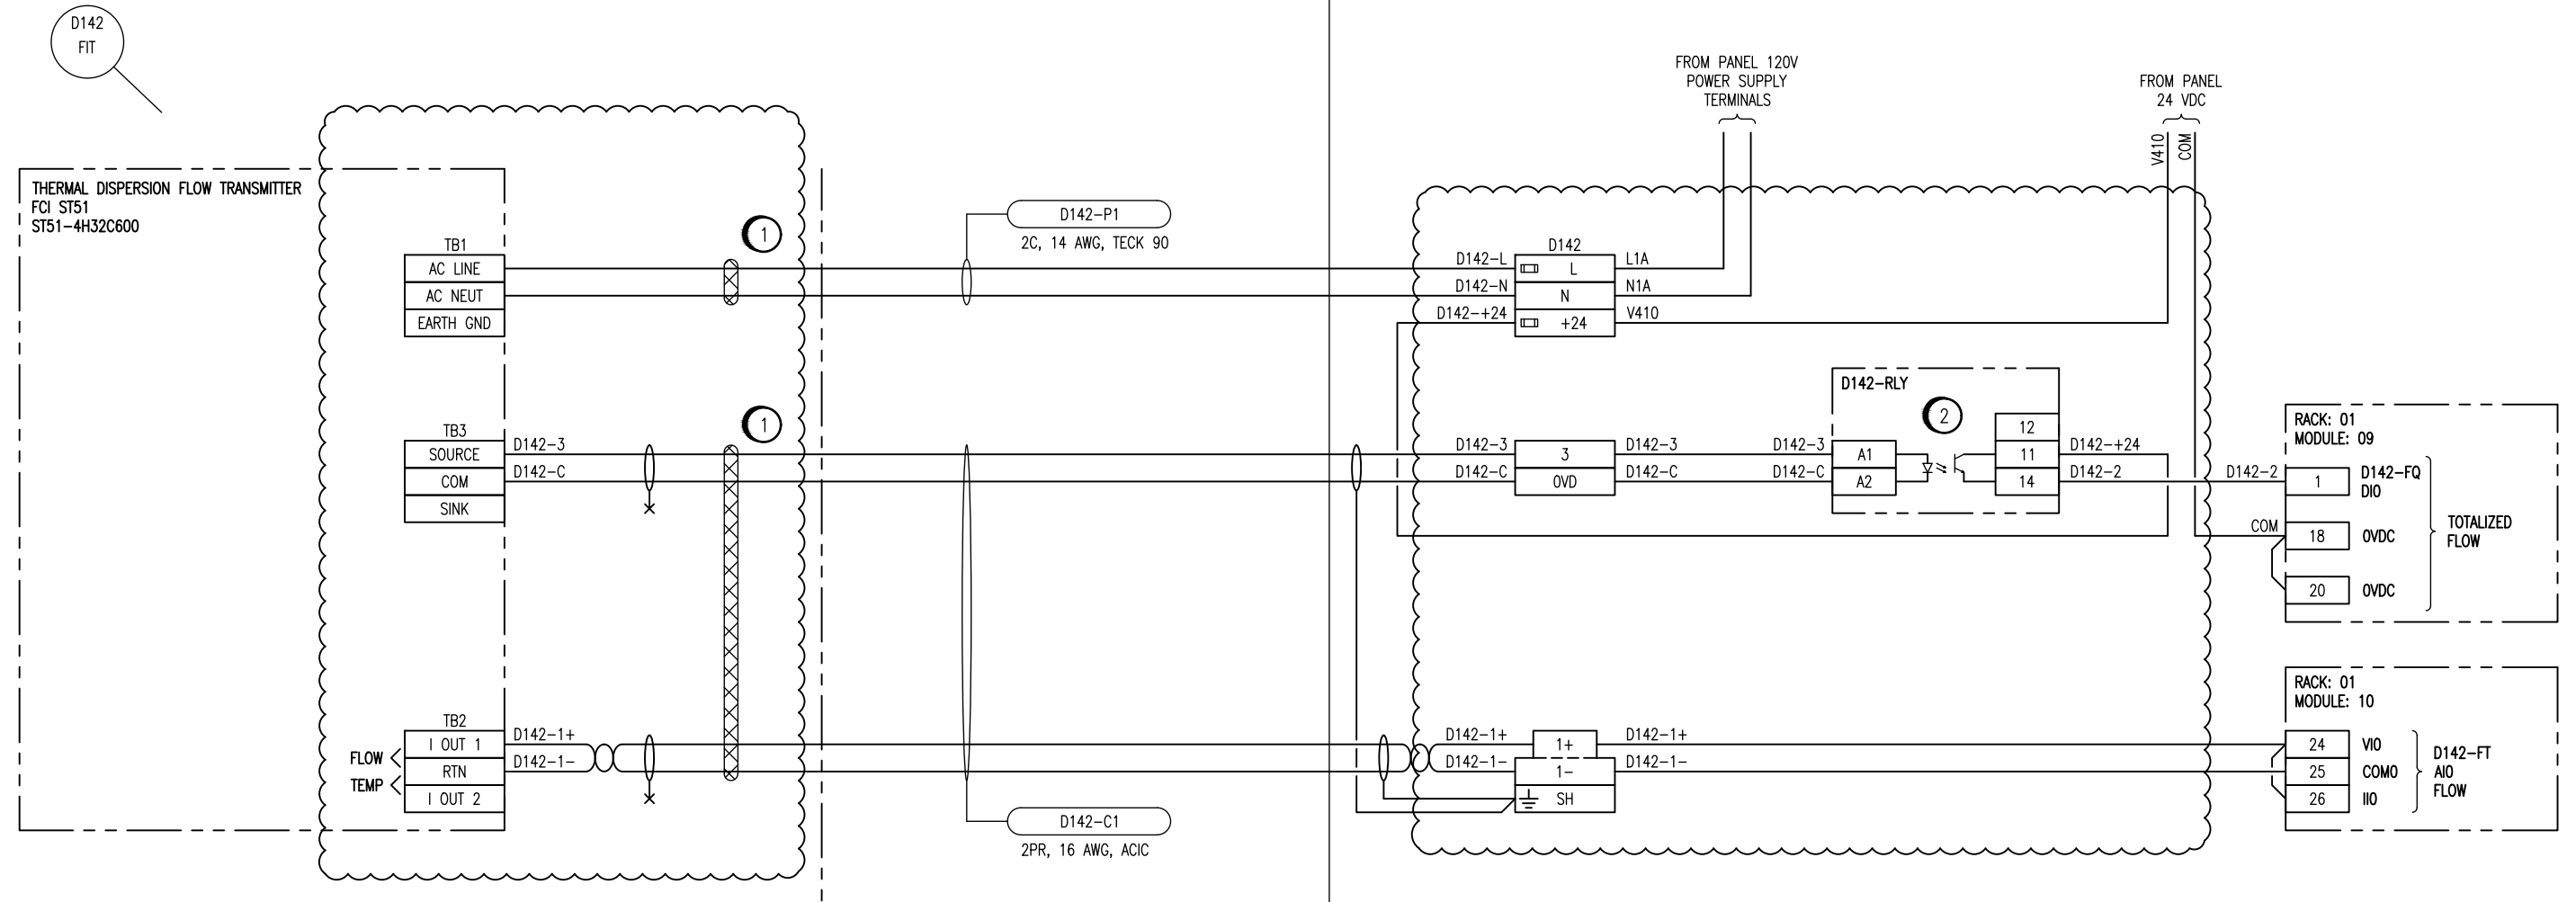

**LEGEND**

HAZARDOUS RATED SEAL

FUSE SCHEDULE	
D142-L	1A GMA
D142+24	500 mA GMA

HAZARDOUS AREA, CLASS I, ZONE 1  
UNCLASSIFIED AREA

- CONSTRUCTION NOTES:**
- ① INSTALL NEW ELECTRICAL CONNECTIONS AS REQUIRED FOR THE HAZARDOUS LOCATION INCLUDING HAZARDOUS RATED CABLE FITTINGS.
  - ② REPLACE EXISTING D142 RELAY WITH SOLID STATE RELAY AND REWIRE.

SHEET 26 OF 44

- NOTES:**
- THIS DRAWING SUPERSEDES SHOP DRAWING 14384C-D142.
  - SEE 1-0101D-A0113-002 FOR LOCATION.



ENGINEER'S SEAL

NO.	REVISIONS	DATE	DESIGN	CHECK
00	ISSUED FOR CONSTRUCTION	2019-08-01	CJR	CJR

DESIGNED BY: C. REIMER	CHECKED BY: C. REIMER
DRAWN BY: S. FUNK	APPROVED BY: C. REIMER
SCALE: NTS	DATE: 2019-05-19
ISSUED FOR CONSTRUCTION	
BY: K. SCHIMKE	DATE: 2019-08-01
BID OPPORTUNITY NO.: 630-2019	

**THE CITY OF WINNIPEG**  
WATER AND WASTE DEPARTMENT

NORTH END SEWAGE TREATMENT PLANT  
DIGESTERS  
LOOP DIAGRAM  
D142-FIT  
DIGESTER 11 GAS FLOW

CITY DRAWING NUMBER	SHEET	REV.	SIZE
1-0101D-A0117	001	00	B