


B SIZE - 279mm x 432mm

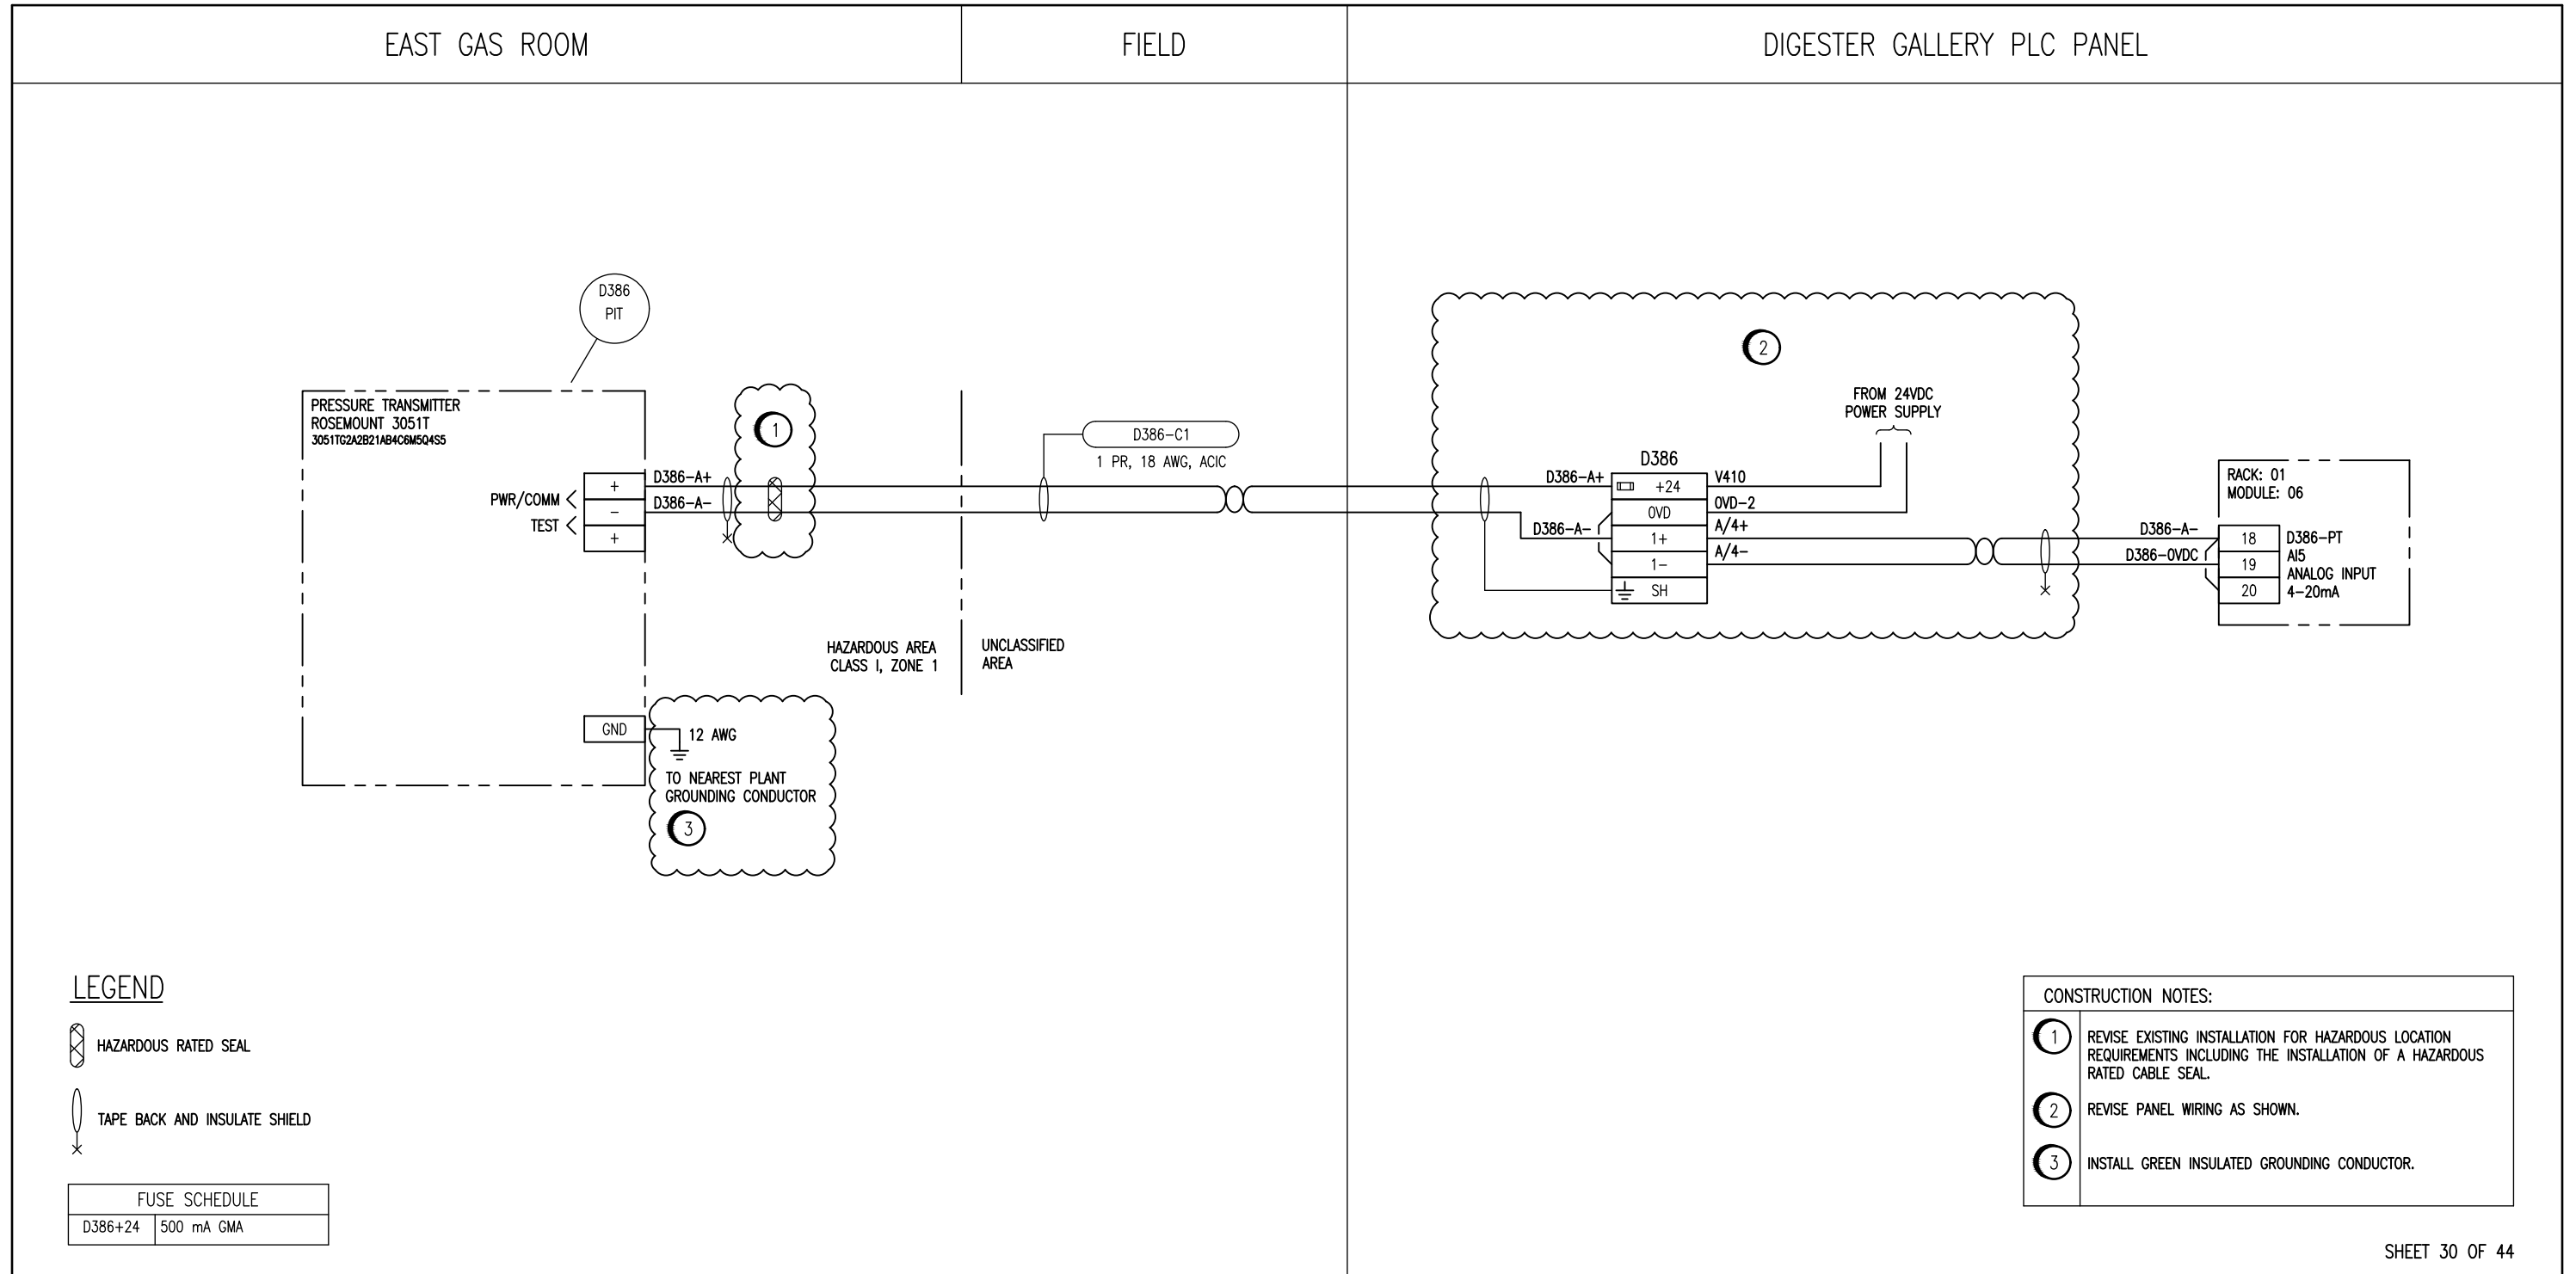

LEGEND

- HAZARDOUS RATED SEAL
- TAPE BACK AND INSULATE SHIELD

FUSE SCHEDULE	
D386+24	500 mA GMA

CONSTRUCTION NOTES:	
1	REVISE EXISTING INSTALLATION FOR HAZARDOUS LOCATION REQUIREMENTS INCLUDING THE INSTALLATION OF A HAZARDOUS RATED CABLE SEAL.
2	REVISE PANEL WIRING AS SHOWN.
3	INSTALL GREEN INSULATED GROUNDING CONDUCTOR.

SHEET 30 OF 44

- NOTES:
- THIS DRAWING SUPERSEDES SHOP DRAWING 14384C-D386.
 - SEE DRAWING 1-0101D-A0113-002 FOR LOCATION.



NO.	REVISIONS	DATE	DESIGN	CHECK
00	ISSUED FOR CONSTRUCTION	2019-08-01	CJR	CJR

DESIGNED BY: C. REIMER	CHECKED BY: C. REIMER
DRAWN BY: S. FUNK	APPROVED BY: C. REIMER
SCALE: NTS	DATE: 2019-05-17
ISSUED FOR CONSTRUCTION	
BY: K. SCHIMKE	DATE: 2019-08-01
BID OPPORTUNITY NO.: 630-2019	

ENGINEER'S SEAL

THE CITY OF WINNIPEG
WATER AND WASTE DEPARTMENT

NORTH END SEWAGE TREATMENT PLANT
DIGESTERS
LOOP DIAGRAM
D386-PIT
MIXING PUMP DISCHARGE PRESSURE

CITY DRAWING NUMBER	SHEET	REV.	SIZE
1-0101D-A0121	001	00	B