



FILE NAME: DWG\_699-2019\_DRAWING\_S01 DATE: 19.06.19 PROJECT No: 19-0107-007 SHEET TITLE: STRUCTURAL - PARTIAL ROOF PLAN ADDRESS: 1215 ARCHIBALD STREET

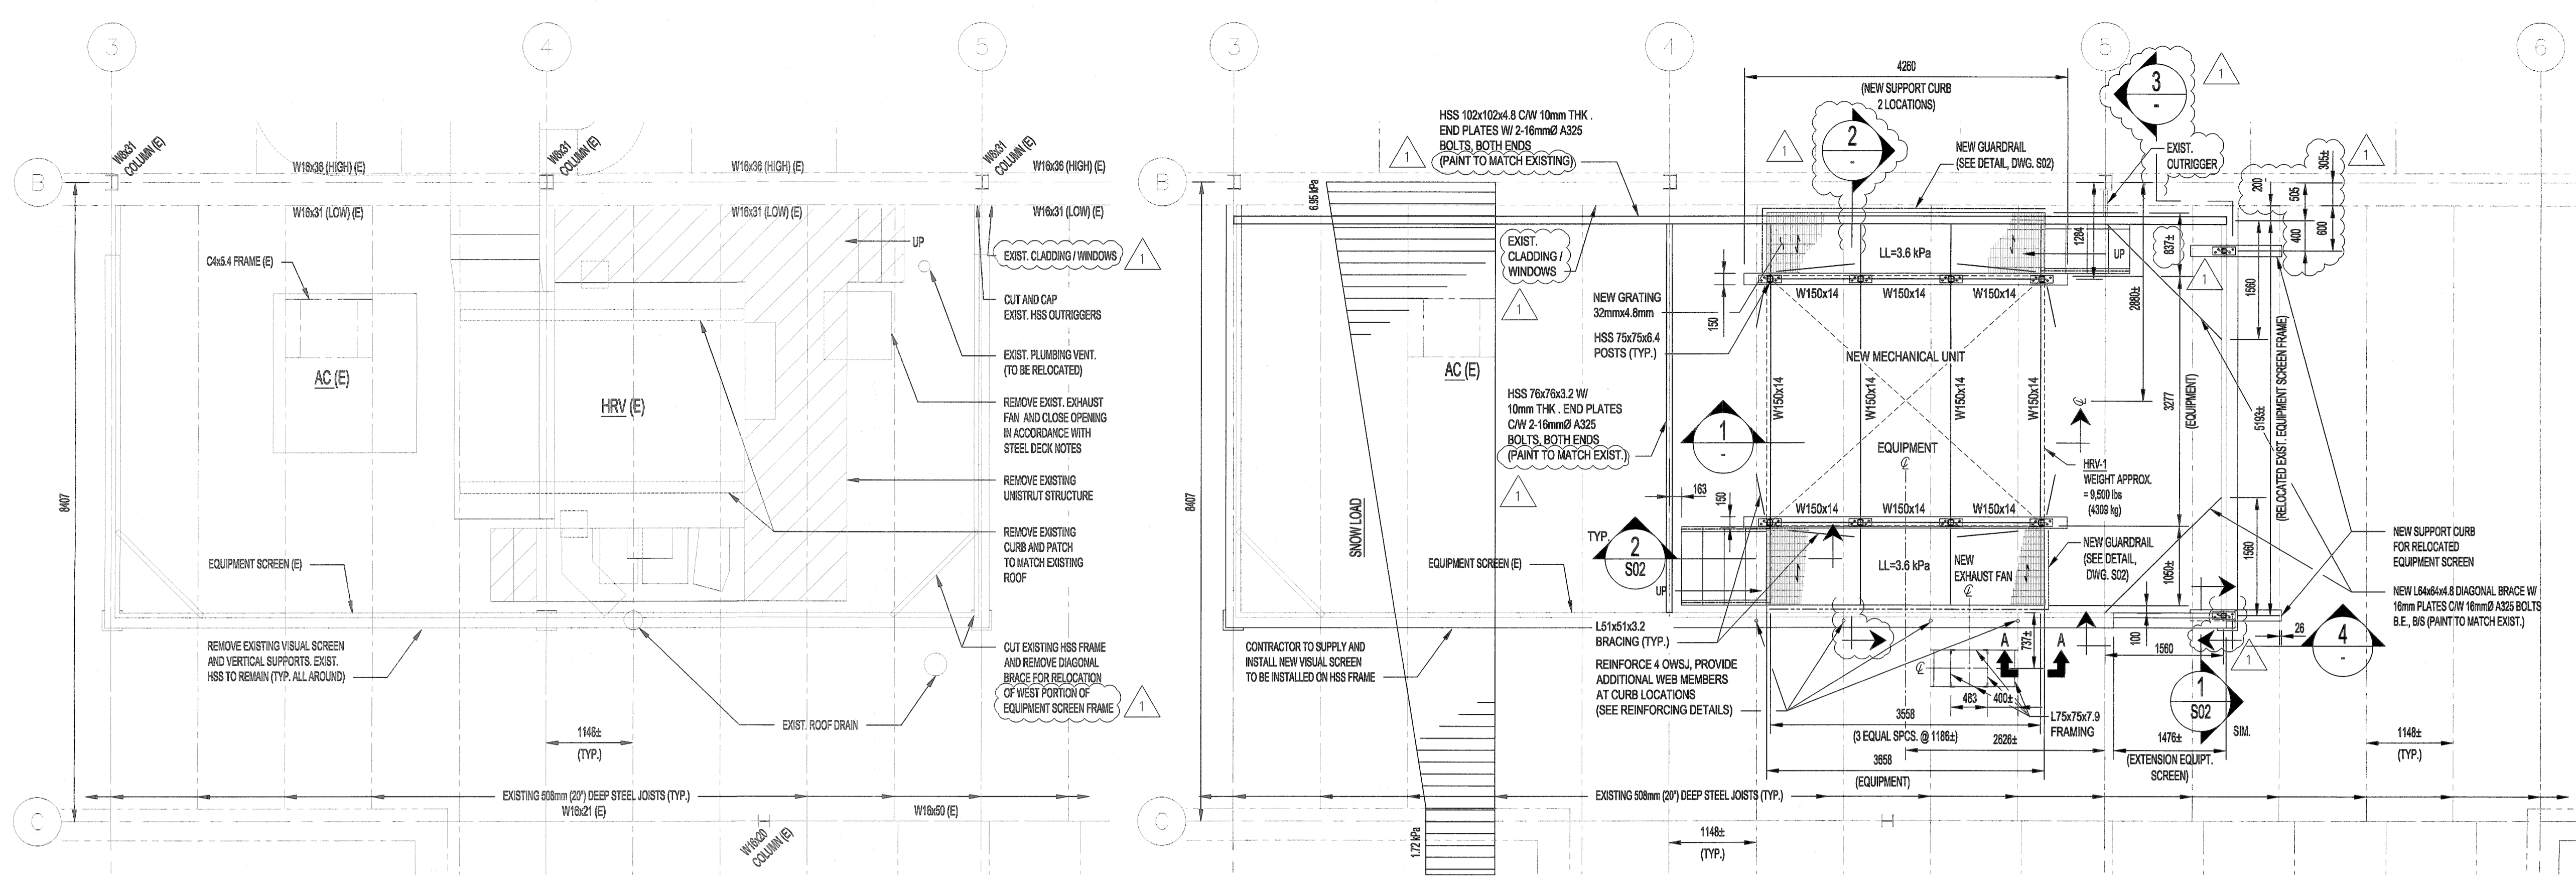


**PARTIAL ROOF PLAN - EXISTING**  
SCALE: 1:50

**PARTIAL ROOF PLAN - NEW**  
SCALE: 1:50  
DL = 2.87 kPa  
SL = AS SHOWN IN PLAN

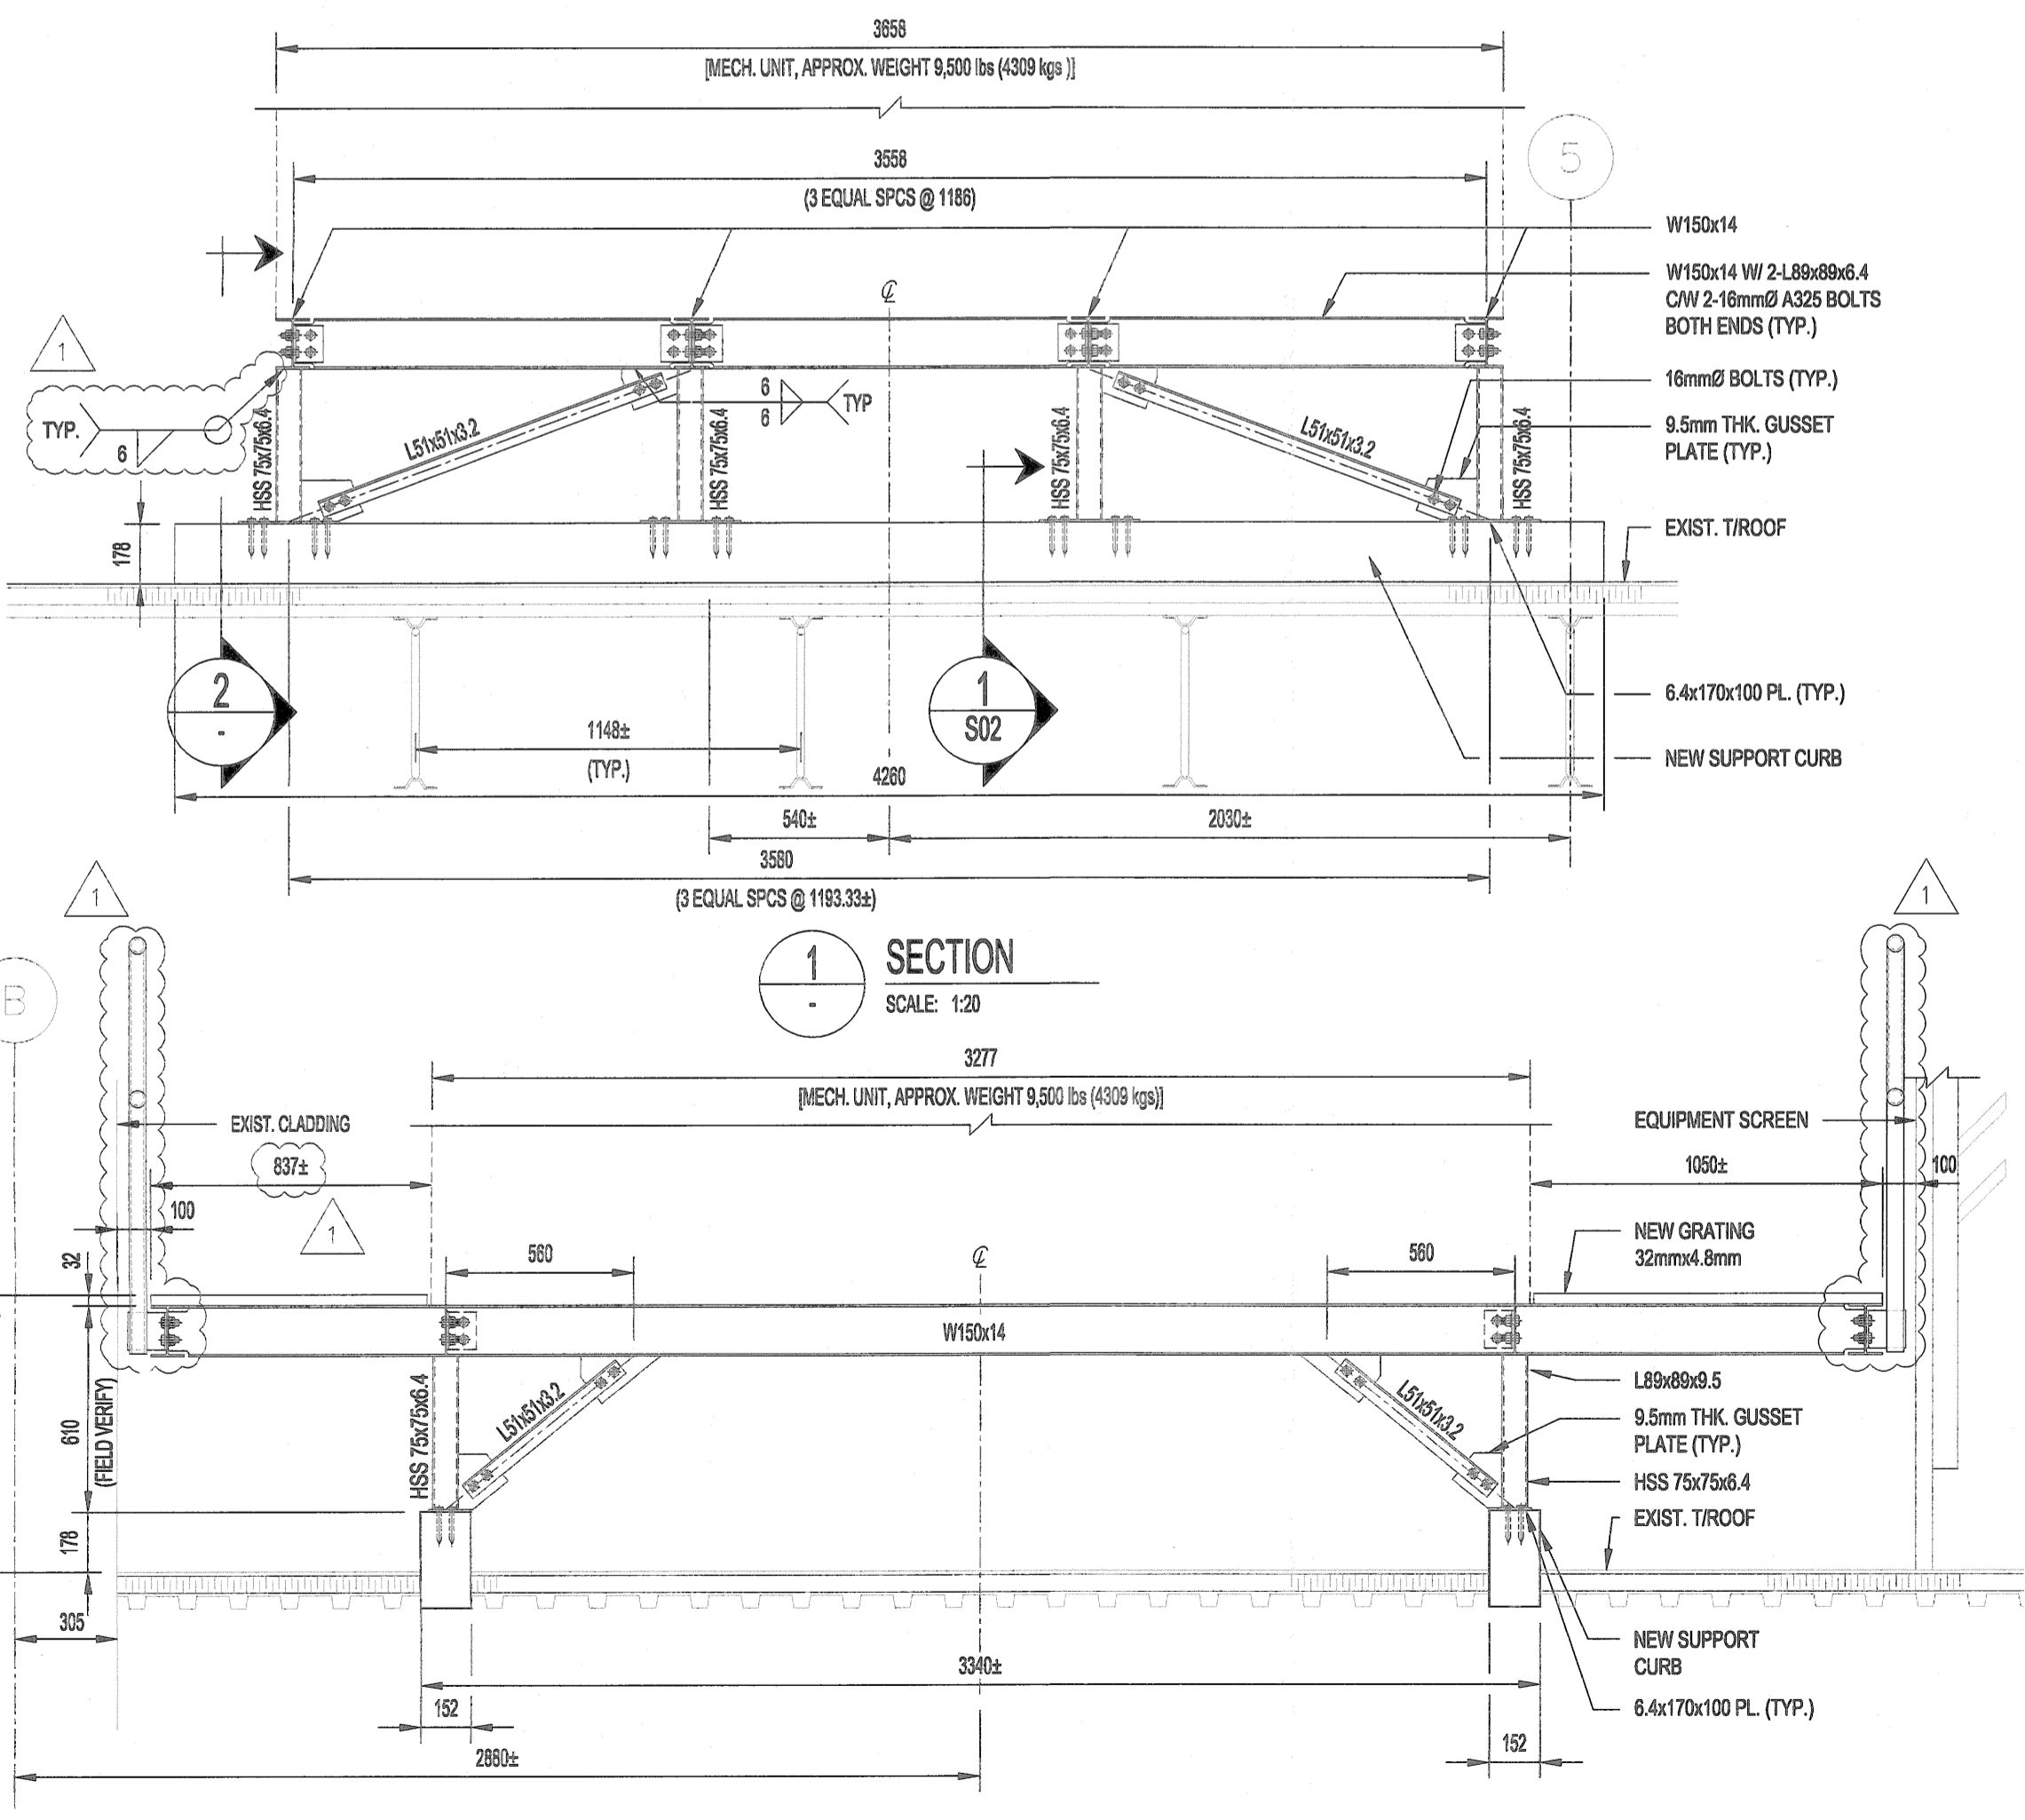


**SECTION 1**  
SCALE: 1:20

**SECTION 2**  
SCALE: 1:20



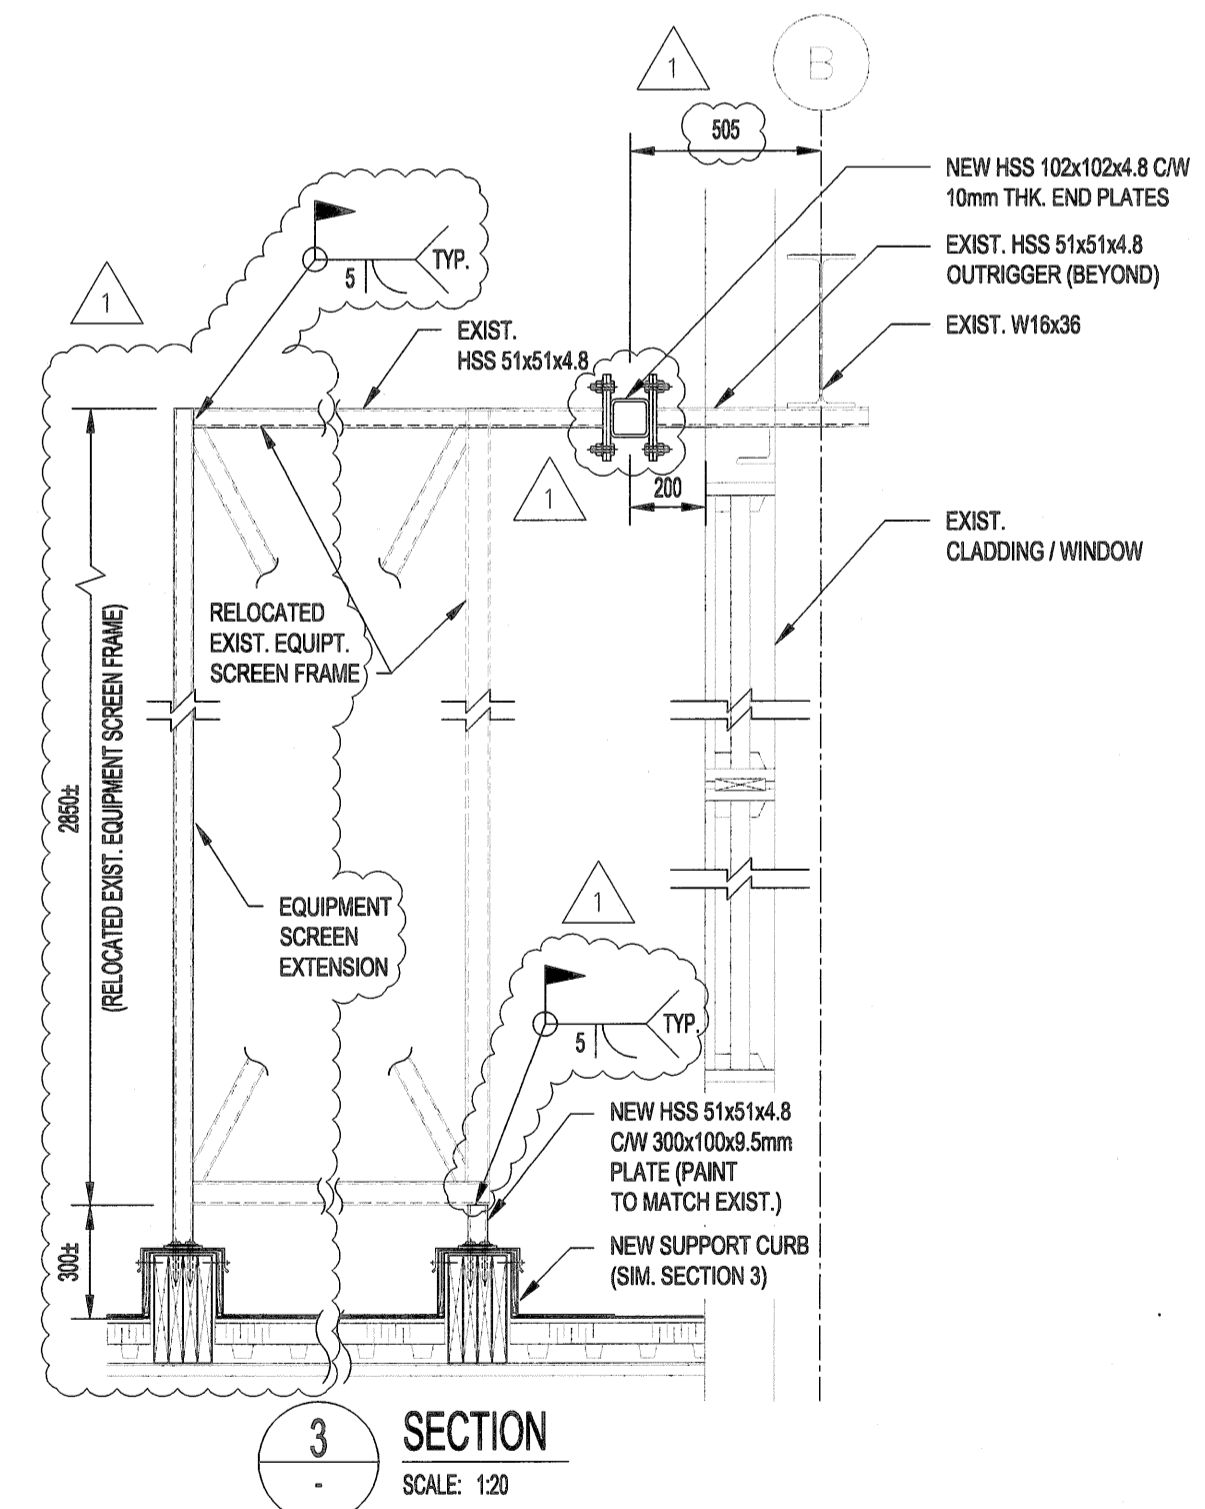


**SECTION 3**  
SCALE: 1:20

**SECTION A-A**  
SCALE: 1:10

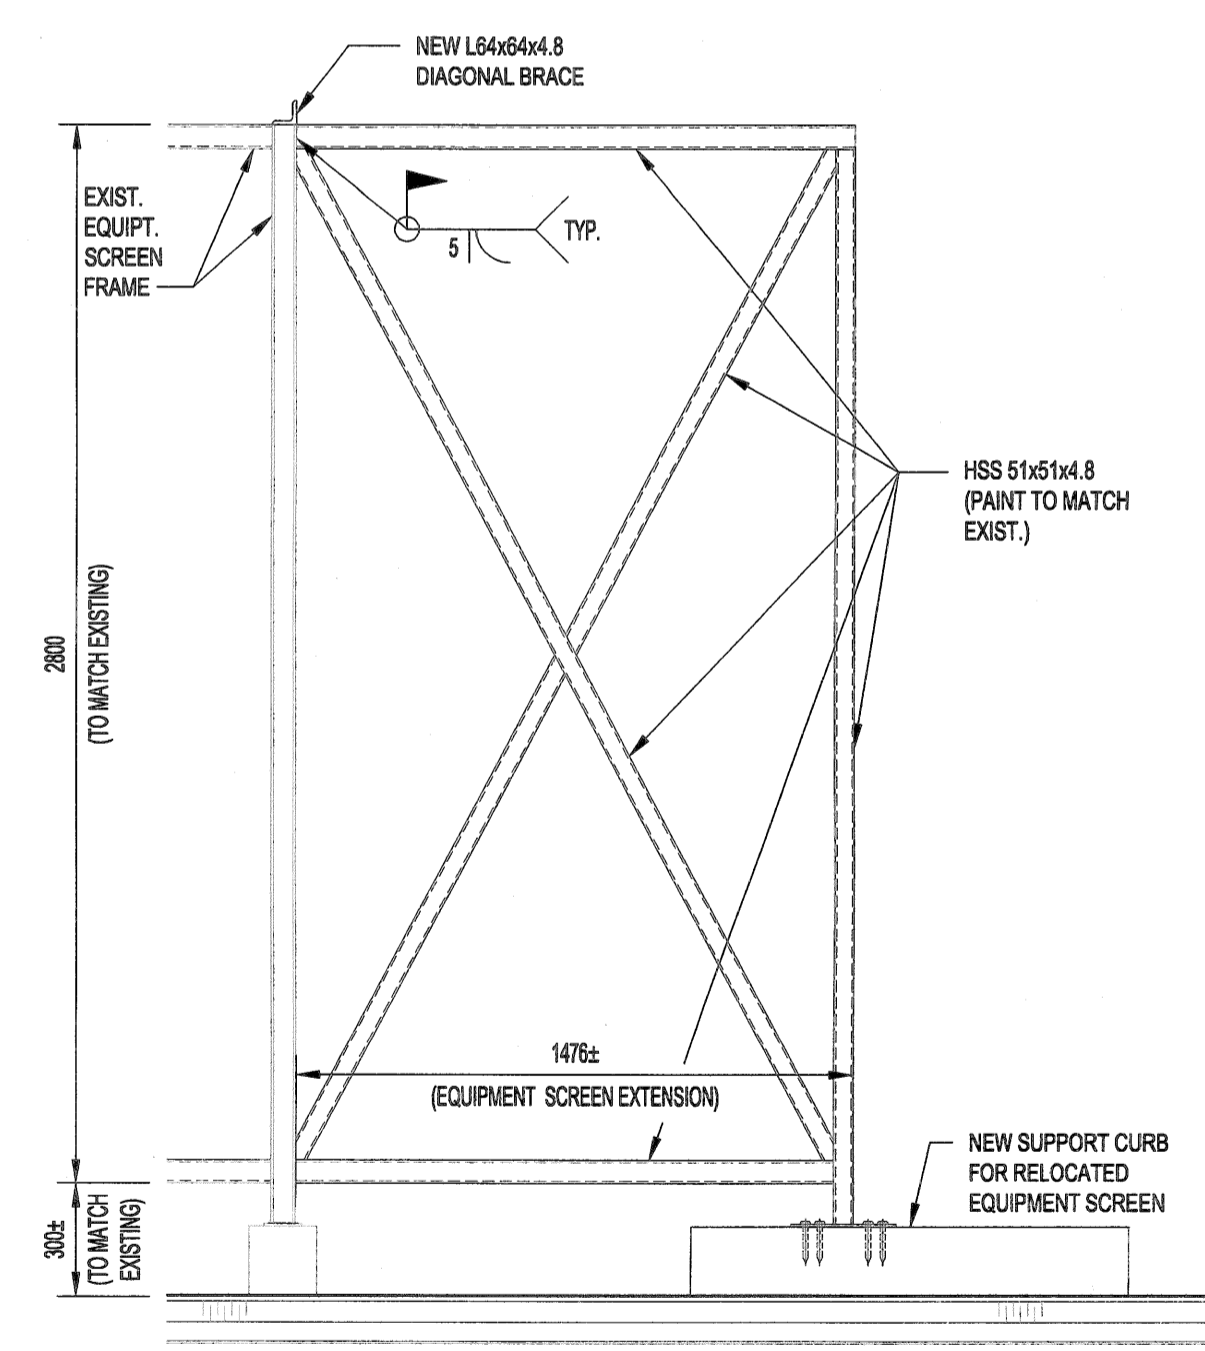

**SECTION 4**  
SCALE: 1:20

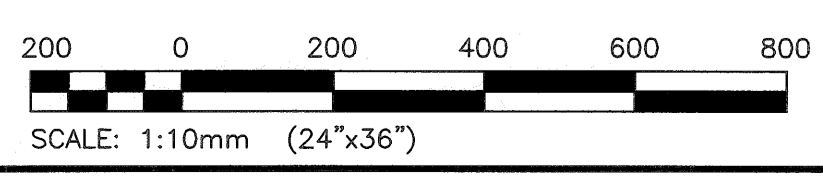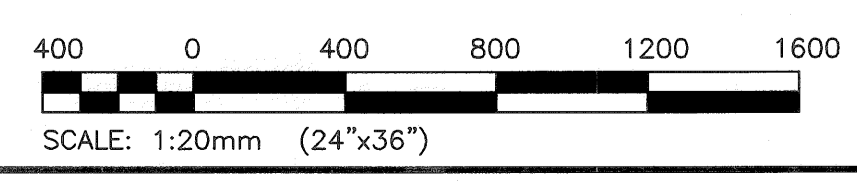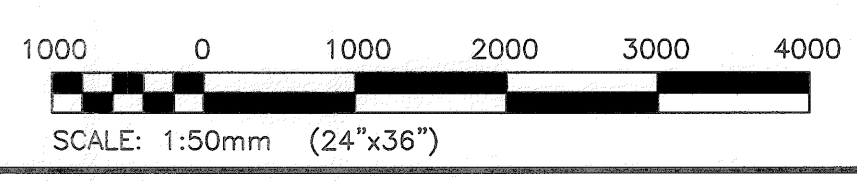

**ENGINEERS GEOSCIENTISTS MANITOBA**  
Certificate of Authorization  
KGS Group  
No. 245

**KGS GROUP**  
CONSULTING ENGINEERS

**NOTES:**  
THESE DRAWINGS SHALL NOT BE SCALED.  
THE CONTRACTOR SHALL VISIT THE SITE AND SATISFY ONESELF ALL DIMENSIONS, DATUM, AND DETAILED INFORMATION SHOWN ARE CORRECT.  
THE CONTRACTOR IS TO REVIEW AND COORDINATE ALL ARCHITECTURAL, MECHANICAL, ELECTRICAL AND STRUCTURAL DRAWINGS FOR ADDITIONAL OPENINGS THROUGH WALLS, AND CEILINGS FOR DUCT, PIPE & ELECTRICAL RISERS AND ALL OPENINGS NOT SHOWN ON DRAWINGS.  
ALL OPENINGS THROUGH THE FIRE SEPARATIONS AS A RESULT OF THE WORK OF THIS CONTRACT ARE TO BE FIRE STOPPED AND SEALED WITH ULC APPROVED FIRE STOPPING TO MAINTAIN THE INTEGRITY OF THE FIRE SEPARATION, AND PROVIDE AND SMOKE-TIGHT BARRIER.  
ALL PRODUCTS AND MATERIALS TO BE USED AND INSTALLED SHALL CONFORM WITH MANUFACTURER'S SPECIFICATIONS & APPLICABLE CODES.  
THE CONTRACTOR SHALL BE RESPONSIBLE TO PATCH AND MAKE GOOD ALL EXISTING CONSTRUCTION AFFECTED BY THE REMOVAL OF ALL ITEMS FORMING THE PART OF THE RENOVATION WORK.  
WHERE NEW FLOORING AND BASE IS TO BE INSTALLED IN EXISTING AREAS (REFER TO FLOOR PLAN AND ROOM SCHEDULE) THE EXISTING FLOORING SURFACE AND BASE MUST BE REMOVED, UNLESS OTHERWISE NOTED. ALL FLOOR SURFACES SHALL BE PREPARED IN ACCORDANCE TO MANUFACTURER'S RECOMMENDATIONS FOR INSTALLATION OF NEW FLOOR.  
WHERE PAINTING OF EXISTING WALLS IS INDICATED ON THE ROOM SCHEDULE, THESE WALLS MUST BE CLEANED OF ANY EXISTING WALL COVERING, PATCHED & PREPARED TO ACCEPT NEW MATERIAL, UNLESS OTHERWISE NOTED.

**LEGEND:**  
(E) EXISTING

| No. | REVISION/DESCRIPTION | BY   | DATE     |
|-----|----------------------|------|----------|
| 1   | RE-ISSUED FOR TENDER | J.P. | 19.08.12 |
| 0   | ISSUED FOR TENDER    | RC   | 19.08.15 |

| FBV           | RC       | MMF      | PS       |
|---------------|----------|----------|----------|
| DRWN          | CHECKED  | DESIGNED | APPROVED |
| DATE 19.07.25 | USER     |          |          |
|               | APPROVAL |          |          |

THE CITY OF WINNIPEG  
PLANNING, PROPERTY AND  
DEVELOPMENT DEPARTMENT  
MUNICIPAL ACCOMMODATIONS DIVISION  
3-65 GARRY STREET, R3C 4K4

**PROJECT**  
ROOFTOP HEAT RECOVERY  
VENTILATOR REPLACEMENT  
BONVITAL POOL  
1215 ARCHIBALD STREET

**SHEET TITLE**  
STRUCTURAL  
PARTIAL ROOF  
PLAN & SECTIONS

| SCALE    | PROJECT No: | SHEET No: |
|----------|-------------|-----------|
| AS SHOWN | 19-0107-007 | S01       |