


INSTRUMENT LOOP DIAGRAM

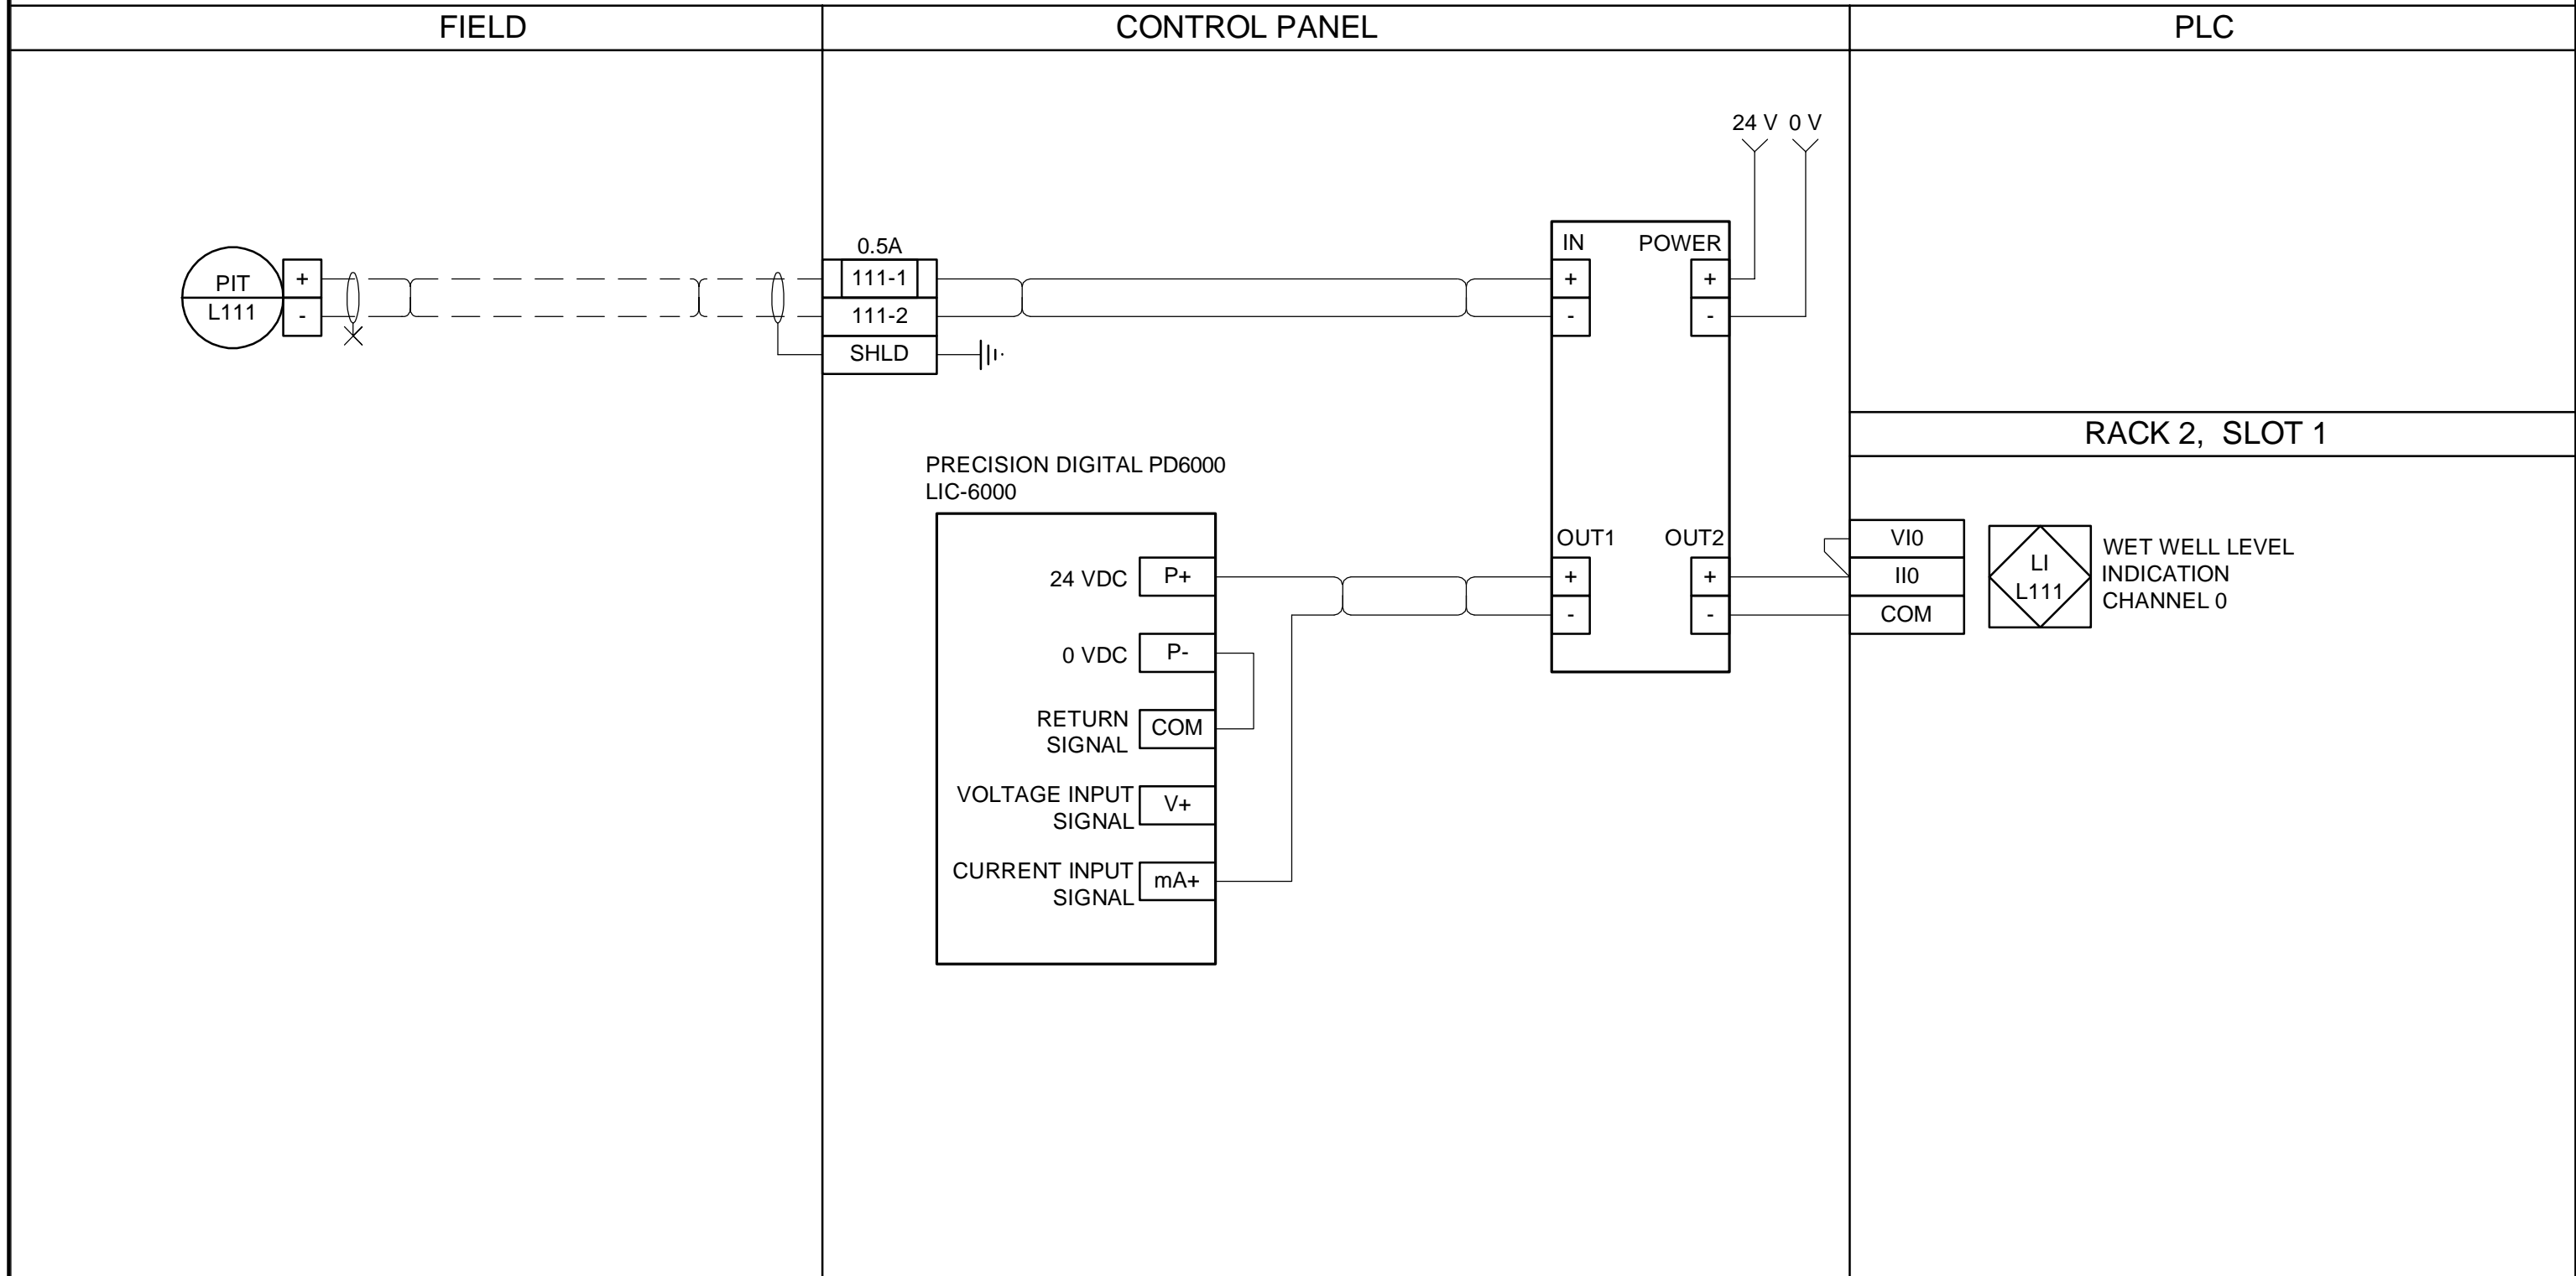

| <p>PRELIMINARY ONLY NOT FOR CONSTRUCTION</p> <p>MAPEGN Certificate of Authorization Dillon Consulting Limited (MB) No. 1789 Date: _____</p> | B.M. ELEV. CONSTRUCTION COMPLETION DATE: YYYY MM DD | DILLON CONSULTING | ENGINEER'S SEAL CONSULTANT PROJECT NUMBER <p style="font-size: large; font-weight: bold;">199259</p> | THE CITY OF WINNIPEG WATER AND WASTE DEPARTMENT ENGINEERING DIVISION | SHEET 05 of 10 CONSULTANT DRAWING NUMBER <p style="font-size: large; font-weight: bold;">L-05</p> CITY DRAWING NUMBER <p style="font-size: large; font-weight: bold;">1-0149L-E0013-001</p> | | 
|--|---|------------------------------|--|---|--|-----------|------|----|---|-----------------------|------------|--------|---|-------------|-----|------------|-----|----------|-----|-------------|-----|--------|-----|---------------------------|--|------------|--|--|--|----------|--|--|--|------|
| | <table border="1" style="width: 100%; border-collapse: collapse;"> <thead> <tr> <th>NO.</th> <th>REVISIONS</th> <th>DATE</th> <th>BY</th> </tr> </thead> <tbody> <tr> <td>0</td> <td>ISSUED FOR ADDENDUM 3</td> <td>2019-09-30</td> <td>B.L.M.</td> </tr> </tbody> </table> | | | | NO. | REVISIONS | DATE | BY | 0 | ISSUED FOR ADDENDUM 3 | 2019-09-30 | B.L.M. | <table border="1" style="width: 100%; border-collapse: collapse;"> <tr> <td>DESIGNED BY</td> <td>CAL</td> <td>CHECKED BY</td> <td>BLM</td> </tr> <tr> <td>DRAWN BY</td> <td>SCK</td> <td>APPROVED BY</td> <td>BLM</td> </tr> <tr> <td>SCALE:</td> <td>NTS</td> <td>RELEASED FOR CONSTRUCTION</td> <td></td> </tr> <tr> <td>HORIZONTAL</td> <td></td> <td></td> <td></td> </tr> <tr> <td>VERTICAL</td> <td></td> <td></td> <td></td> </tr> <tr> <td>DATE</td> <td>2019 09 30</td> <td>DATE</td> <td></td> </tr> </table> | DESIGNED BY | CAL | CHECKED BY | BLM | DRAWN BY | SCK | APPROVED BY | BLM | SCALE: | NTS | RELEASED FOR CONSTRUCTION | | HORIZONTAL | | | | VERTICAL | | | | DATE |
| NO. | REVISIONS | DATE | BY | | | | | | | | | | | | | | | | | | | | | | | | | | | | | | | |
| 0 | ISSUED FOR ADDENDUM 3 | 2019-09-30 | B.L.M. | | | | | | | | | | | | | | | | | | | | | | | | | | | | | | | |
| DESIGNED BY | CAL | CHECKED BY | BLM | | | | | | | | | | | | | | | | | | | | | | | | | | | | | | | |
| DRAWN BY | SCK | APPROVED BY | BLM | | | | | | | | | | | | | | | | | | | | | | | | | | | | | | | |
| SCALE: | NTS | RELEASED FOR CONSTRUCTION | | | | | | | | | | | | | | | | | | | | | | | | | | | | | | | | |
| HORIZONTAL | | | | | | | | | | | | | | | | | | | | | | | | | | | | | | | | | | |
| VERTICAL | | | | | | | | | | | | | | | | | | | | | | | | | | | | | | | | | | |
| DATE | 2019 09 30 | DATE | | | | | | | | | | | | | | | | | | | | | | | | | | | | | | | | |