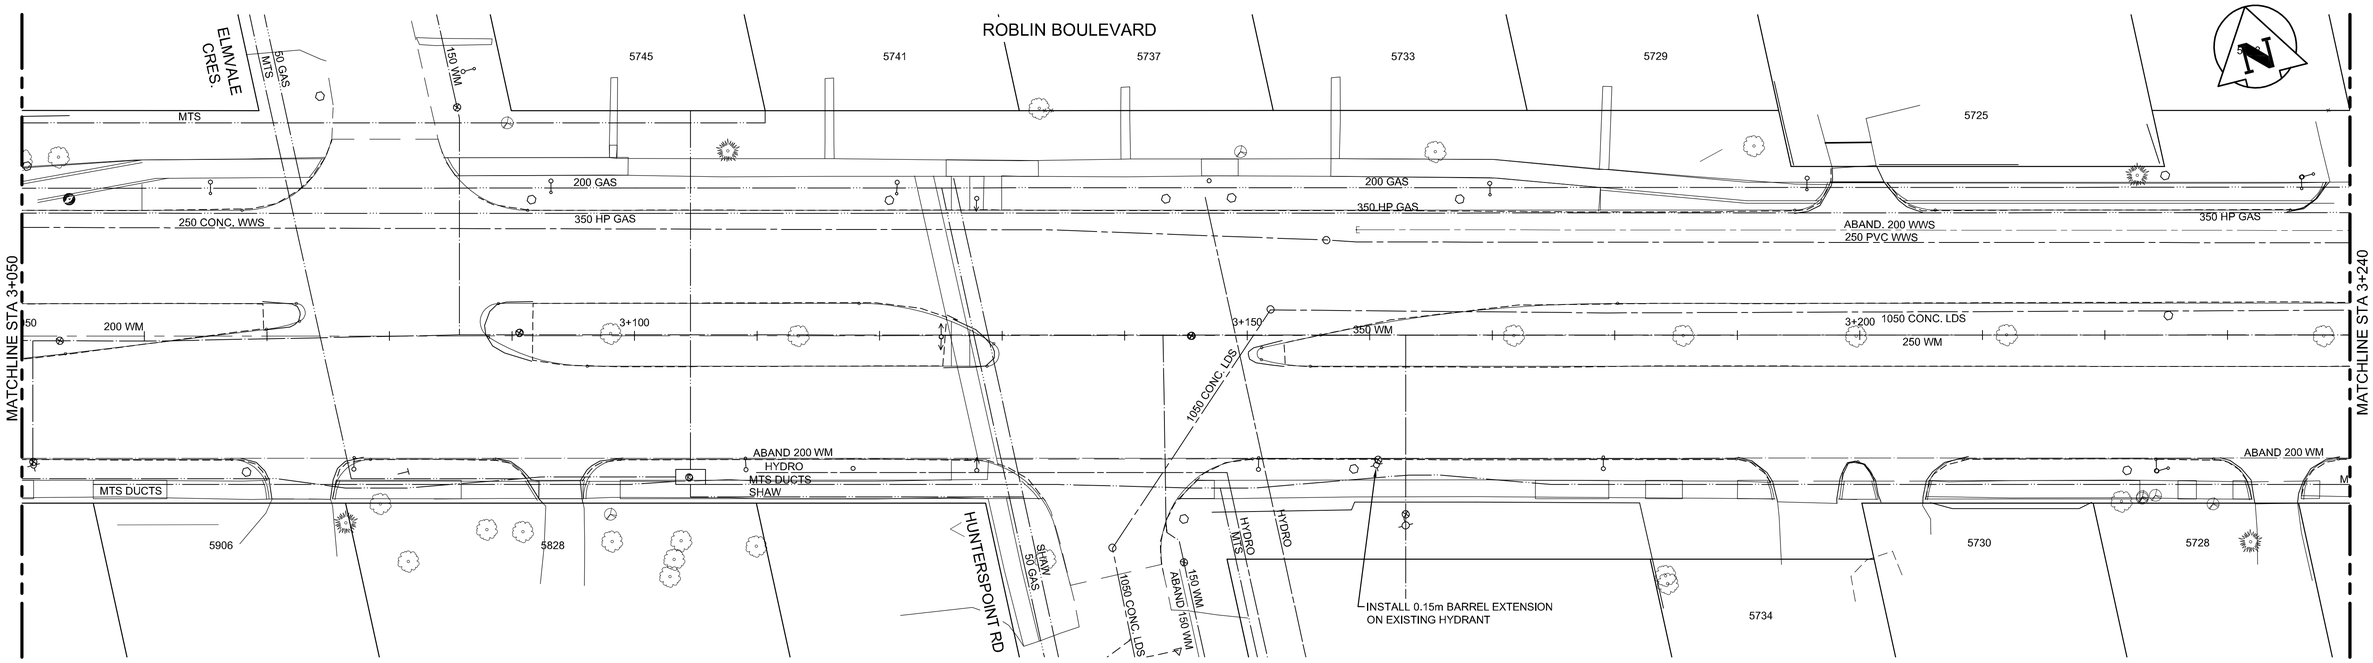

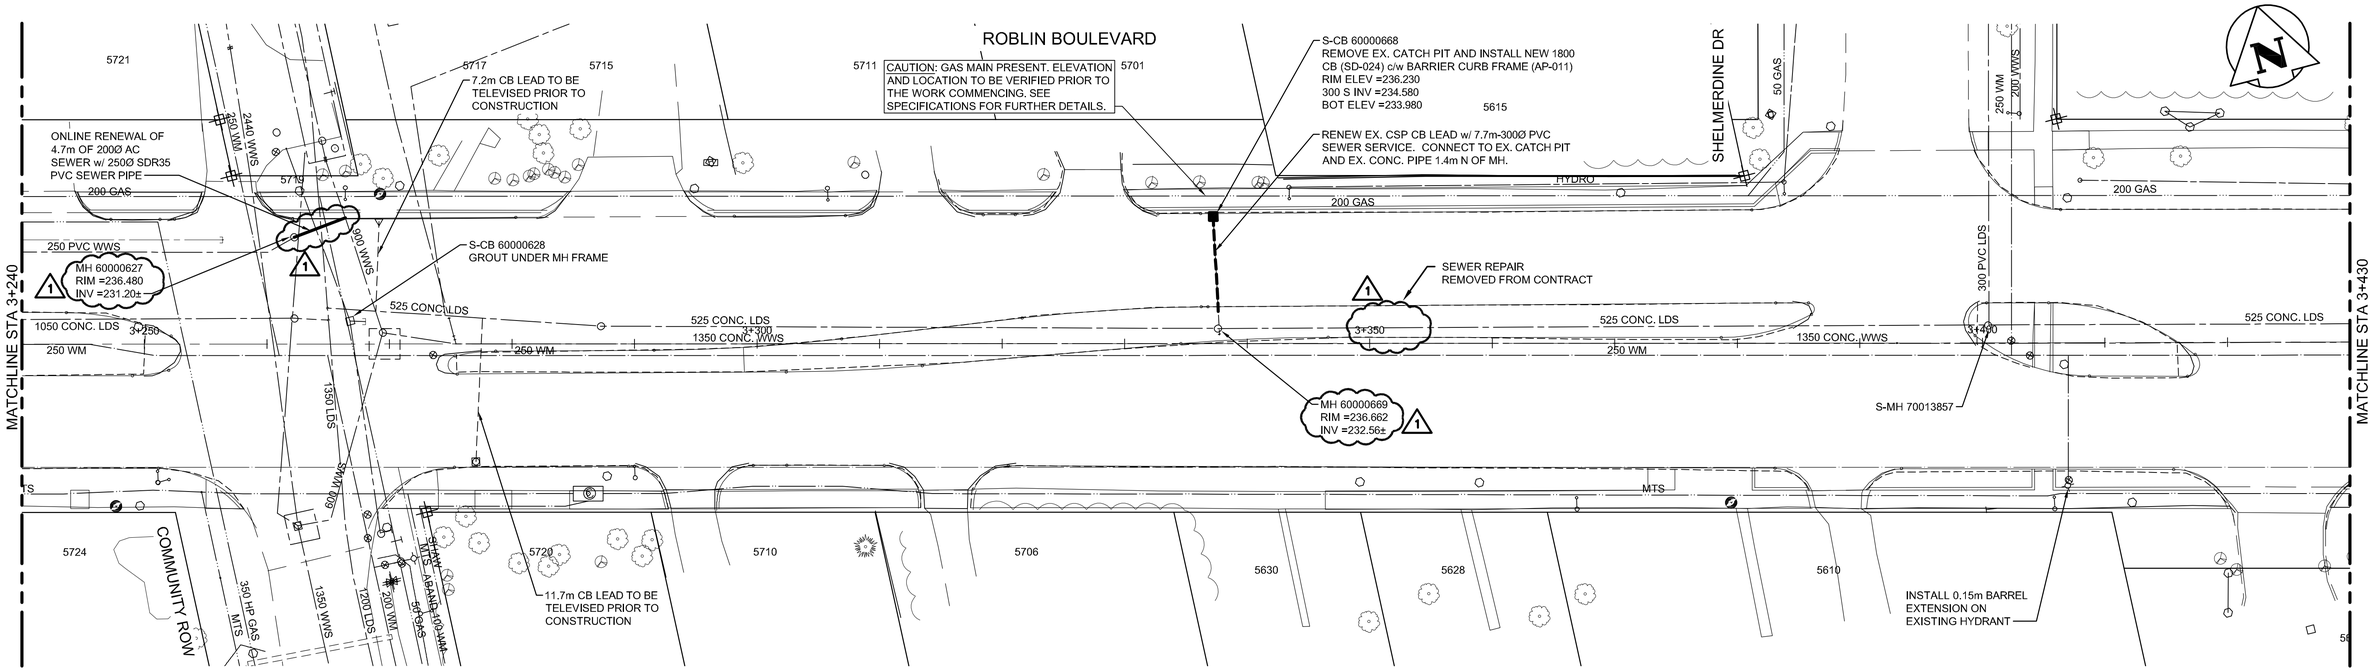

WARNING

IF POWER EQUIPMENT OR EXPLOSIVES ARE TO BE USED FOR EXCAVATION ON THIS PROJECT THE CONTRACTOR MUST:

1) NOTIFY THE GAS COMPANY OF THE PROPOSED LOCATION OF EXCAVATION.
2) TAKE PRECAUTION TO AVOID DAMAGE TO GAS COMPANY INSTALLATIONS.

SEE PROVINCIAL REGULATION 140/92 FOR DETAILS

METRIC

WHOLE NUMBERS INDICATE MILLIMETRES
DECIMALIZED NUMBERS INDICATE METRES

NOTES:

1. ADJUST ALL MANHOLE, CATCH BASIN, CATCH PIT AND GATE VALVES TO PROPOSED GRADES.
2. CONTRACTOR TO CONFIRM THE LOCATION OF ALL UTILITIES / SERVICES IN THE FIELD PRIOR TO CONSTRUCTION.
3. HYDRANT BARREL EXTENSIONS TO INCLUDE BARREL EXTENSION, STEM EXTENSIONS, STEM COUPLINGS, BREAK AWAY FLANGES OR KITS, RUBBER SEALS, FLANGE GASKETS AND FASTENERS REQUIRED TO RAISE EXISTING HYDRANT FLANGE ELEVATIONS.

EXISTING	LEGEND-PLAN	PROPOSED	EXISTING	LEGEND-PLAN	PROPOSED	EXISTING	LEGEND-PROFILE	PROPOSED
150 WM	WATERMAIN	150 WM		M.T.S.			℄ PROFILE	
⊹	HYDRANT	✦		GLAS GRID			NORTH OR WEST GUTTER	
⊗	VALVE	⊗		CONCRETE			SOUTH OR EAST GUTTER	
300 LDS	LAND DRAINAGE SEWER	300 LDS		ASPHALT			NORTH MEDIAN GUTTER	
250 WWS	WASTE WATER SEWER	250 WWS		SIDEWALK			SOUTH MEDIAN GUTTER	
○	MANHOLE	●		ASPHALT MILL & FILL			NORTH OR WEST P℄	
□	CATCH BASIN	■	⊶	STREET LIGHT	⊷		SOUTH OR EAST P℄	
HYDRO	HYDRO	HYDRO	○	HYDRO POLE	•			
GAS	GAS	GAS	⊹	SURVEY BAR	✦			
	TRANSIT STOP		(31.334)	ELEVATION	32.231			
	PROPERTY LINE			SIDEWALK RAMP				

LOCATION APPROVED
UNDERGROUND STRUCTURES

SUPV. U/G STRUCTURES COMMITTEE — DATE

NOTE:
LOCATION OF UNDERGROUND STRUCTURES AS SHOWN ARE BASED ON THE BEST INFORMATION AVAILABLE BUT NO GUARANTEE IS GIVEN THAT ALL EXISTING UTILITIES ARE SHOWN OR THAT THE GIVEN LOCATIONS ARE EXACT. CONFIRMATION OF EXISTENCE AND EXACT LOCATION OF ALL SERVICES MUST BE OBTAINED FROM THE INDIVIDUAL UTILITIES BEFORE PROCEEDING WITH CONSTRUCTION.

B.M.
ELEV.

NO.	REVISIONS	DATE	BY
1	ISSUED FOR ADDENDUM NO.1	20.04.09	R.K.H.
0	ISSUED FOR TENDER	20.04.03	R.K.H.

Stantec
500 - 311 Portage Avenue, Winnipeg MB Canada
www.stantec.com

DESIGNED BY	R.S.	CHECKED BY	R.S.
DRAWN BY	O.S.	APPROVED BY	R.S.
HOR. SCALE: 1:250 VERTICAL:		RELEASED FOR CONSTRUCTION:	
DATE	2020/02/10	DATE	

ENGINEER'S SEAL

PRELIMINARY DRAWING
NOT TO BE USED FOR CONSTRUCTION

CONSULTANT DRAWING N0.
U206

ENGINEERS GEOSCIENTISTS MANITOBA
Certificate of Authorization
Stantec Consulting Ltd.
No. 1301

Winnipeg

THE CITY OF WINNIPEG
PUBLIC WORKS DEPARTMENT
ENGINEERING DIVISION

ROBLIN BOULEVARD PAVEMENT RENEWAL
ROBLIN BOULEVARD
STA 3+050 TO STA 3+430
MUNICIPAL UTILITIES

SHEET	OF
38	50

CAD FILE DRAWING NUMBER
08080u-204.dwg

CITY DRAWING NUMBER
P-3528-38

\\Cd0945-pcfs01\workgroup\N137\cdrive\137080800\0300_drawing\0302_sheet_files\02_civil\08080u-204.dwg
2020/04/09 11:25 AM By: Schorr, Cornelius

XX / XXX