



NOTE: CHAINAGES SHOWN ARE ALONG ϕ OF PROPOSED LDS

WEATHERDON AVENUE

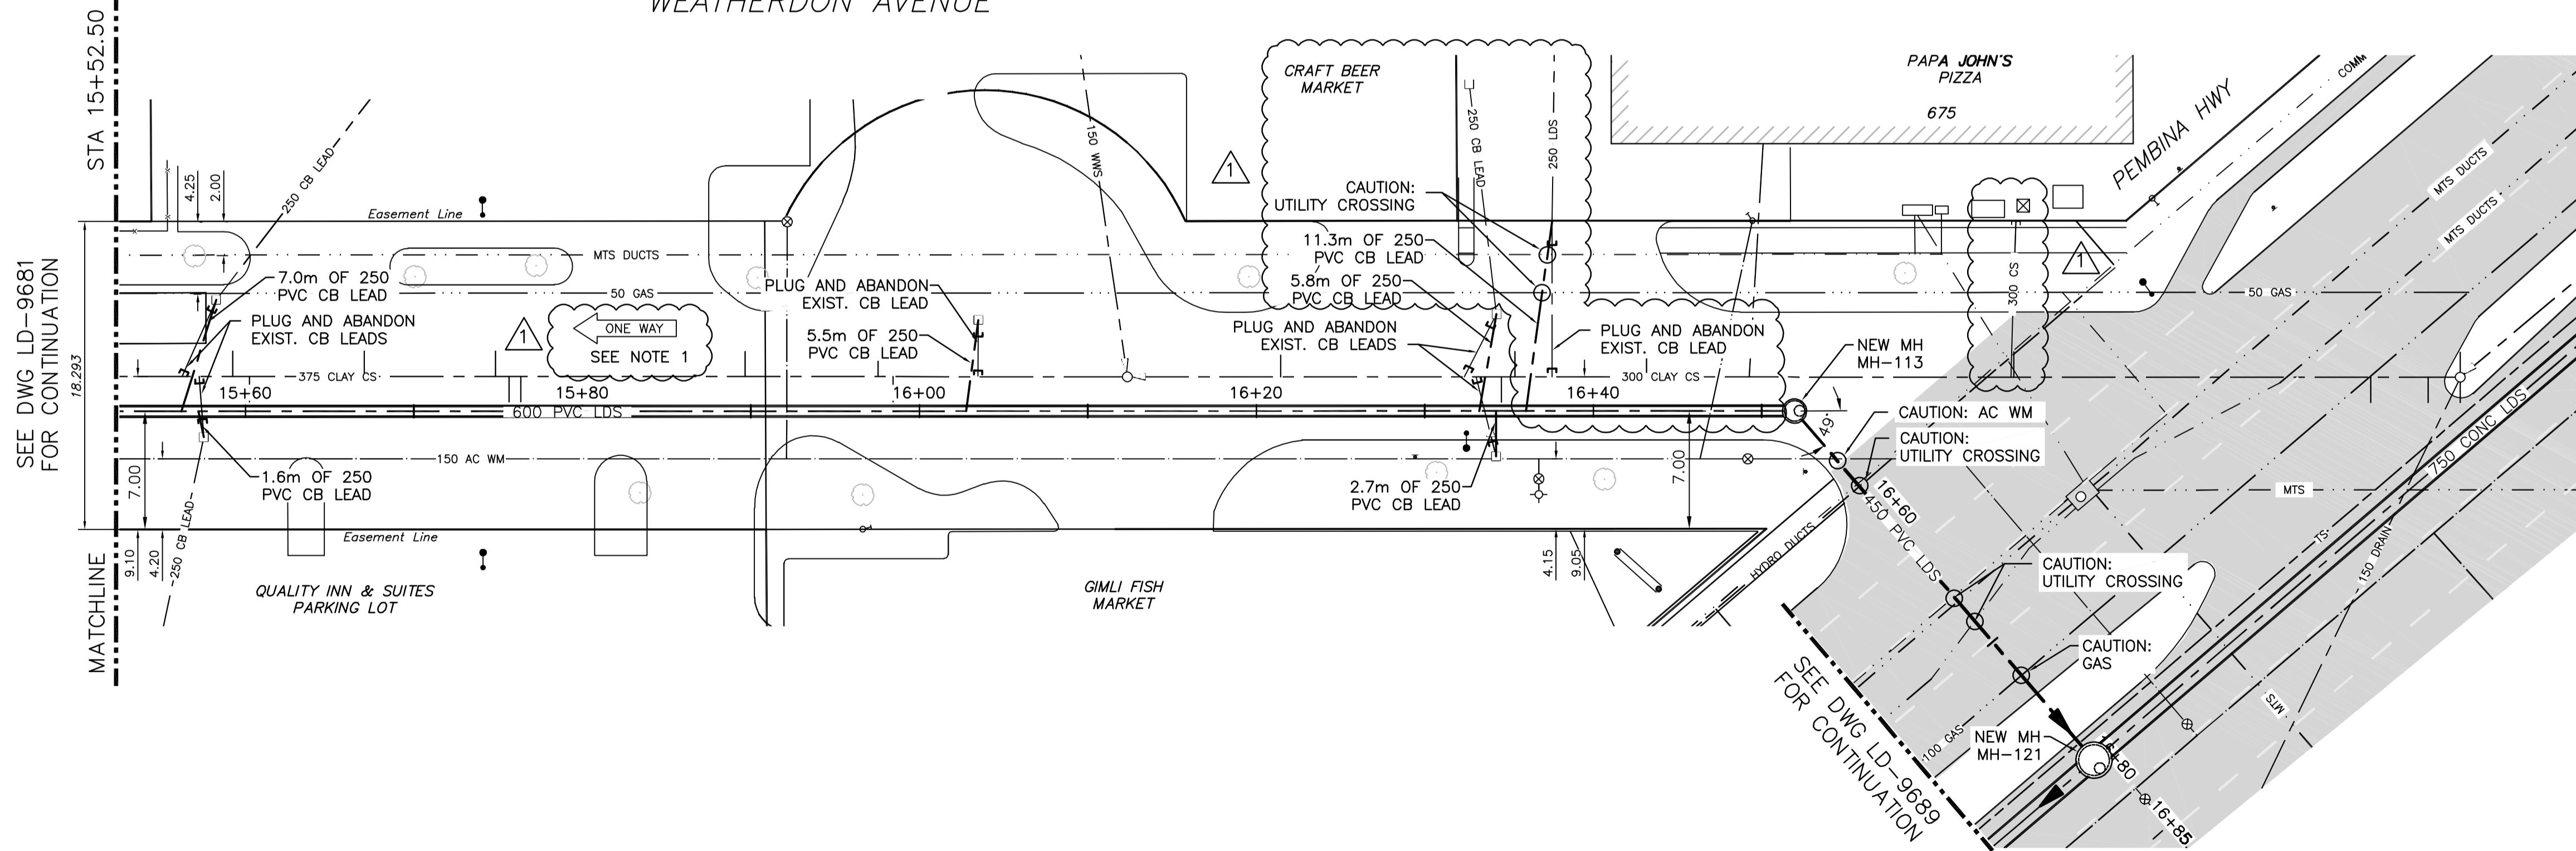


NOTES:

- COORDINATE WITH CONTRACT ADMINISTRATOR TO ARRANGE FOR TEMPORARY ONE WAY TRAFFIC ON WEATHERDON AVENUE.
- WORK WITHIN NON-ROAD EASEMENT TO BE COORDINATED WITH CONTRACT ADMINISTRATOR PRIOR TO WORK BEGINNING.

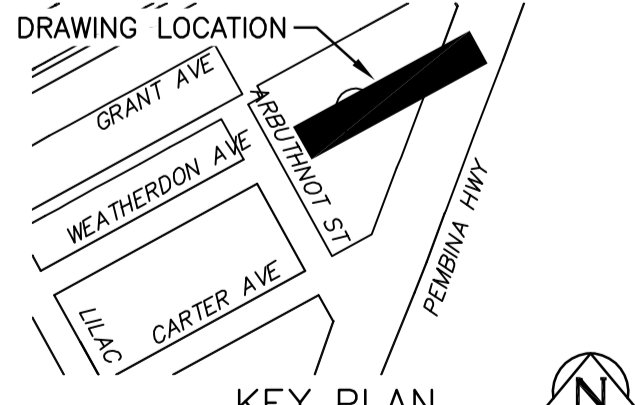

ENGINEERS GEOSCIENTISTS MANITOBA
 Certificate of Authorization
 CH2M HILL Canada Ltd.
 No. 1441

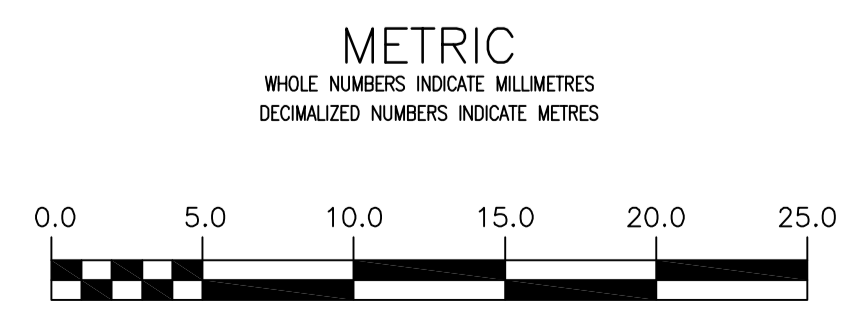

PROPERTY LIMITS DELINEATION
 DELINEATION OF PROPERTY LIMITS AS SHOWN ON THIS DRAWING DOES NOT REPRESENT A "LEGAL SURVEY". JACOBS AND KGS GROUP MAKE NO REPRESENTATION OR WARRANTY AS TO THE ACCURACY OF PROPERTY LIMITS DELINEATED ON THIS DRAWING, NOR ON THE DIMENSIONAL ACCURACY OF DRAWING FEATURES RELATIVE TO THOSE PROPERTY LIMITS.

WARNING
 IF POWER EQUIPMENT OR EXPLOSIVES ARE TO BE USED FOR EXCAVATION ON THIS PROJECT THE CONTRACTOR MUST:
 1) NOTIFY THE GAS COMPANY OF THE PROPOSED LOCATION OF EXCAVATION.
 2) TAKE PRECAUTION TO AVOID DAMAGE TO GAS COMPANY INSTALLATIONS.
 SEE PROVINCIAL REGULATION 210/72 FOR DETAILS

LOCATION APPROVED UNDERGROUND STRUCTURES
 SUPV. U/G STRUCTURES COMMITTEE DATE
 NOTE:
 LOCATION OF UNDERGROUND STRUCTURES AS SHOWN ARE BASED ON THE BEST INFORMATION AVAILABLE BUT NO GUARANTEE IS GIVEN THAT ALL EXISTING UTILITIES ARE SHOWN OR THAT THE GIVEN LOCATIONS ARE EXACT. CONFIRMATION OF EXISTENCE AND EXACT LOCATION OF ALL SERVICES MUST BE OBTAINED FROM THE INDIVIDUAL UTILITIES BEFORE PROCEEDING WITH CONSTRUCTION.

NO.	REVISIONS	DATE	BY	DATE
1	ISSUED FOR ADDENDUM NO. 1	21/04/28	JBC	
0	ISSUED FOR TENDER	21/03/26	JBC	

JACOBS KGS GROUP

DESIGNED BY: SDG	CHECKED BY: MD
DRAWN BY: JBC	APPROVED BY:
HOR. SCALE: 1:250	RELEASED FOR CONSTRUCTION: DATE
VERTICAL: 1:50	

ENGINEER'S SEAL
 ORIGINAL SIGNED BY S.D. GODON ON 21/04/07
 CONSULTANT DRAWING NO. C-2009

THE CITY OF WINNIPEG WATER AND WASTE DEPARTMENT

PROJECT TITLE
COCKBURN AND CALROSSIE COMBINED SEWER RELIEF WORKS - CONTRACT 6B

WEATHERDON AVENUE
 ARBUTHNOT STREET TO
 PEMBINA HIGHWAY

SHEET 10 OF 20
COMPUTER FILE NAME C-2009.dwg
CITY DRAWING NUMBER LD-9682