


CEILING DEMOLITION PLAN

R1	APRIL26, 2021	AS NOTED ON DRAWING	MG
1	DEC 2020	REDUCTION FOR BUDGET	MG

NO.	DATE	DESCRIPTION	BY

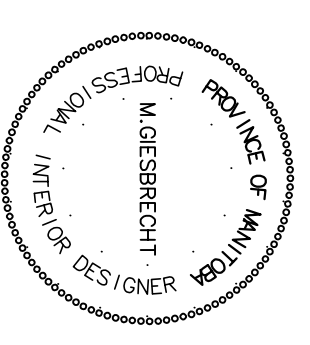

DRAWN BY  
PRINTING DATE

DRAWINGS & SPECIFICATIONS AS INSTRUMENTS OF SERVICES ARE THE PROPERTY OF SYNERGY INTERIOR DESIGN INC. THE CONTRACTOR SHALL BE RESPONSIBLE FOR OBTAINING ALL NECESSARY PERMITS AND APPROVALS. ALL PRINTS TO BE RETURNED. THE CONTRACTOR IS TO VERIFY DIMENSIONS & DATA NOTED HEREIN WITH CONDITIONS THE SITE & IS HELD RESPONSIBLE FOR REPORTING ANY DISCREPANCY TO THE DESIGNER FOR ADJUSTMENT.

**SYNERGY INTERIOR DESIGN INC**

13 Rosewarne, Avenue WINNIPEG, MB Canada R2M 0V8  
 204 233 9159  
 molvin@synergyinteriors.com  
 www.synergyinteriors.com  
 DATE MARCH 2020 SCALE 1/4"=1'-0" REVISIONS  
 DRAWN BY M.G. CHECKED BY M.G.

**MUNROE BRANCH LIBRARY  
 489 LONDON STREET, WINNIPEG**