


SITE CONTEXT PLAN



NET CLIMBER TO BE REMOVED

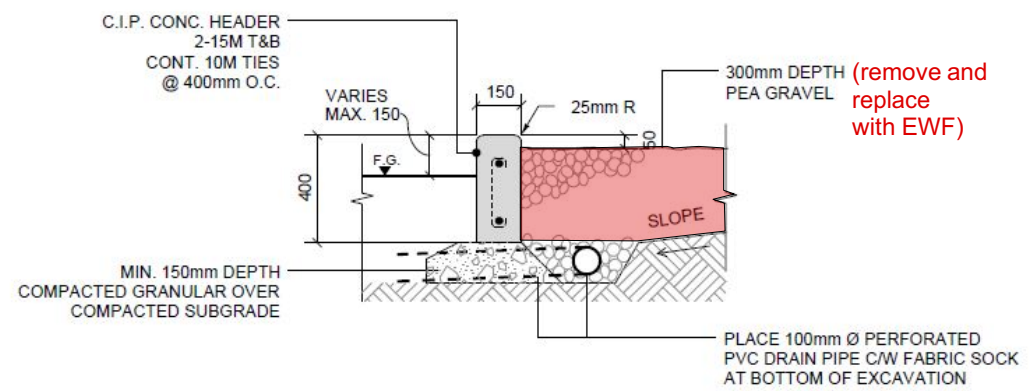

DETAIL: SAFETY SURFACING TO BE REMOVED

CONTRACTOR TO CONFIRM ALL DIMENSIONS AND REPORT ANY DISCREPANCIES TO CONTRACT ADMINISTRATOR PRIOR TO CONSTRUCTION. LOCATION OF UNDERGROUND STRUCTURES AS SHOWN ARE BASED ON THE BEST INFORMATION AVAILABLE BUT NO GUARANTEE IS GIVEN THAT ALL EXISTING UTILITIES ARE SHOWN OR THAT THE GIVEN LOCATIONS ARE EXACT. CONFIRMATION OF EXISTENCE AND EXACT LOCATION OF ALL SERVICES MUST BE OBTAINED FROM THE INDIVIDUAL UTILITIES BEFORE PROCEEDING WITH CONSTRUCTION.

DESIGNED BY	IL	CHECKED BY	
DRAWN BY	IL	APPROVED BY	
HORIZ. SCALE	NTS		
VERT. SCALE	NTS		
DATE	JUNE 2020		
MANAGER, PARK AND OPEN SPACES		DATE	
MANAGER, URBAN DESIGN DIVISION		DATE	
DRAWING TITLE			
Vimy Ridge Memorial Park Play Equipment			
Existing Conditions & Removals			
SITE ADDRESS		DRAWING NO.	
821 Preston Avenue		V.8-1	
		BID OPPORTUNITY NO.	
		423-2020	