NOT IN CONTRACT
SEE SPECIFICATION

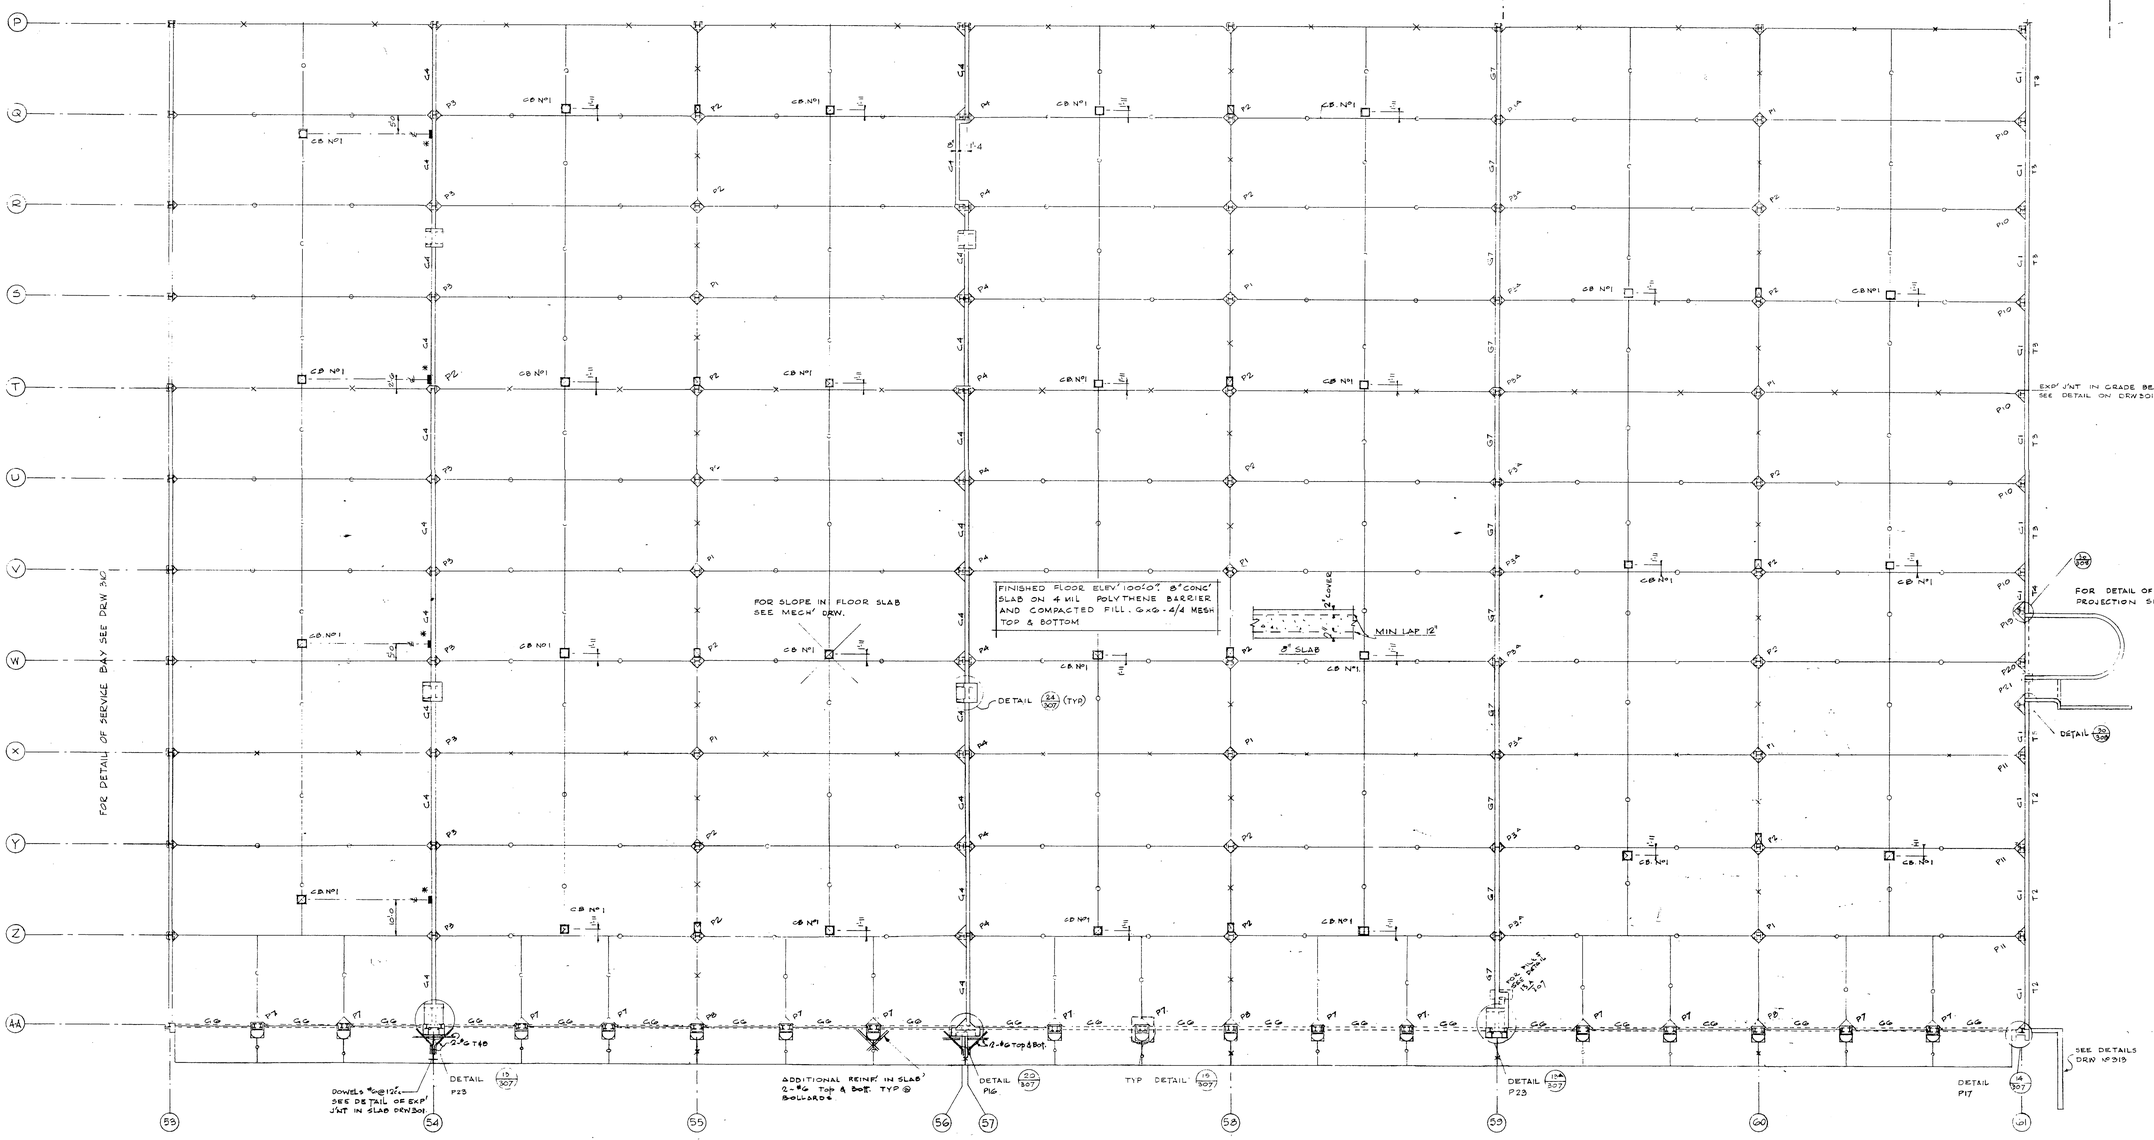

FOOTINGS ON LINES G0 & G1 NOT TO BE INCLUDED IN THIS CONTRACT.

PIER AND PILE-CAP SCHEDULE :— FOR SPECIAL PILE-CAP DETAILS SEE DRG 305

MARK	50 & 57 HJKM NPRQSUVW XYZ	58 N.S.V GON.Q.T	68 FGDK GODEHK.B	55L 58L	58 LMNPRRS TUVW 54W.	58 EHJ 60 FGJ 55J	58L 56 T 57L 57T	55X	G1BCXYZ	G1NPQRST UV.M.	G1DEFGHJK	A-A 55A,55b, 56a 56b 55a 55b 57a,57b 58a 58b 55a 55b 60a G69 A-60a 55b 60a G0b G-57a 57b 59a 59b Q 54a,b,P 55a2b, L55a1b	54 M.N.P&S.U 54 V.R. 55 XYZ	54 XYZ	G0 XZ 58 X 55 NVS	55K	55 MPQRTU W 54T 58 YZ 60Y	55 YZ	58 MP QRUW GOMPRSVLUW	58T	G1W	A&55,58,60 A&0,G58,G55	58 DEFGHJK	55 B 57 DE,F, 54 H.J.K. G1Wa.	54 AA, 54Q, 54L 56AA, 56G 57AA, 57G 59AA, 59A,35C G1AA, G1A. G1Va, G1AA.	G0C.
'A' x 'B' PIER	2'-1 x 1'-2 6-#5 Verts Ties 3/#4@ 12"c/c	1'-5 x 1'-6 4-#5 Vert Ties #3@12"c/c	1'-4 x 1'-6 4-#5 Vert Ties #3@12"c/c	1'-5 x 1'-6 4-#5 Vert Ties #3@12"c/c	1'-5 x 1'-6 4-#5 Vert Ties #3@12"c/c	1'-2 x 1'-4 4-#5 Vert Ties #3 Vert	2'-1 x 1'-2 6-#5 Vert Ties 3/#3 @ 12"c/c	1'-2 x 1'-3 4-#5 Vert Ties #3@12"c/c	1'-2 x 2'-3½ 4-#5 Vert Ties #3@12"c/c	1'-3 x 1'-11½ 1'-5½ x 2'-0 HELIC 4-#5 Vert Ties #3@12"c/c	1'-2 x 2'-3½ 4-#6 Vert Ties #3@12"c/c	SEE DETAIL	1'-4 x 1'-7 4-#5 Verts Ties #3@12"c/c	1'-2 x 1'-3 4-#5 Vert Ties #3 @12"c/c	1'-4 x 1'-7 4-#5 Vert Ties #3@12"c/c	1'-4 x 1'-5 4-#5 Vert Ties #3@ c/c	1'-2¾ x 1'-5 4-#5 Vert Ties #3@12"c/c	1'-1¾ x 1'-1 4-#5 Vert Ties #3@12"c/c	1'-2¾ x 1'-6 4-#5 Vert Ties #3@12"c/c	1'-2¾ x 1'-3 4-#5 Vert Ties #3@12"c/c	1'-3 x 1'-11½ 4-#5 Vert Ties #3@12"c/c	SEE DETAIL	1'-4 x 1'-6 4-#5 Vert Ties #3@12"c/c	1'-3 x 1'-9½ 4-#5 Vert Ties #3@12"c/c	SEE DETAILS DRW 309 G1AB - DRW 315.	1'-2 x 1'-6 4-#3 Vert Ties #3@12"c/c
PILE-CAP	P4	P1	P1	P1	P3	P6	P4	P1	P11	P10 P25 FOR G1M. ONLY	P9	P7	P3	P3	P1	P1	P2	P2	P2	P2	P20	P8	P12	P24 G1Wa. DRW 314	SEE DRW 304	P6.

NOTES:-
G1~ TYPES OF GRADE BEAMS SEE DRW 308.
T1~ TYPES OF TILT-UP PANELS SEE DRW 308.
P1~ TYPES OF PILE-CAP SEE DRW. 305 & 306.

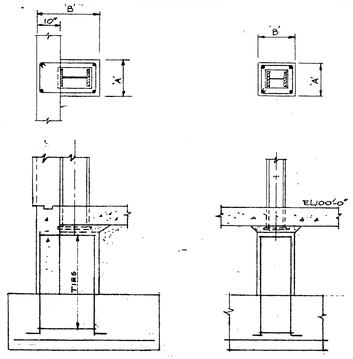

TYPICAL DETAILS OF PIERS

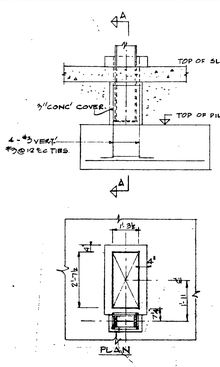

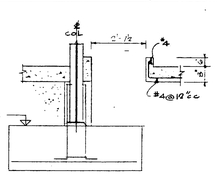

DETAIL OF OPENINGS REQ'D FOR
COL'S:- 55 J,M,Q,T,W,Z
58 E,M,Q,T,W,Z
60 C,G,H,S,U,Y

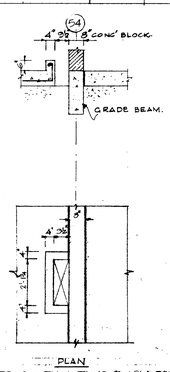

NOTED ON PLAN THUS * — 4 REQ'D ON LINE 54 ONLY

DETAIL OF OPENING IN FLOOR SLAB

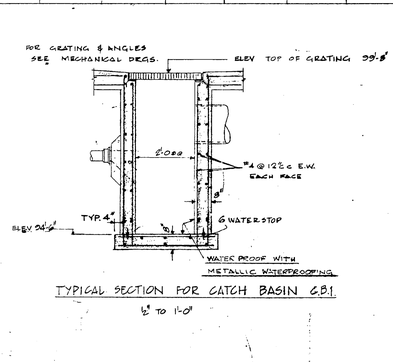

TYPICAL SECTION FOR CATCH BASIN C.B.1.

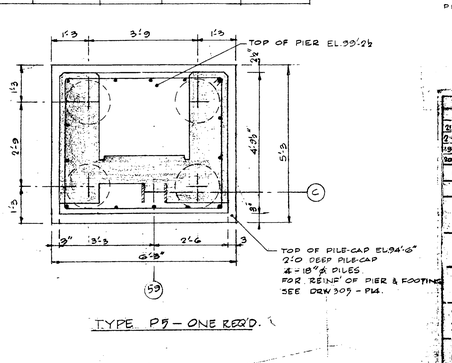


LICENSED TO PRACTICE IN THE PROVINCE OF MANITOBA
My Licence Expires 10 Jan. 1968
2185-302

K. McINTAIN

DATE	ISSUE NO.	REV. NO.	DESCRIPTION	DRAWN BY
20.11.69			AS BUILT. DEC 11 1969	R.L.T.
21.8.68	3		FOR CONSTRUCTION	R.L.
19.JAN.68	2		FOR TENDER	
20 OCT 67	1		FOR APPROVAL	

ISSUE OR REVISION

METROPOLITAN CORPORATION OF GREATER WINNIPEG
STREETS AND TRANSIT DIVISION

TRANSIT STORAGE AND SHOP FACILITIES

GARAGE

FOUNDATION PLAN II

CONSULTING PROFESSIONAL ENGINEERS
A. D. MARGISON AND ASSOCIATES LIMITED
1088 LESLIE STREET, DON MILLS, ONTARIO

ARCHITECTS
Waisman Ross • Blankstein Coop Gilmor Hanna
10 DONALD STREET, WINNIPEG, MANITOBA

APPROVED
DEPUTY DIRECTOR OF STREETS AND TRANSIT

DRAWN BY R.S.H. | DATE Aug 67
CHECKED | SCALE 1/8" To 1'-0
FILE No. | DRAWING No. 2185-302
SHEET No. | STRUCTURAL