APPENDIX A

ASBESTOS INVENTORY

ASBESTOS INVENTORY CONTROL



Building Name:	Margaret Grant Indoor Pool & Bldg	Inspection Date:	August 10, 2020
Building Code:	PI-04	Inspected By:	Ryan Matthews
Building Address:	685 Dalhousie Drive	Construction Date:	1971

		Drawing	Material	Testing	Lab	Date	Test	Est.
Material Location	Material Description	Label	Condition	Status	Report #	M/Y	%	%
Main Floor								
Observation Area	Pipe Insulation - Above Ceiling	PI	Removed '13	TESTED	88623	Jul/'10	5	
Women's Washroom and Change Room	Pipe Fitting Insulation - above ceiling	PF	Removed'13					
	Pipe Insulation - above ceiling	PI	Removed '13					5
	Plaster - Ceiling	PL		TESTED			0	
Men's Washroom and Change Room	Pipe Fitting Insulation - above ceiling	PF	Good	TESTED			0	
	Pipe Insulation - above ceiling	PI	Removed '13					5
	Plaster - Ceiling	PL		TESTED	83820	Mar/'10	0	
Men's Locker Area	Pipe Fitting Insulation	PF	Removed'13					
Mechanical - Boiler Room	Pipe Fitting Insulation	PF	Good	TESTED	92886	Nov/'10	80	
	Tank Insulation (Tank left in place - check interior for asbetos)	TI	Removed'16	TESTED			40- 50	
	Duct Insulation	DI	Good	TESTED		Jan/'16	0	
	Breeching Insulation	BI	Removed'16	TESTED			82	
	Duct Insulation	DI	Good	TESTED			0	
	Duct wrap insulation tar paper	DI	Good	TESTED			0	
	Gasket (Black)	GA	Good	TESTED	189474	Aug/'17	0	
Generator Room	Pipe Fitting Insulation	PF	Good					
Lifeguard Room	Drywall Compound - Ceiling	DC	Good	TESTED	208484	Sep/'18	0	
Maintenance Office and Workshop Area (Storage 'A')	Pipe Fitting Insulation	PF	Good	TESTED		Dec/'11	0	
	Pipe Fitting Insulation (2 Samples Tatken)	PF	Good	TESTED	136885	Feb/'14	0	
	Pipe Fitting Insulation	PF	Good	TESTED		Jan'14	0	
	Lead Paint (Beige)	LP		TESTED	EC65229	May'13	.1	
Storage 'B'	Pipe Fitting Insulation	PF	Good	TESTED	136885	Feb/'14	0	

		Drawing	Material	Testing	Lab	Date	Test	Est.
Material Location	Material Description	Label	Condition	Status	Report #	M/Y	%	%
Pool Deck Area	Ceiling Tile		Removed					
	Duct Insulation	DI		TESTED		Jan'14	0	
	Spray On Insulation -Upper Wall Cover	SO		TESTED			0	
North Side Pool Deck	Transite Pipe - Roof Drain	TP	Good					
	Pipe Fitting Insulation	PF	Removed'14					
Pool Deck Storage Room 1 & 2 (Storage Rm 'B')	Pipe Fitting Insulation (2 SamplesTaken)	PF	Good	TESTED	136216	Jan'14	0	
Basement								
West Side of Pool Tunnel	Pipe Fitting Insulation	PF	Good	TESTED	127815	Jun'13	0	
	Black Pipe Wrap	MA		TESTED		May'13	0	
	Mastic - Duct	MA	Removed	TESTED	126459	May'13	10	
South Side of Pool Tunnel	Black Pipe Wrap	MA	Good	TESTED	208484	Sep/'18	10	
	Mastic - Pipe	MA	Good	TESTED	208484	Sep/'18	3	
All Ducts Around Pool Tunnel	Mastic - Duct	MA	Removed'17	TESTED	179807	Dec'16	5	
	Mastic - Duct	MA	Removed'17	TESTED	192920	Oct/'17	10	
	Mastic - Duct (Brown - Brush-on)	MA	Good	TESTED	192920	Oct/'17	3	
Crawl Space	Transite Pipe - Sewer	TP	Good					
	Pipe Fitting Insulation	PF	Good	TESTED	127815	Jun'13	0	
	Pipe Insulation	PI	Good	TESTED	127815	Jun'13	0	

NOTES:

- 1. Asbestos inspections and inventory updates are conducted annually.
- 2. There may be asbestos containing materials present that were not located during asbestos inspections.
- 3. Floor tile and sheet flooring installed before 1990 may contain asbestos and must be treated as an asbestos containing material.
- 4. Vermiculite insulation may contain pockets of asbestos. All vermiculite insulation must be treated as an asbestos containing material.
- 5. For asbestos related inquiries, call Central Control at 986-2382

PI-04





GENERAL LABELS

??

ABOVE CEILING

UNDER FLOORING

WALL DETAIL

1. THERE MAY BE ASBESTOS CONTAINING MATERIALS PRESENT THAT WERE NOT LOCATED DURING BUILDING INSPECTIONS

??=

AF:ASBESTOS FABRIC **BI : BREECHING INSULATION BR:CAULKING**

C12: 12X12 CEILING TILE C24: 24X24 CEILING TILE C48: 24X48 CEILING TILE DC:DRYWALL COMPOUND DI:DUCT INSULATION **FS:SHEET FLOORING**

F9: 9X9 FLOOR TILE F12: 12X12 FLOOR TILE HB:HARDBOARD MA:MASTIC PF:PIPE FITTING INSULATION VE:VERMICULITE PI:PIPE INSULATION PL:PLASTER RD:ROOF DRAIN **SC:STIPPLE CEILING**

SO:SPRAY ON ST:STUCCO **TI:TANK INSULATION** TP:TRANSITE PIPE

ASBESTOS LOCATIONS

2. REFER TO THE ASBESTOS INVENTORY SURVEY SHEET FOR MORE INFORMATION

3. DO NOT DISTURB ASBESTOS. FOR HANDLING PROCEDURES CALL CENTRAL CONTROL AT 986-2382


BUILDING: PI-04 **Margaret Grant Pool** 685 Dalhousle Dr

Winnipeg, Manitoba REVISED BY: SHEET #: DATE: SCALE: REM December 23, 2016 N.T.S.



DEPARTMENT MUNICIPAL ACCOMMODATIONS DIVISION 4th FLOOR - 185 KING STREET WINNIPEG, MANITOBA R3B 1J1

PHONE: (204) 986-7266 FAX: (204) 986-7311

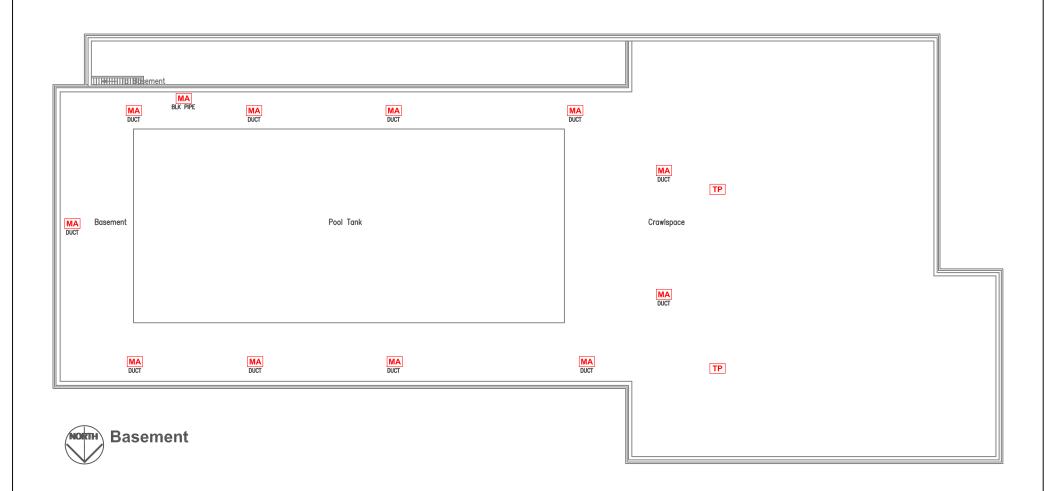



GENERAL LABELS

ABOVE CEILING

UNDER FLOORING

WALL DETAIL

??

??

NOTES:

1. THERE MAY BE ASBESTOS CONTAINING MATERIALS PRESENT THAT WERE NOT LOCATED DURING BUILDING INSPECTIONS 2. REFER TO THE ASBESTOS INVENTORY SURVEY SHEET FOR MORE INFORMATION

3. DO NOT DISTURB ASBESTOS. FOR HANDLING PROCEDURES CALL CENTRAL CONTROL AT 986-2382

??=

AF:ASBESTOS FABRIC BI :BREECHING INSULATION **BR:CAULKING** C12: 12X12 CEILING TILE

C24: 24X24 CEILING TILE C48: 24X48 CEILING TILE DC:DRYWALL COMPOUND DI:DUCT INSULATION **FS:SHEET FLOORING**

F9: 9X9 FLOOR TILE F12: 12X12 FLOOR TILE HB:HARDBOARD MA:MASTIC PF:PIPE FITTING INSULATION VE:VERMICULITE PI:PIPE INSULATION PL:PLASTER RD:ROOF DRAIN **SC:STIPPLE CEILING**

SO:SPRAY ON ST:STUCCO **TI:TANK INSULATION** TP:TRANSITE PIPE

ASBESTOS LOCATIONS

BUILDING:

PI-04 **Margaret Grant Pool** 685 Dalhousie Dr Winnipeg, Manitoba

REVISED BY: DATE: SCALE: SHEET #: REM N.T.S. 2/2 September 24, 2018



CITY OF WINNIPEG

PLANNING, PROPERTY & DEVELOPMENT DEPARTMENT MUNICIPAL ACCOMMODATIONS DIVISION 4th FLOOR - 185 KING STREET

WINNIPEG, MANITOBA R3B 1J1 PHONE: (204) 986-7266

FAX: (204) 986-7311